



AIA®

## Document G731™ – 2019

**Change Order, Construction Manager as Adviser Edition****PROJECT:** *(name and address)*

Christian County High School

5185 Fort Campbell Blvd Hopkinsville,  
KY 42240**OWNER:** *(name and address)*Christian County Board of Education  
200 Glass Avenue  
Hopkinsville, KY 42240**CONTRACTOR:** *(name and address)*State Electric Co., Inc.  
140 College Street  
Crofton, KY 42217**CONTRACT INFORMATION:**

Contract For: BP 260-03

Electrical

Date: September 08, 2023

**ARCHITECT:** *(name and address)*Hafer PSC  
21 Southeast Third St, Ste 800  
Evansville, IN 47708**CHANGE ORDER INFORMATION:**

Change Order Number: 009

Date: February 9, 2024

**CONSTRUCTION MANAGER:** *(name and address)*Alliance Corporation  
116 E. College Street  
Glasgow, KY 42141**THE CONTRACT IS CHANGED AS FOLLOWS:***(Insert a detailed description of the change and, if applicable, attach or reference specific exhibits. Also include agreed upon adjustments attributable to executed Construction Change Directives.)*

Access to control infrastructure, fire alarm, and electrical revisions per PR# 1.

The original Contract Sum was	\$ 11,715,191.00
Net change by previously authorized Change Orders	\$ 10,357.14
The Contract Sum prior to this Change Order was	\$ 11,725,548.14
The Contract Sum will be increased by this Change Order in the amount of	\$ 15,594.18
The new Contract Sum including this Change Order will be	\$ 11,741,142.32

The Contract Time will be unchanged by Zero (0) days.

The Contractor's Work shall be substantially complete on

**NOTE:** This Change Order does not include adjustments to the Contract Sum or Guaranteed Maximum Price, or the Contract Time, that have been authorized by Construction Change Directive until the cost and time have been agreed upon by both the Owner and Contractor, in which case a Change Order is executed to supersede the Construction Change Directive.

**NOT VALID UNTIL SIGNED BY THE ARCHITECT, CONSTRUCTION MANAGER, CONTRACTOR, AND OWNER.**

Hafer PSC

**ARCHITECT** *(Firm name)***SIGNATURE**

Eric Rang, AIA, Senior Associate

**PRINTED NAME AND TITLE****DATE:**

State Electric Co., Inc.

**CONTRACTOR** *(Firm name)***SIGNATURE**

Matt Crick

**PRINTED NAME AND TITLE****DATE:**

Alliance Corporation

**CONSTRUCTION MANAGER** *(Firm name)***SIGNATURE**

Kevin Hitchel, Sr. Project Manager

**PRINTED NAME AND TITLE****DATE:**

Christian County Board of Education

**OWNER** *(Firm name)***SIGNATURE**

Christopher Bentzel, Superintendent

**PRINTED NAME AND TITLE****DATE:**



# PROPOSED CHANGE ORDER

**PROJECT** Christian County High School

**CONTRACTOR/SUPPLIER** State Electric

**BID PACKAGE** 260

DETAIL ITEM	AMOUNT	
LABOR	\$	4,914.00
MATERIALS	\$	8,646.16
PROFIT & OVERHEAD	\$	2,034.02
BOND INSURANCE		
<b>COST BREAKDOWN TOTAL</b>	\$	15,594.18

## DESCRIPTION

Access control infrastructure, fire alarm, and electrical revisions per PR #1.

\_\_\_\_\_

\_\_\_\_\_

\_\_\_\_\_

\_\_\_\_\_

**PR #** 1 (ATTACH PR)

## CHANGE ORDER INITIATED BY:

  X   ARCHITECT/ENGINEER

       OWNER

       CONTRACTOR

       CM

       CODE OFFICIAL

       OTHER \_\_\_\_\_

PLEASE INCLUDE THIS FORM WITH EVERY  
CHANGE ORDER.

---

## PROPOSAL REQUEST

---

<b>Project:</b>	Christian County High School 5185 Ft. Campbell Blvd Hopkinsville, KY 42240	<b>PR No.:</b>	001
		<b>Date:</b>	October 13, 2023
<b>Owner:</b>	Christian County Public Schools 222 Glass Ave Hopkinsville, KY 42240	<b>Project Number:</b>	2106-204
		<b>Contract for:</b>	
<b>To:</b>	Tim Geegan Alliance Corporation 116 E. College Steet Glasgow, KY 42141		
<b>RE:</b>	<b>State Required Egress Door Modifications, Misc Door Changes and Minor structural clarifications.</b>		

Please submit an itemized quotation for changes in the Contract Sum and/or Time incidental to proposed modifications to the Contract Documents described herein. THIS IS NOT A CHANGE ORDER NOR A DIRECTION TO PROCEED WITH THE WORK DESCRIBED HEREIN.

### Description:

- 1) At Gymnasium B106, add opening B101.09 as shown on attached plans and details and add electrical items as indicated.
- 2) At Gymnasium B106, add opening B101.10 as shown on attached plans and details. Modify concrete portal to accommodate door and add electrical items as indicated.
- 3) At Entry C100C, delete overhead coiling fire-rated tornado door C100C. Add openings C100C.2 and C100C.3 as shown on attached plans and details. Modify concrete portal to accommodate doors. Construct brick wing walls as shown for magnetic hold opens.
- 4) At Corridor B100C, add opening B100D to frame W51 as shown on attached plans and details.
- 5) Change width of door D106 from 3'-0" to 3'-8".
- 6) Provide removable mullions in lieu of rods at exit devices at all pairs of doors in hardware sets #1, #2, #3, #4, #17, #36 & #37.
- 7) Provide removable mullions in lieu of rods at exit devices at doors A100J.2, C101.5 & C101.6 in hardware set #26.
- 8) At E1 & E3, modify openings E1 & E2 to be a pair of exterior doors as shown on attached plans and elevations and details. Modify frame W7 at these openings only to be W7.1.
- 9) See Details 2/PR-1S1, 1/PR-1S3, 1/PR-1S6, 1/PR-1S7, 1/PR-1S9, 1/PR-1S10 for clarification on footing requirements.


- 10) See 1/PR-1S5 for clarification on CMU wall height adjacent to CLs FF/F5
- 11) See 1/PR-1S8 for Area G lintel clarification.

Attachments: PR-1A1 to 1A9;  
PR-1S1 to 1S16;  
PR-1E1 to 1E15

By: Eric Rang

CC:



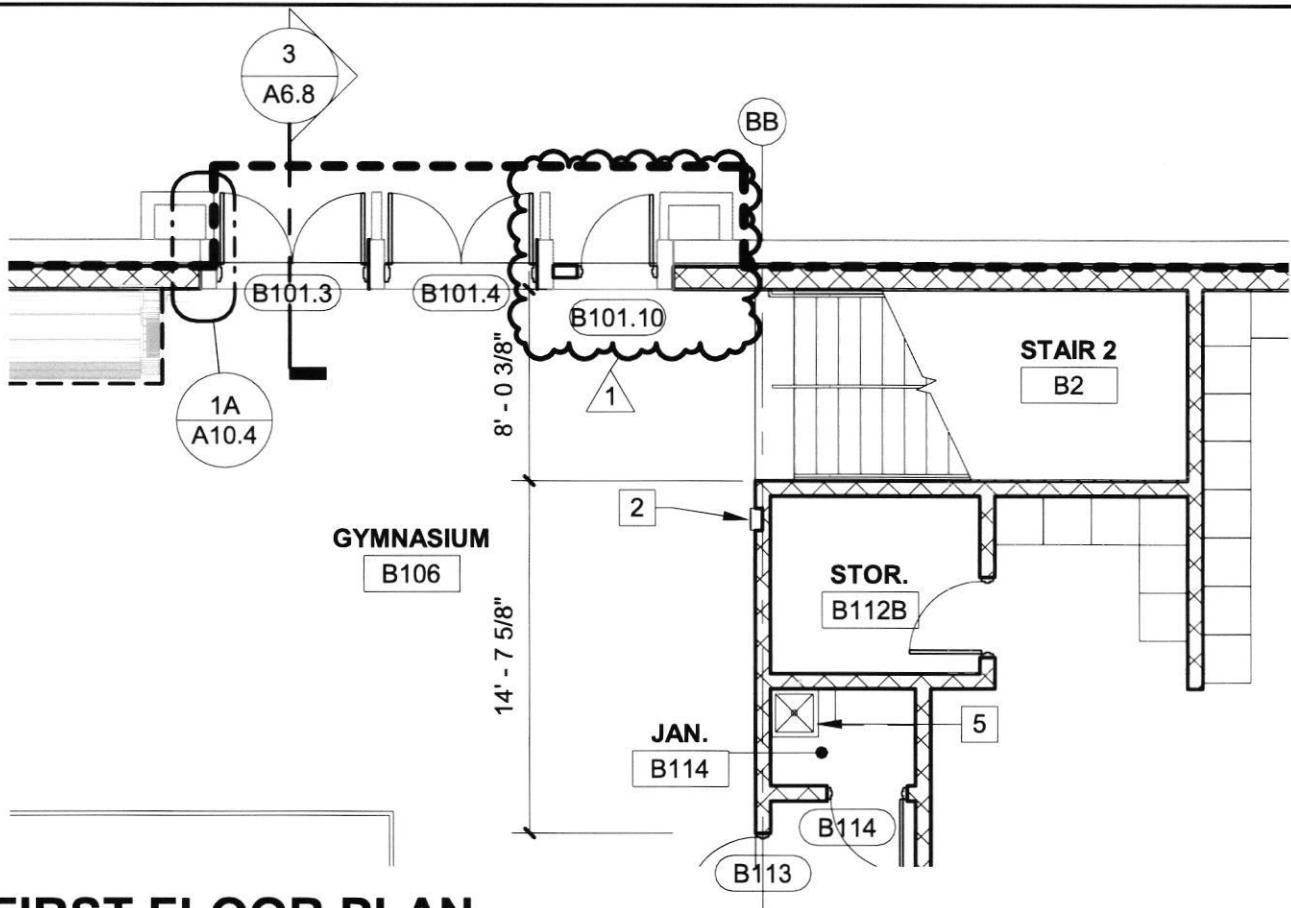


## FIRST FLOOR PLAN

ORIGINAL DETAIL 1 / A1.1B Alt

1

1/8" = 1'-0"

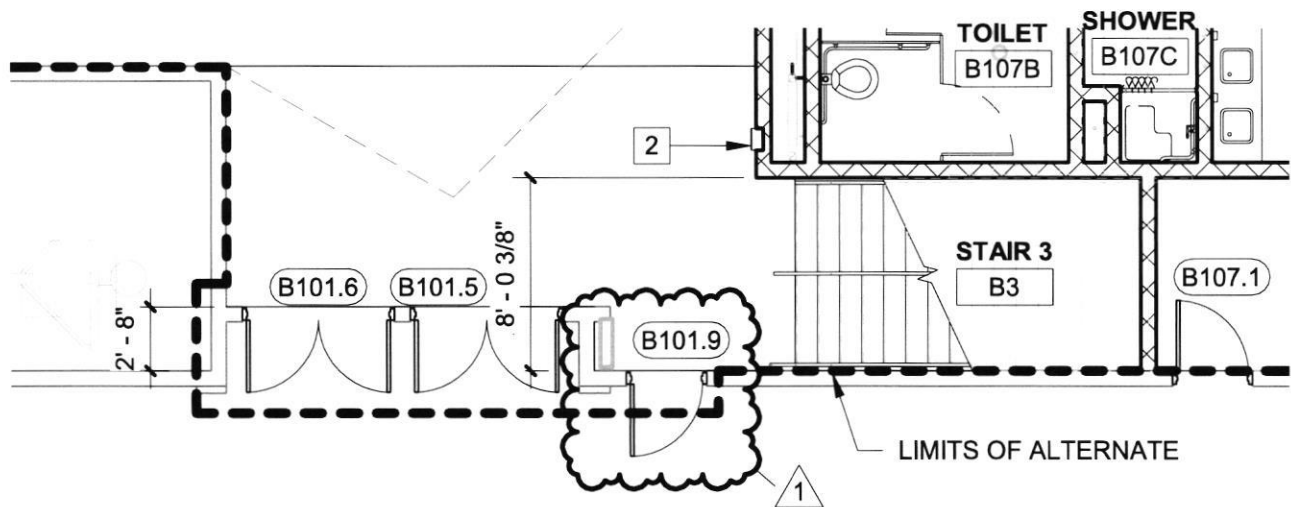

## FIRST FLOOR PLAN

ORIGINAL DETAIL 1 / A1.1B Alt

2

1/8" = 1'-0"

HOPKINSVILLE - CHRISTIAN  
COUNTY ACADEMY

KDE # : BG 22-104

5185 FT. CAMPBELL BLVD  
HOPKINSVILLE, KY 42240

**HAFER**  
architects • designers • engineers

21 SE Third Street,  
Suite 800  
Evansville, IN 47708

T: 812.422.4187  
F: 812.421.6776  
www.hafersdesign.com

ARCHITECTS PROJECT NO.


**2106-204**

DATE:

**10/05/2023**

TYPE OF DRAWING NO.

**PR-1A1**

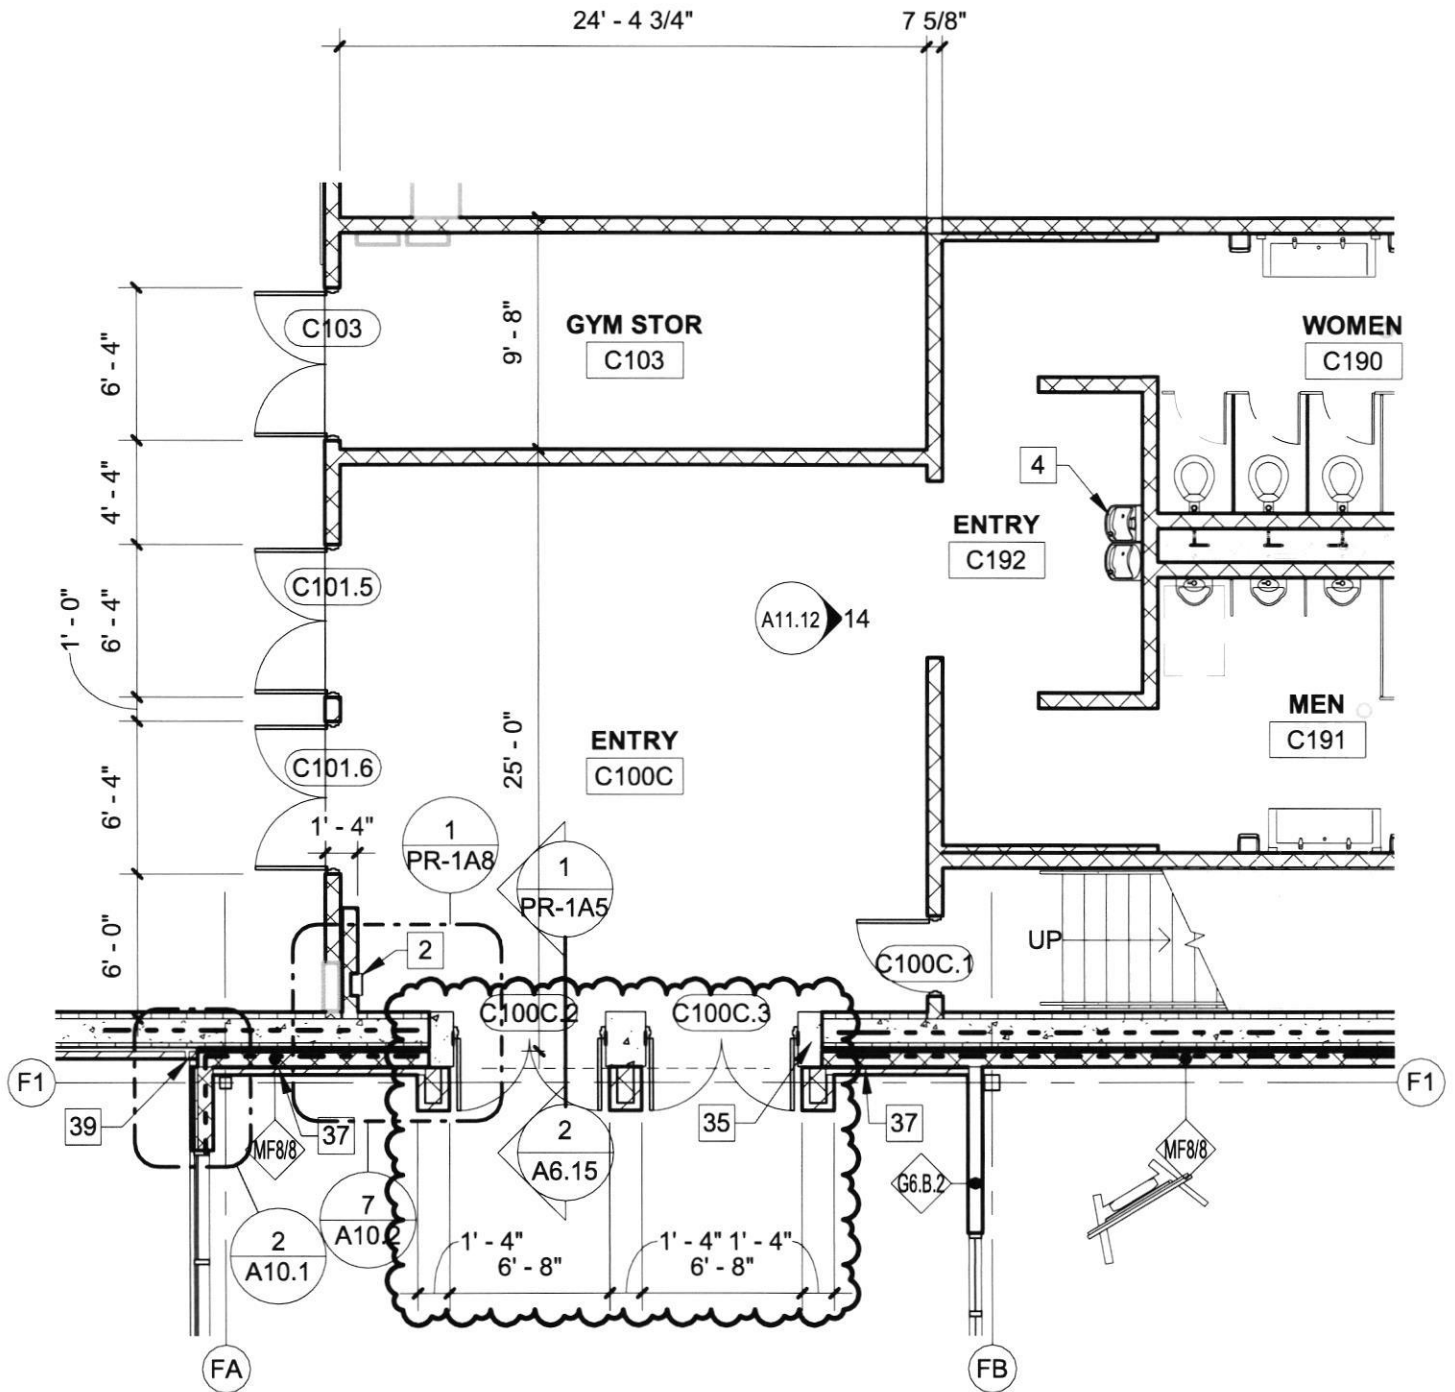

# 1 FIRST FLOOR PLAN - AREA C

ORIGINAL DETAIL C / A1.1C

1

1/8" = 1'-0"

HOPKINSVILLE - CHRISTIAN  
COUNTY ACADEMY

KDE #: BG 22-104

5185 FT. CAMPBELL BLVD  
HOPKINSVILLE, KY 42240

**HAFER**  
architects • designers • engineers

21 SE Third Street,  
Suite 800  
Evansville, IN 47708

T: 812.422.4187  
F: 812.421.6776  
www.haferdesign.com

ARCHITECTS PROJECT NO.

**2106-204**


DATE:

**10/05/2023**

TYPE OF DRAWING NO.

**PR-1A2**

**CORRIDOR**  
B100C

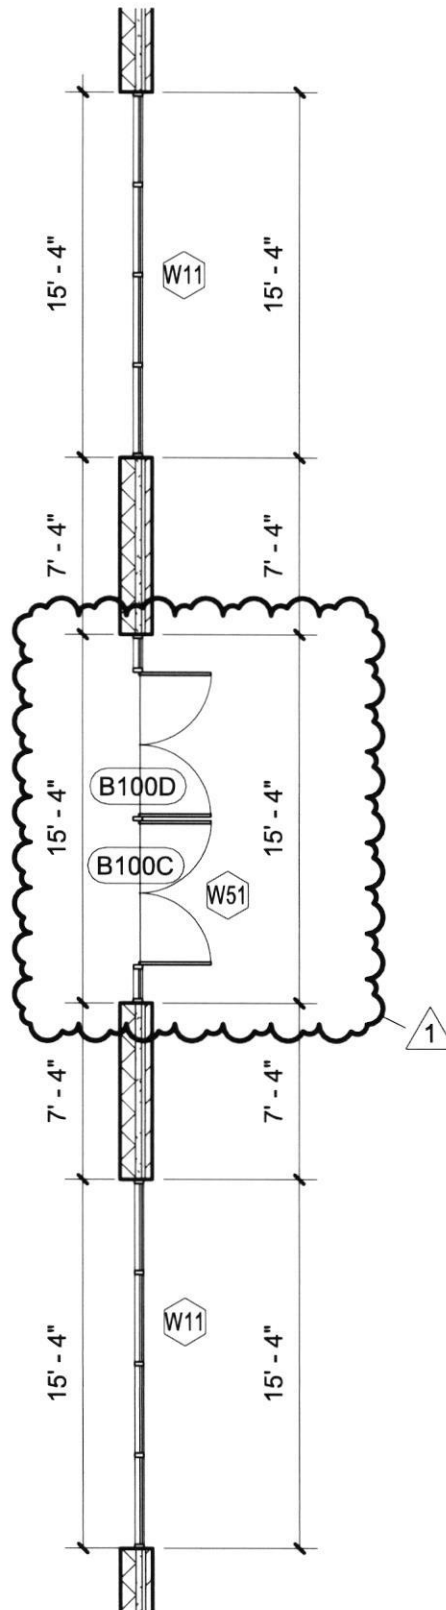

4 A4.8

1

# **FIRST FLOOR PLAN - AREA E**

ORIGINAL DETAIL E / A1.1E

1/8" = 1'-0"

**HOPKINSVILLE - CHRISTIAN  
COUNTY ACADEMY**

KDE # : BG 22-104

5185 FT. CAMPBELL BLVD  
HOPKINSVILLE, KY 42240

**HAFER**  
architects • designers • engineers

21 SE Third Street,  
Suite 800  
Evansville, IN 47708

T: 812.422.4187  
F: 812.421.6776  
www.haferdesign.com

ARCHITECTS PROJECT NO.

**2106-204**


DATE:

**10/05/2023**

TYPE OF DRAWING NO.

**PR-1A3**



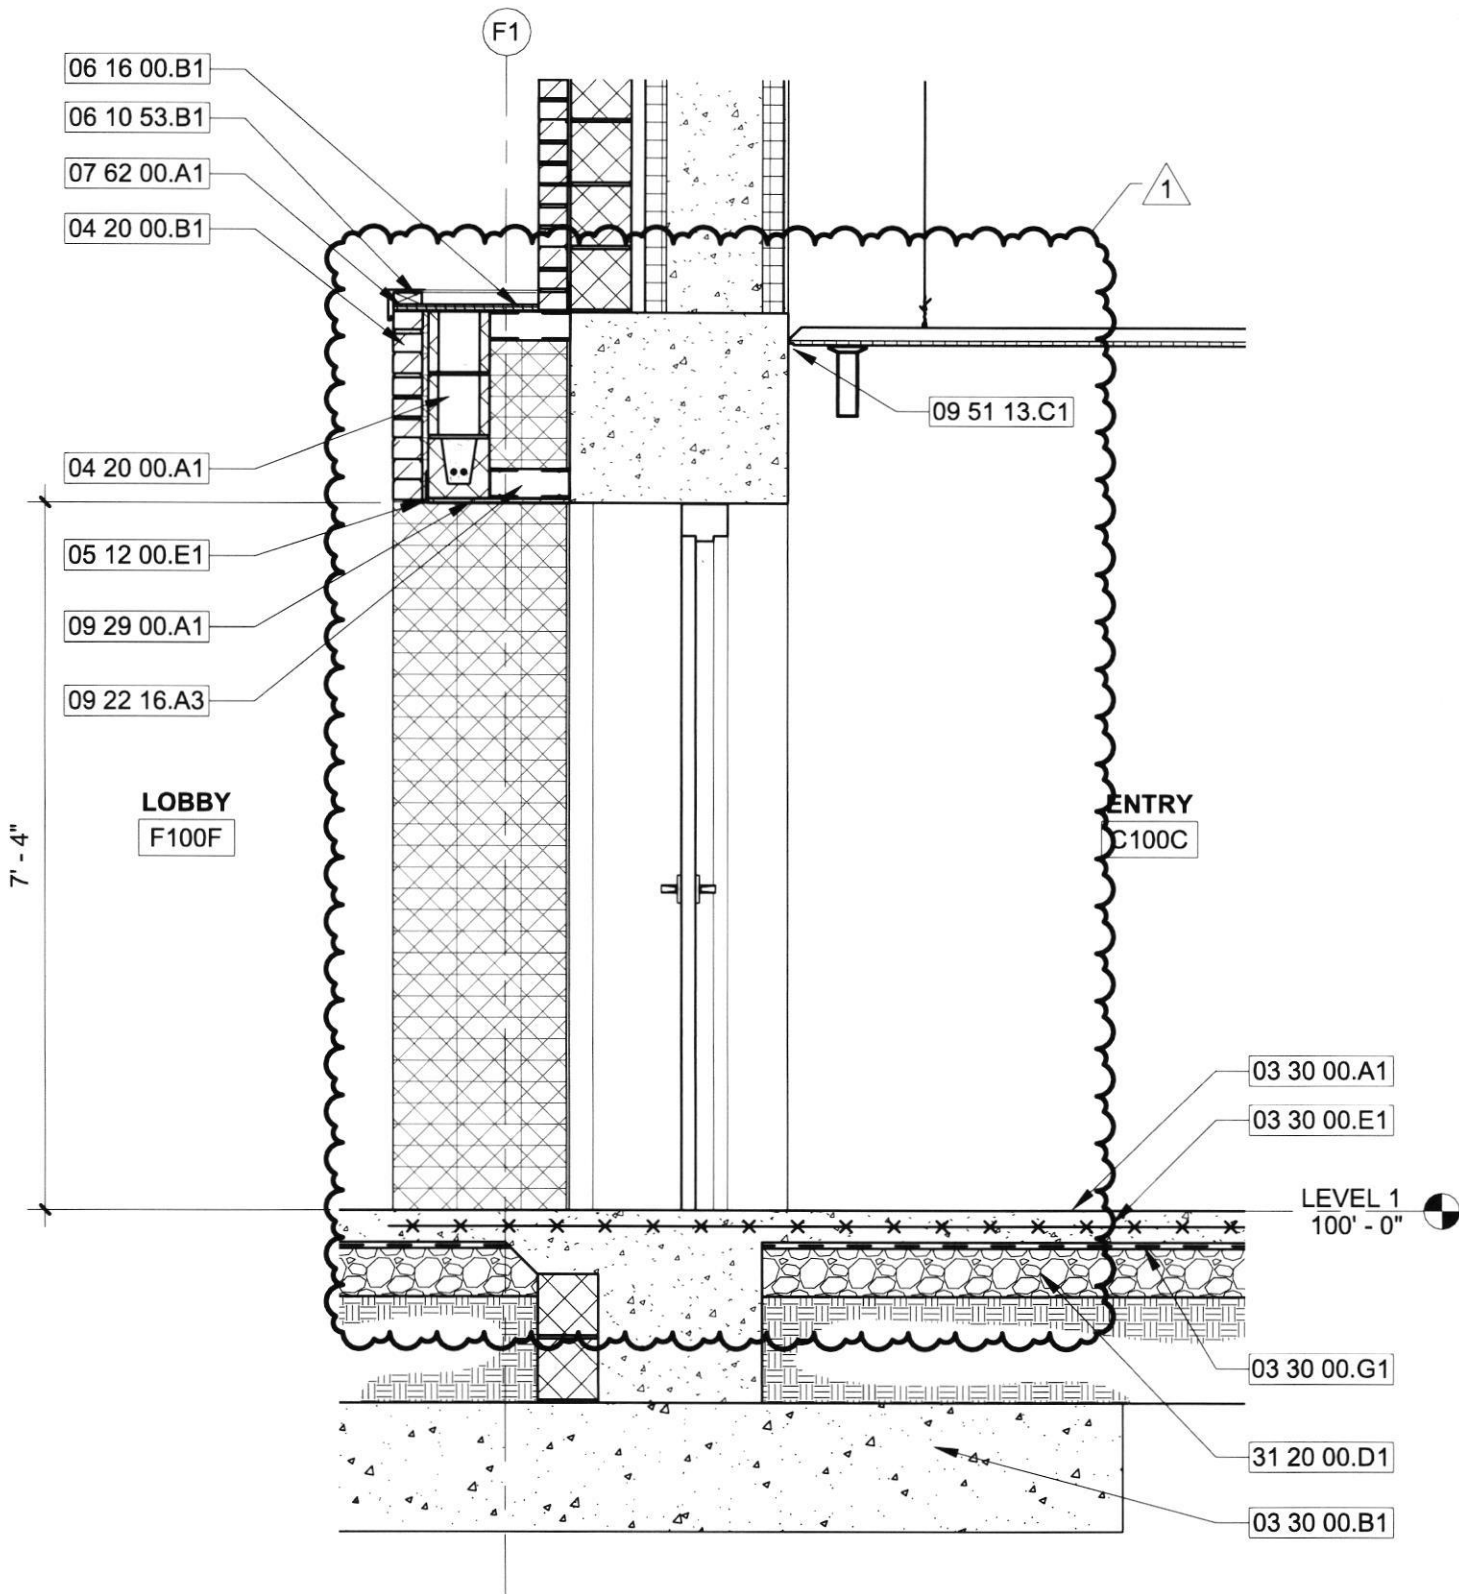

# WALL SECTION

ORIGINAL DETAIL 2 / A6.15

1

1/2" = 1'-0"

HOPKINSVILLE - CHRISTIAN  
COUNTY ACADEMY

KDE # : BG 22-104

5185 FT. CAMPBELL BLVD  
HOPKINSVILLE, KY 42240

**HAFER**  
architects • designers • engineers

21 SE Third Street,  
Suite 800  
Evansville, IN 47708

T: 812.422.4187  
F: 812.421.6776  
www.haferdesign.com

ARCHITECTS PROJECT NO.

2106-204


DATE:

10/05/2023

TYPE OF DRAWING NO.

PR-1A5



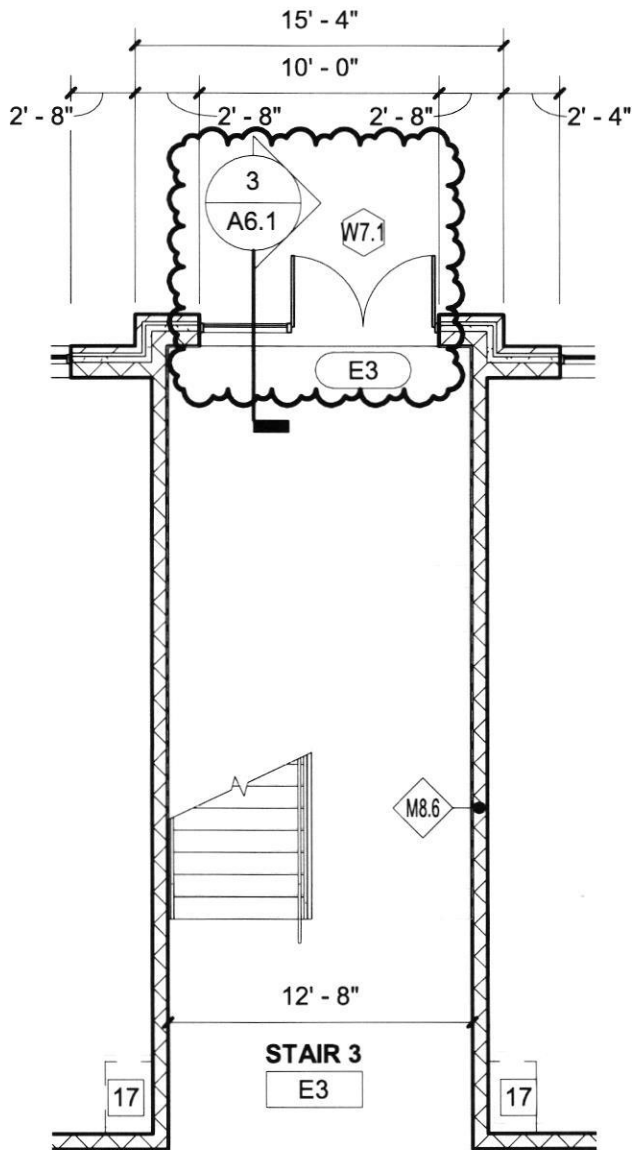


## FIRST FLOOR PLAN

1

1/8" = 1'-0"

ORIGINAL DETAIL E / A1.1E

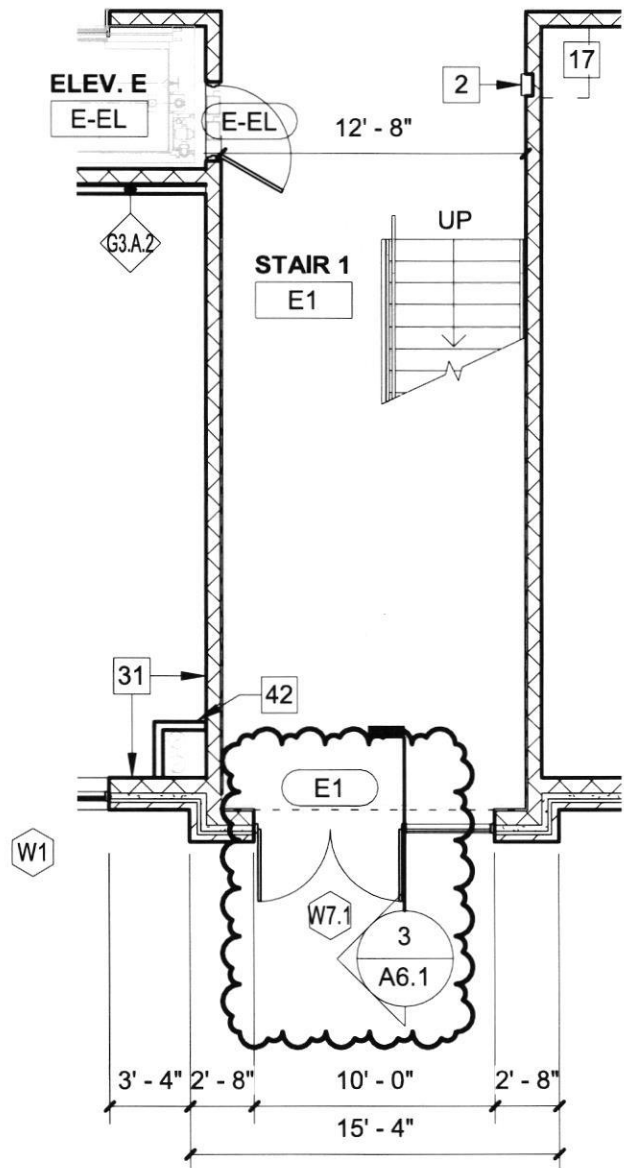

## FIRST FLOOR PLAN

2

1/8" = 1'-0"

ORIGINAL DETAIL E / A1.1E

HOPKINSVILLE - CHRISTIAN  
COUNTY ACADEMY

KDE # : BG 22-104

5185 FT. CAMPBELL BLVD  
HOPKINSVILLE, KY 42240

**HAFER**  
architects • designers • engineers

21 SE Third Street,  
Suite 800  
Evansville, IN 47708

T: 812.422.4187  
F: 812.421.6776  
www.haferdesign.com

ARCHITECTS PROJECT NO.



**2106-204**

DATE:

**10/05/2023**

TYPE OF DRAWING NO.

**PR-1A6**

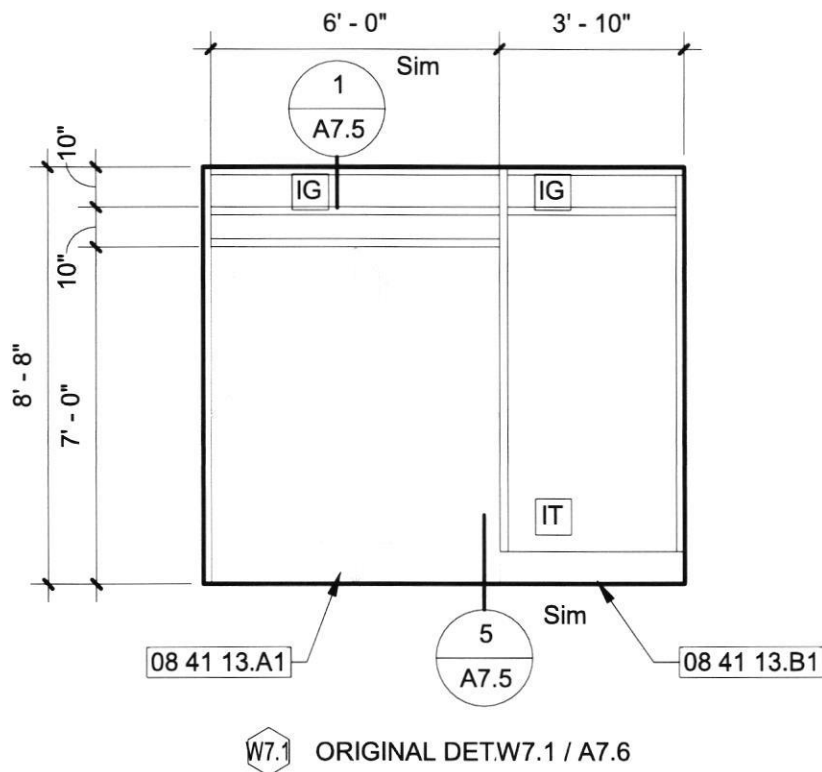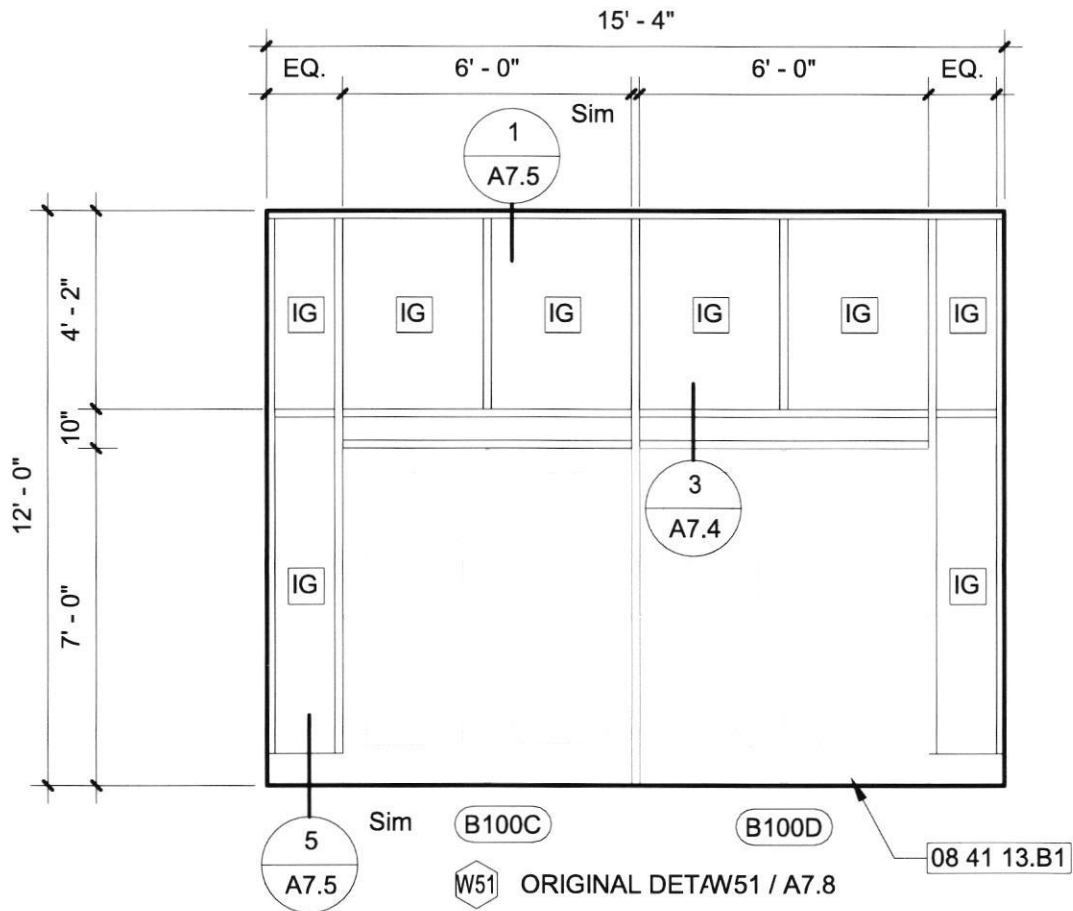

HOPKINSVILLE - CHRISTIAN  
COUNTY ACADEMY

KDE # : BG 22-104

5185 FT. CAMPBELL BLVD  
HOPKINSVILLE, KY 42240

**HA FER**  
architects • designers • engineers

21 SE Third Street,  
Suite 800  
Evansville, IN 47708

T: 812.422.4187  
F: 812.421.6776  
www.haferdesign.com

ARCHITECTS PROJECT NO.


**2106-204**

DATE:

**10/05/2023**

TYPE OF DRAWING NO.

**PR-1A7**

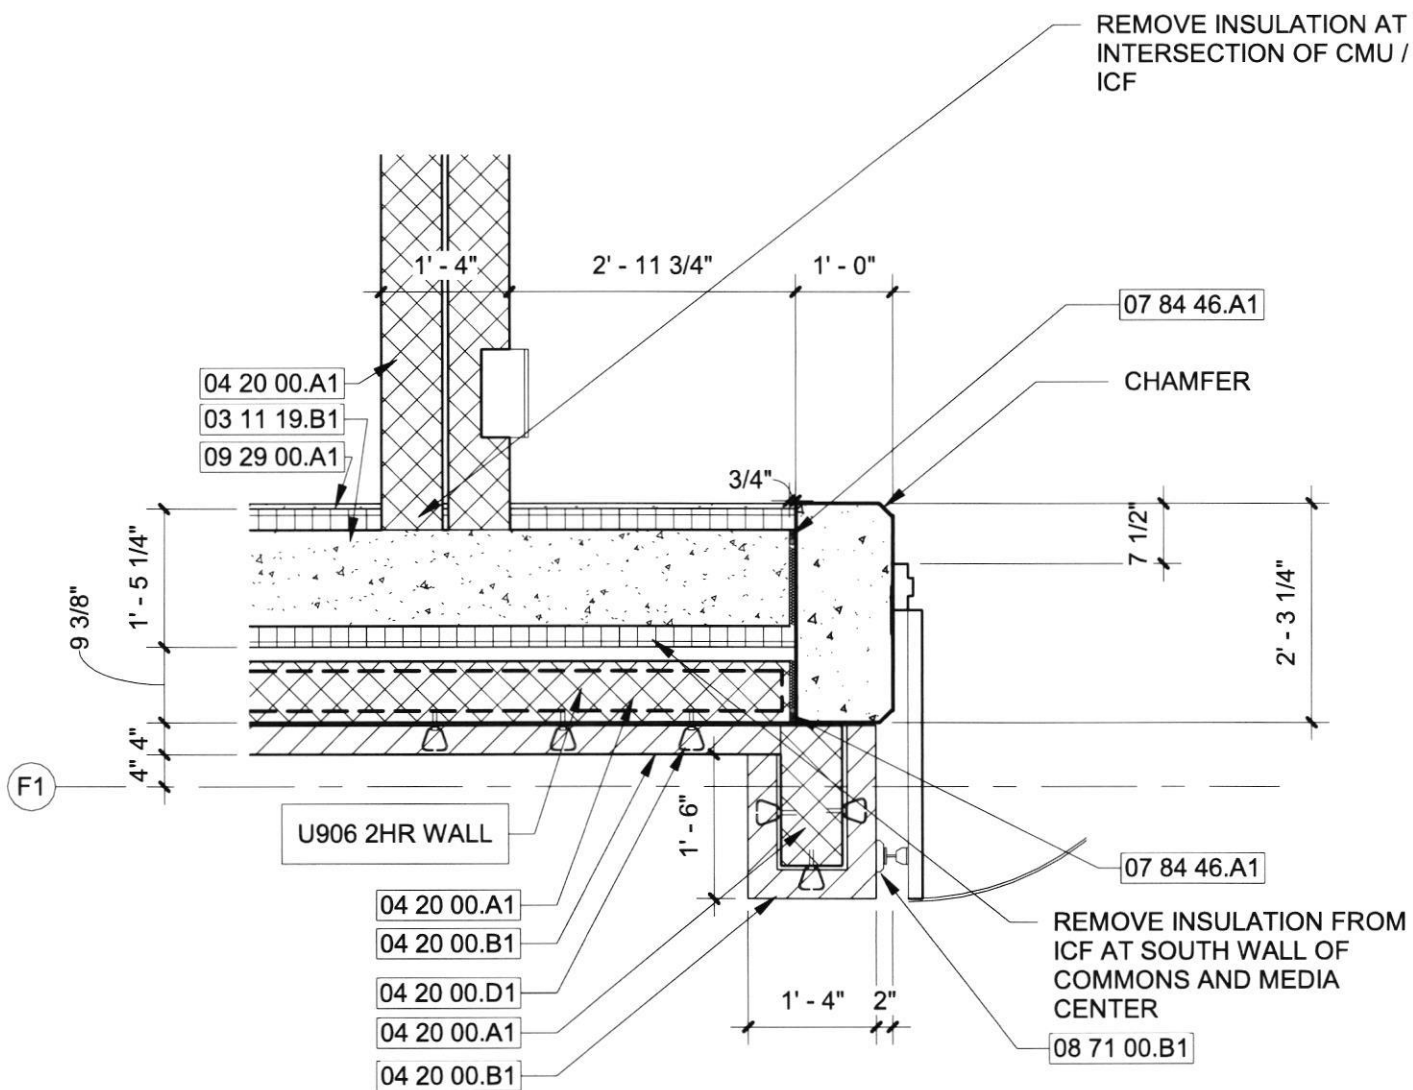

## PLAN DETAIL

ORIGINAL DETAIL 7 / A10.2

1

1/2" = 1'-0"

HOPKINSVILLE - CHRISTIAN  
COUNTY ACADEMY

KDE # : BG 22-104

5185 FT. CAMPBELL BLVD  
HOPKINSVILLE, KY 42240

**HAFER**  
architects • designers • engineers

21 SE Third Street,  
Suite 800  
Evansville, IN 47708

T: 812.422.4187  
F: 812.421.6776  
www.haferdesign.com

ARCHITECTS PROJECT NO.

**2106-204**

DATE:

**10/05/2023**


TYPE OF DRAWING NO.

**PR-1A8**

# DOOR SCHEDULE - PR1

Door Number	Door Data				Frame Data				Hardware Set	Comments	Door Number				
	Fire Rating	Type	Material	Width	Height	Thickness	Glass	Type				Material	Head	Jamb	Depth
B100D	--	AG	AL	PR 3' - 0"	7' - 0"	1 3/4"	1" INSUL.	W51	AL	AL4	AL4	4 1/2"	#4 - EXTERIOR (P, ALUM) EX	PR1	B100D
B101.9	90 MIN.	F	HM	3' - 0"	7' - 0"	1 3/4"		F2		HM2	HM2	5 3/4"	#17 - PAIR (90) EX, SEE NOTE	PR1	B101.9
B101.10	90 MIN.	F	HM	3' - 0"	8' - 0"	1 3/4"	--	F2		HM3	HM3	5 3/4"	#17 - PAIR (90) EX, SEE NOTE	PR1	B101.10
C100C.2	90 MIN.	F	HM	PR 3' - 0"	7' - 0"	1 3/4"		F2		HM3	HM3	5 3/4"	#37 - PAIR (ICC, 90)	PR1, ICC500	C100C.2
C100C.3	90 MIN.	F	HM	PR 3' - 0"	7' - 0"	1 3/4"		F2		HM3	HM3	5 3/4"	#37 - PAIR (ICC, 90)	PR1, ICC500	C100C.3
D106	--	F	WD	3' - 8"	7' - 0"	1 3/4"	--	F2	HM	HM2	HM2	5 3/4"	#20 - CLASSROOM (S) 50+	PR1	D106
E1	--	AG	AL	PR 3' - 0"	7' - 0"	1 3/4"	1" INSUL.	W7.1	AL	SEE PLAN	SEE PLAN	4 1/2"	#4 - EXTERIOR (P, ALUM) EX	PR1	E1
E3	--	AG	AL	PR 3' - 0"	7' - 0"	1 3/4"	1" INSUL.	W7.1	AL	SEE PLAN	SEE PLAN	4 1/2"	#4 - EXTERIOR (P, ALUM) EX	PR1	E3

NOTE - DOOR B100.9 - PROVIDE HARDWARE SET SIMILAR TO #17, MODIFIED FOR SINGLE DOOR AND PROVIDE MAGNETIC HOLD OPEN.  
 - DOOR B100.10- PROVIDE HARDWARE SET SIMILAR TO #17, MODIFIED FOR SINGLE DOOR, NO MAGNETIC HOLD OPEN, AND CLOSER TO NOT HAVE HOLD OPEN.

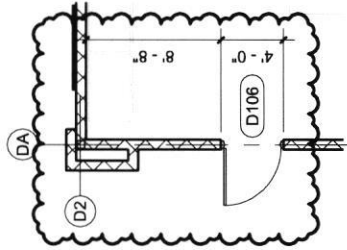

1 FIRST FLOOR PLAN - AREA D


1/8" = 1'-0"

HOPKINSVILLE - CHRISTIAN  
 COUNTY ACADEMY  
 KDE # : BG 22-104  
 5185 FT. CAMPBELL BLVD  
 HOPKINSVILLE, KY 42240


HAFER  
 architects • designers • engineers  
 T: 812.422.4187  
 F: 812.421.6776  
 www.hafdesign.com

21 SE Third Street,  
 Suite 800  
 Evansville, IN 47708

ARCHITECTS PROJECT NO. 2106-204  
 DATE: 10/05/2023  
 TYPE OF DRAWING NO. PR-1A9

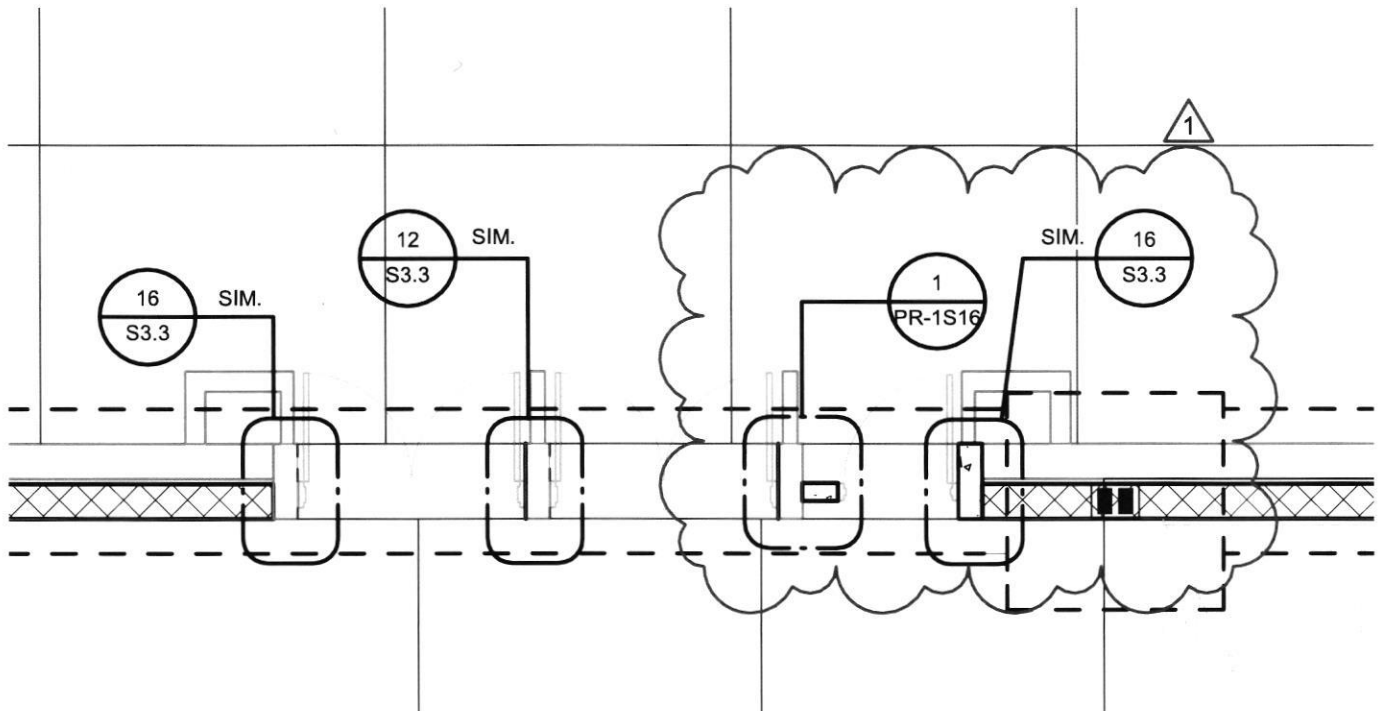

**1** FOUNDATION PLAN - AREA A  
SCALE: 3/16" = 1'-0"

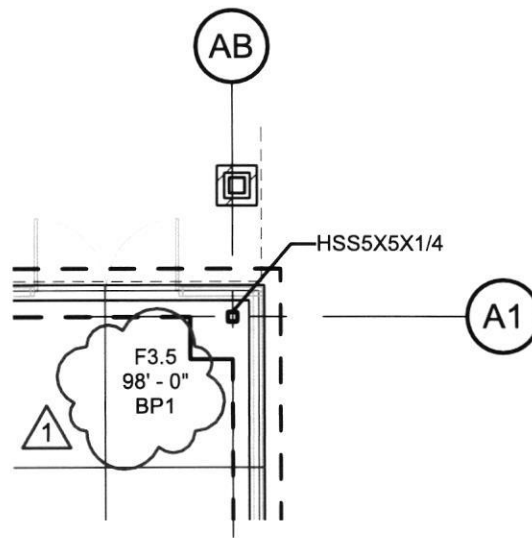

PLAN NORTH



**2** FOUNDATION PLAN - AREA A  
SCALE: 1/8" = 1'-0"

HOPKINSVILLE - CHRISTIAN  
COUNTY ACADEMY

KDE # : BG 22-104

5185 FT. CAMPBELL BLVD  
HOPKINSVILLE, KY 42240

**HAFER**  
architects • designers • engineers

21 SE Third Street,  
Suite 800  
Evansville, IN 47708

T: 812.422.4187  
F: 812.421.6776  
www.haferdesign.com

ARCHITECTS PROJECT NO.  
**2106-204**


DATE:  
**10/13/23**

TYPE OF DRAWING NO.

**PR-1S1**



REFERENCE SHEETS S2.1A & S2.1B ALT

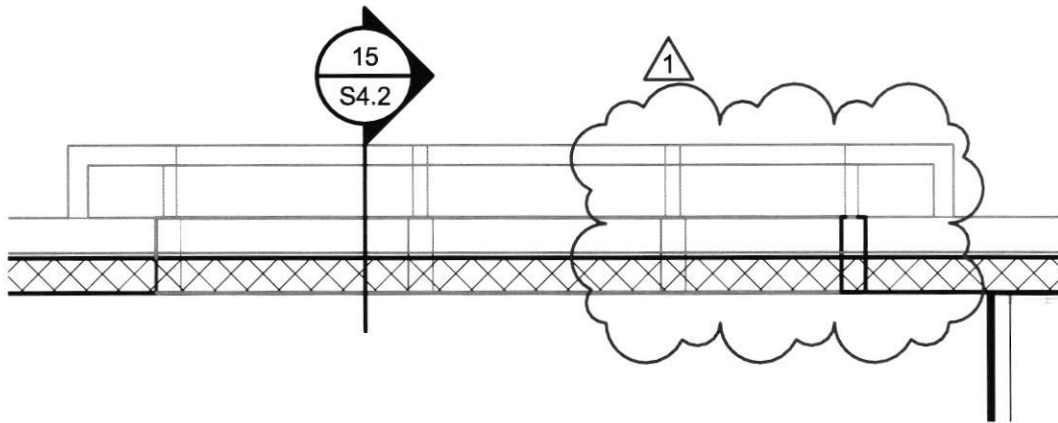

**1** LEVEL 2 FRAMING PLAN - AREA A  
SCALE: 3/16" = 1'-0"

PLAN NORTH



HOPKINSVILLE - CHRISTIAN  
COUNTY ACADEMY

KDE # : BG 22-104

5185 FT. CAMPBELL BLVD  
HOPKINSVILLE, KY 42240

**HAFER**  
architects • designers • engineers

21 SE Third Street,  
Suite 800  
Evansville, IN 47708

T: 812.422.4187  
F: 812.421.6776  
[www.haferdesign.com](http://www.haferdesign.com)

ARCHITECTS PROJECT NO.

**2106-204**


DATE:

**10/13/23**

TYPE OF DRAWING NO.

**PR-1S2**

REFERENCE SHEET S1.1C

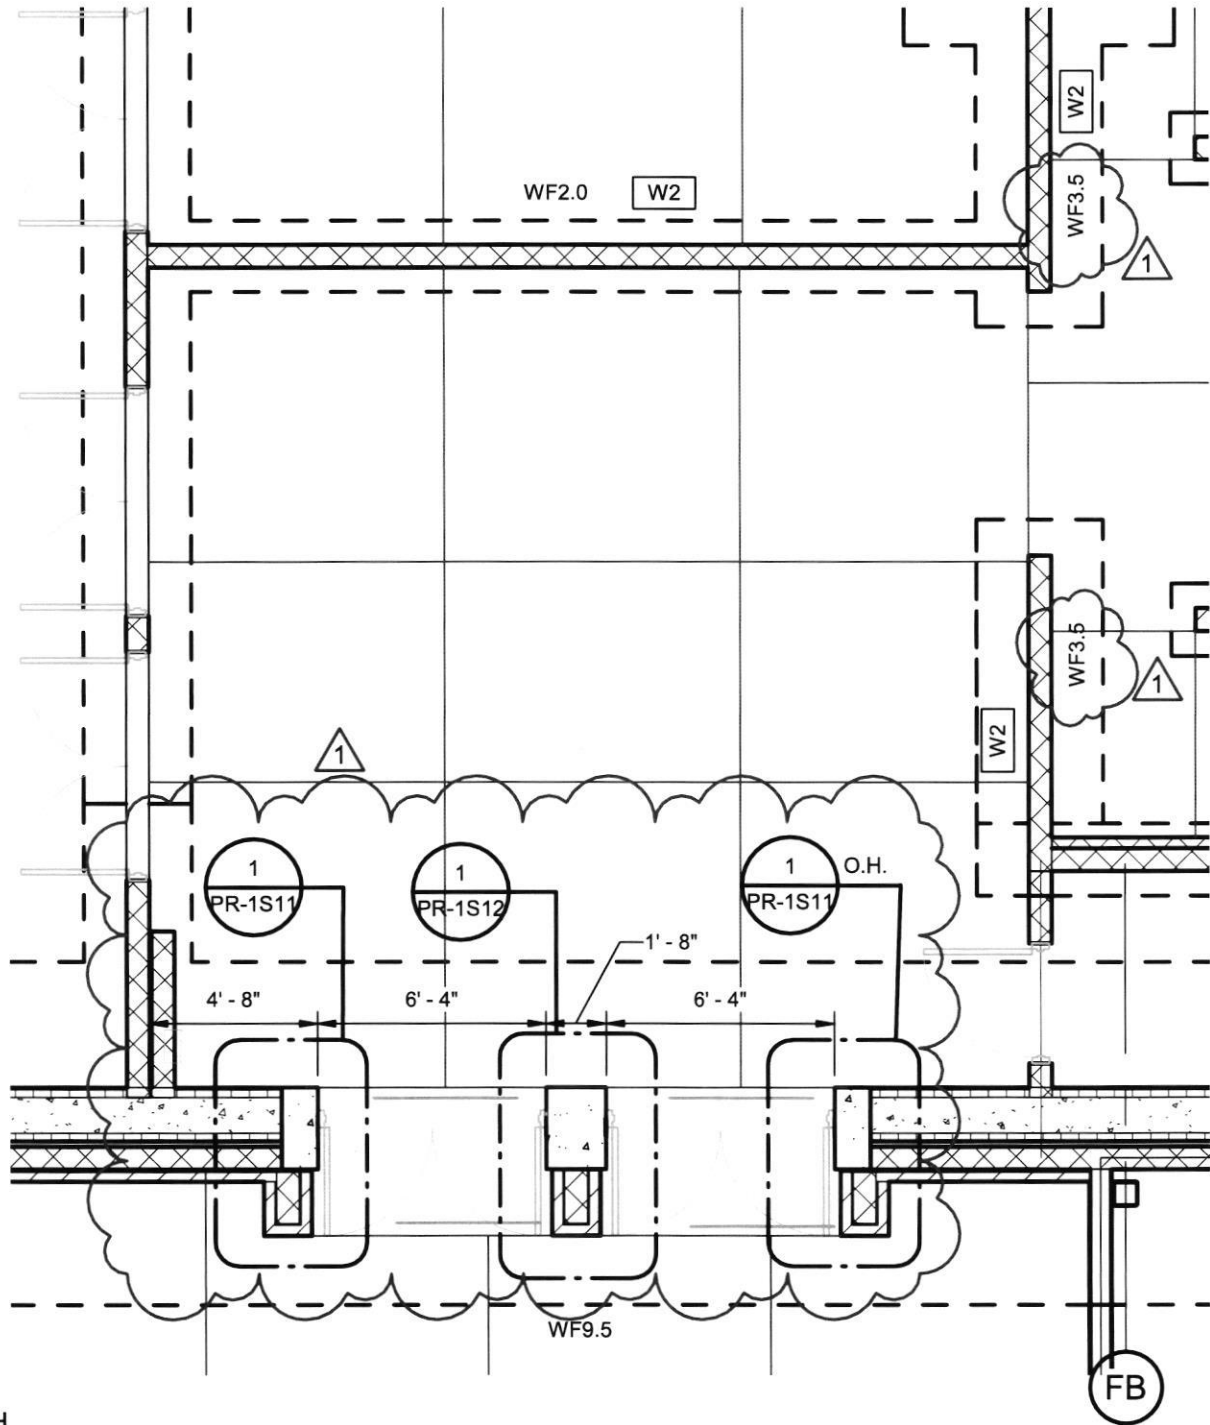

PLAN NORTH



1

# FOUNDATION PLAN - AREA C

SCALE: 3/16" = 1'-0"

HOPKINSVILLE - CHRISTIAN  
COUNTY ACADEMY

KDE # : BG 22-104

5185 FT. CAMPBELL BLVD  
HOPKINSVILLE, KY 42240

**HAFER**  
architects • designers • engineers

21 SE Third Street,  
Suite 800  
Evansville, IN 47708

T: 812.422.4187  
F: 812.421.6776  
www.haferdesign.com

ARCHITECTS PROJECT NO.

2106-204

DATE:


10/13/23

TYPE OF DRAWING NO.

PR-1S3

[illegible]

ARCHITECTS PROJECT NO. <b>2106-204</b>	DATE: <b>10/13/23</b>
TYPE OF DRAWING NO. <b>PR-1S4</b>	

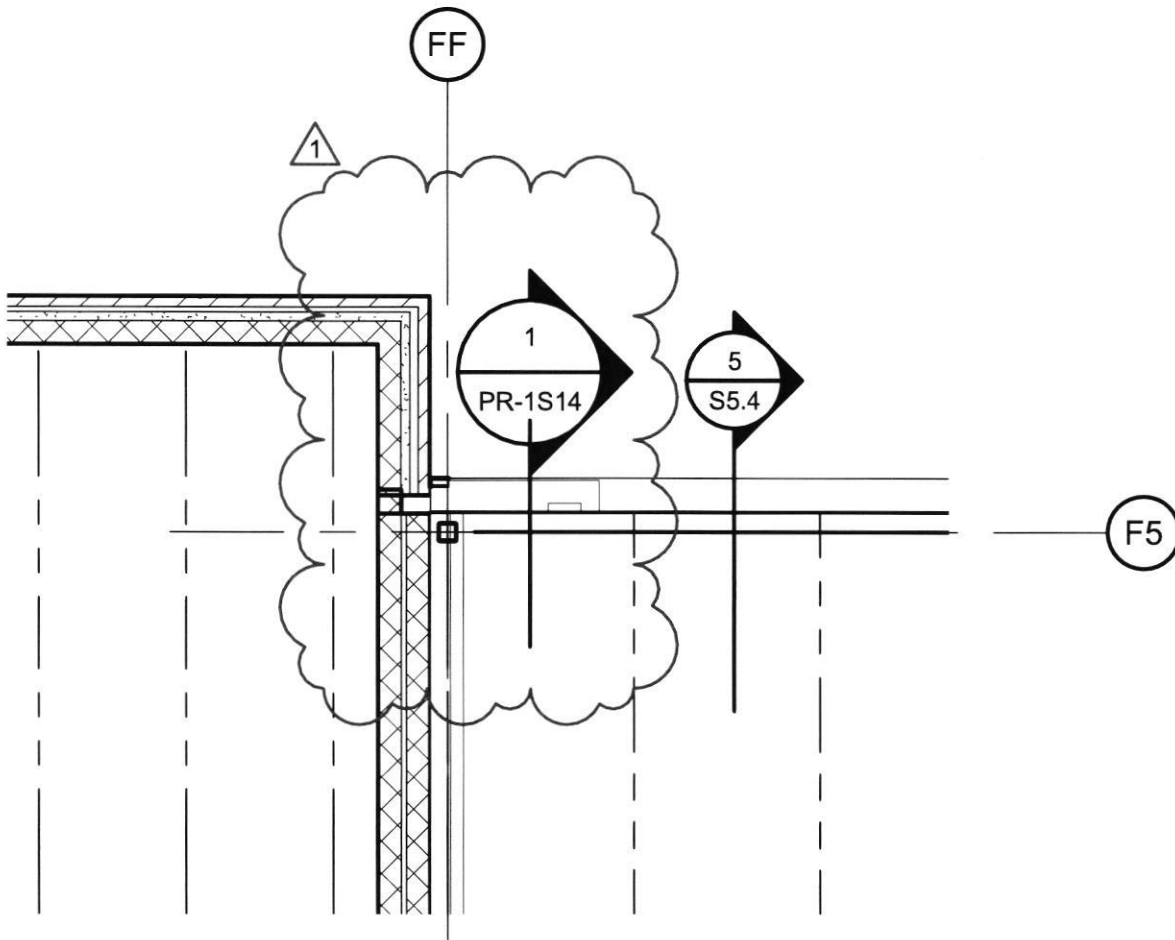

**1 ROOF FRAMING PLAN - AREA F**  
SCALE: 3/16" = 1'-0"

PLAN NORTH



HOPKINSVILLE - CHRISTIAN  
COUNTY ACADEMY

KDE # : BG 22-104

5185 FT. CAMPBELL BLVD  
HOPKINSVILLE, KY 42240

**HAFER**  
architects • designers • engineers

21 SE Third Street,  
Suite 800  
Evansville, IN 47708


T: 812.422.4187  
F: 812.421.6776  
[www.haferdesign.com](http://www.haferdesign.com)

ARCHITECTS PROJECT NO.  
**2106-204**

DATE:  
**10/13/23**

TYPE OF DRAWING NO.

**PR-1S5**

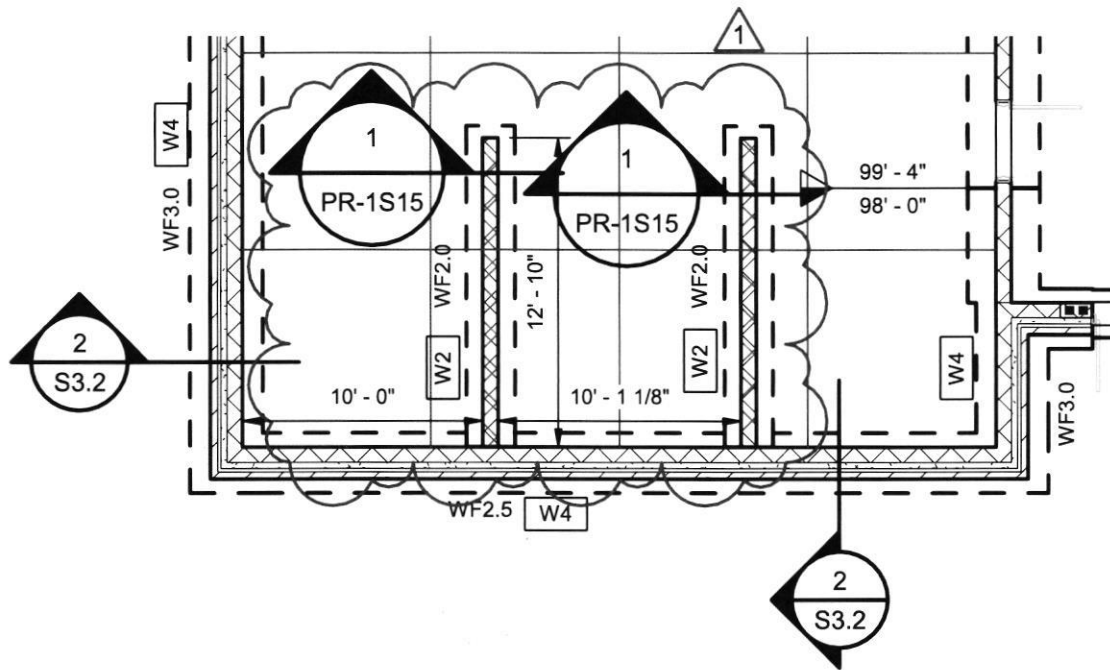

**1 FOUNDATION PLAN - AREA G**  
SCALE: 1/8" = 1'-0"

PLAN NORTH



**HOPKINSVILLE - CHRISTIAN  
COUNTY ACADEMY**

KDE # : BG 22-104

5185 FT. CAMPBELL BLVD  
HOPKINSVILLE, KY 42240

**HAFER**  
architects • designers • engineers

21 SE Third Street,  
Suite 800  
Evansville, IN 47708

T: 812.422.4187  
F: 812.421.6776  
www.haferdesign.com

ARCHITECTS PROJECT NO.

**2106-204**

DATE:

**10/13/23**

TYPE OF DRAWING NO.

**PR-1S6**





GA

SCALE: 1/8" = 1'-0"

5185 FT. CAMPBELL BLVD  
HOPKINSVILLE, KY 42240

HAFFER  
architects • designers • engineers


T: 812.422.4187  
F: 812.421.6776  
[www.haferdesign.com](http://www.haferdesign.com)

2106-204

DATE:  
**10/13/23**

TYPE OF DRAWING NO.

PR-1S7

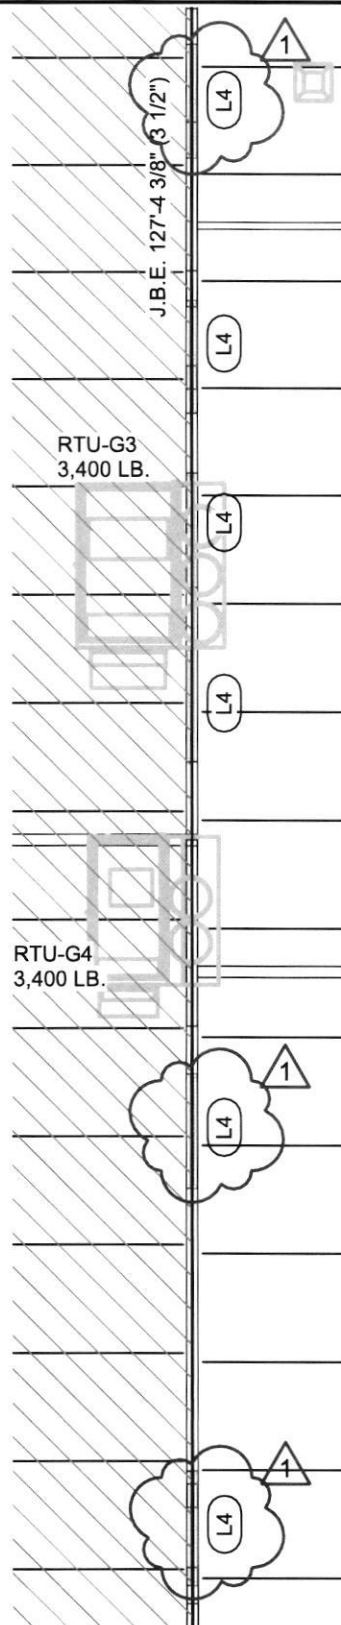

PLAN NORTH



# 1 ROOF FRAMING PLAN - AREA G

SCALE: 3/32" = 1'-0"

HOPKINSVILLE - CHRISTIAN  
COUNTY ACADEMY

KDE # : BG 22-104

5185 FT. CAMPBELL BLVD  
HOPKINSVILLE, KY 42240

**HAFER**  
architects • designers • engineers

21 SE Third Street,  
Suite 800  
Evansville, IN 47708


T: 812.422.4187  
F: 812.421.6776  
[www.haferdesign.com](http://www.haferdesign.com)

ARCHITECTS PROJECT NO.  
**2106-204**

DATE:  
**10/13/23**

TYPE OF DRAWING NO.

**PR-1S8**

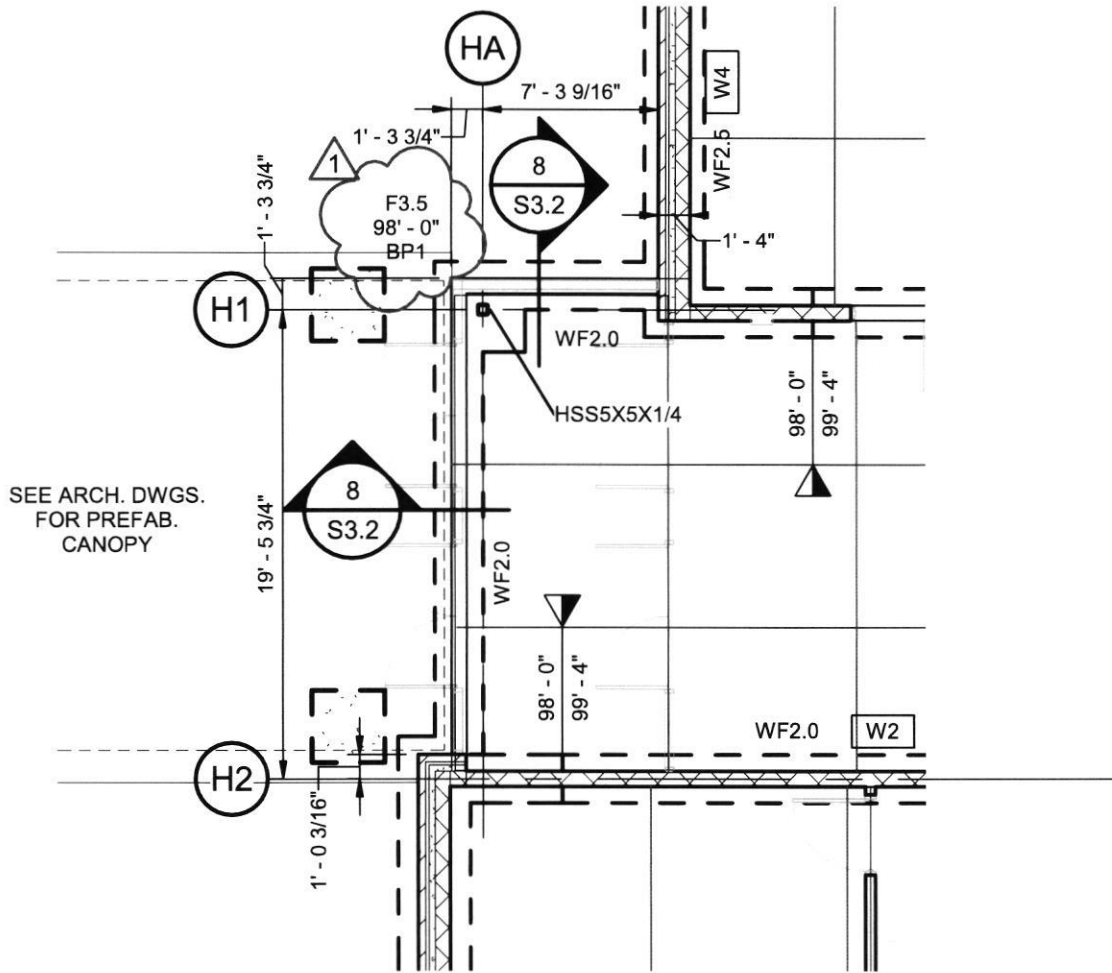

**1** FOUNDATION PLAN - AREA H  
SCALE: 1/8" = 1'-0"

PLAN NORTH



HOPKINSVILLE - CHRISTIAN  
COUNTY ACADEMY

KDE # : BG 22-104

5185 FT. CAMPBELL BLVD  
HOPKINSVILLE, KY 42240

**HAFER**  
architects • designers • engineers

21 SE Third Street,  
Suite 800  
Evansville, IN 47708


T: 812.422.4187  
F: 812.421.6776  
www.haferdesign.com

ARCHITECTS PROJECT NO.  
**2106-204**

DATE:  
**10/13/23**

TYPE OF DRAWING NO.

**PR-1S9**

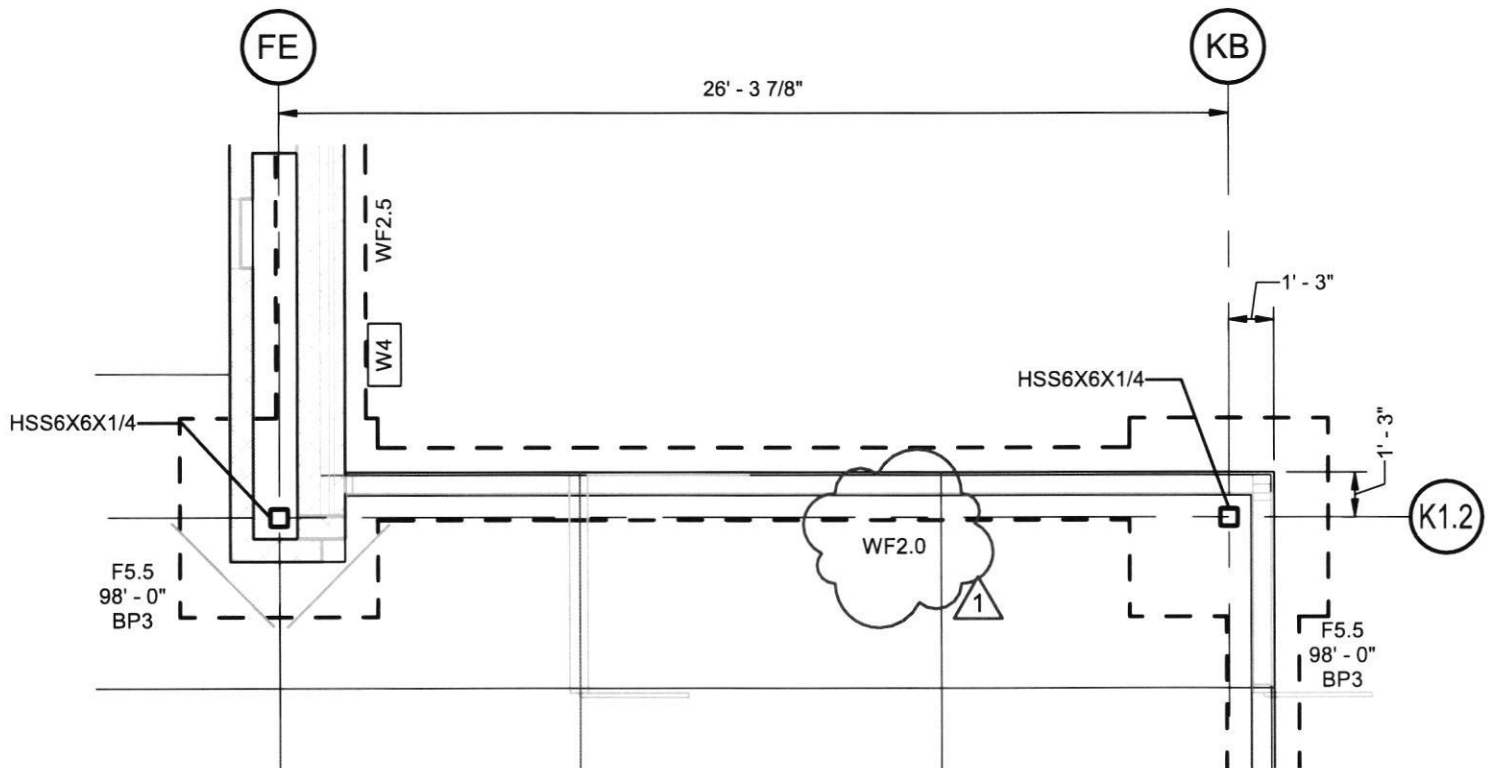

PLAN NORTH



**1 FOUNDATION PLAN - AREA K**  
SCALE: 3/16" = 1'-0"

HOPKINSVILLE - CHRISTIAN  
COUNTY ACADEMY

KDE # : BG 22-104

5185 FT. CAMPBELL BLVD  
HOPKINSVILLE, KY 42240

**HAFER**  
architects • designers • engineers

21 SE Third Street,  
Suite 800  
Evansville, IN 47708

T: 812.422.4187  
F: 812.421.6776  
www.haferdesign.com

ARCHITECTS PROJECT NO.

**2106-204**


DATE:

**10/13/23**

TYPE OF DRAWING NO.

**PR-1S10**

REFERENCE DETAIL 14/S3.3

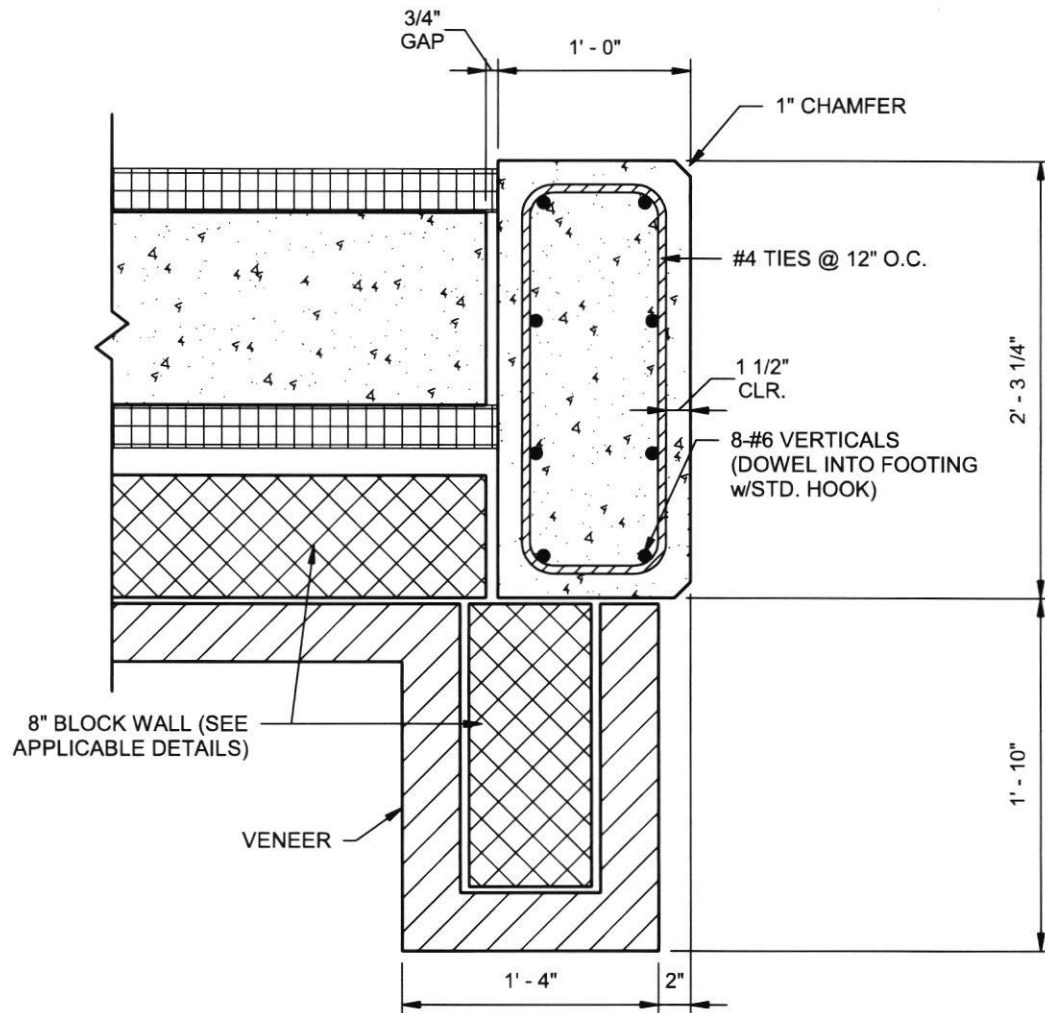

**1 CONCRETE COLUMN AT SHELTER**  
SCALE: 1" = 1'-0"

HOPKINSVILLE - CHRISTIAN  
COUNTY ACADEMY

KDE # : BG 22-104

5185 FT. CAMPBELL BLVD  
HOPKINSVILLE, KY 42240

**HAFER**  
architects • designers • engineers

21 SE Third Street,  
Suite 800  
Evansville, IN 47708

T: 812.422.4187  
F: 812.421.6776  
www.haferdesign.com

ARCHITECTS PROJECT NO.


**2106-204**

DATE:

**10/13/23**

TYPE OF DRAWING NO.

**PR-1S11**

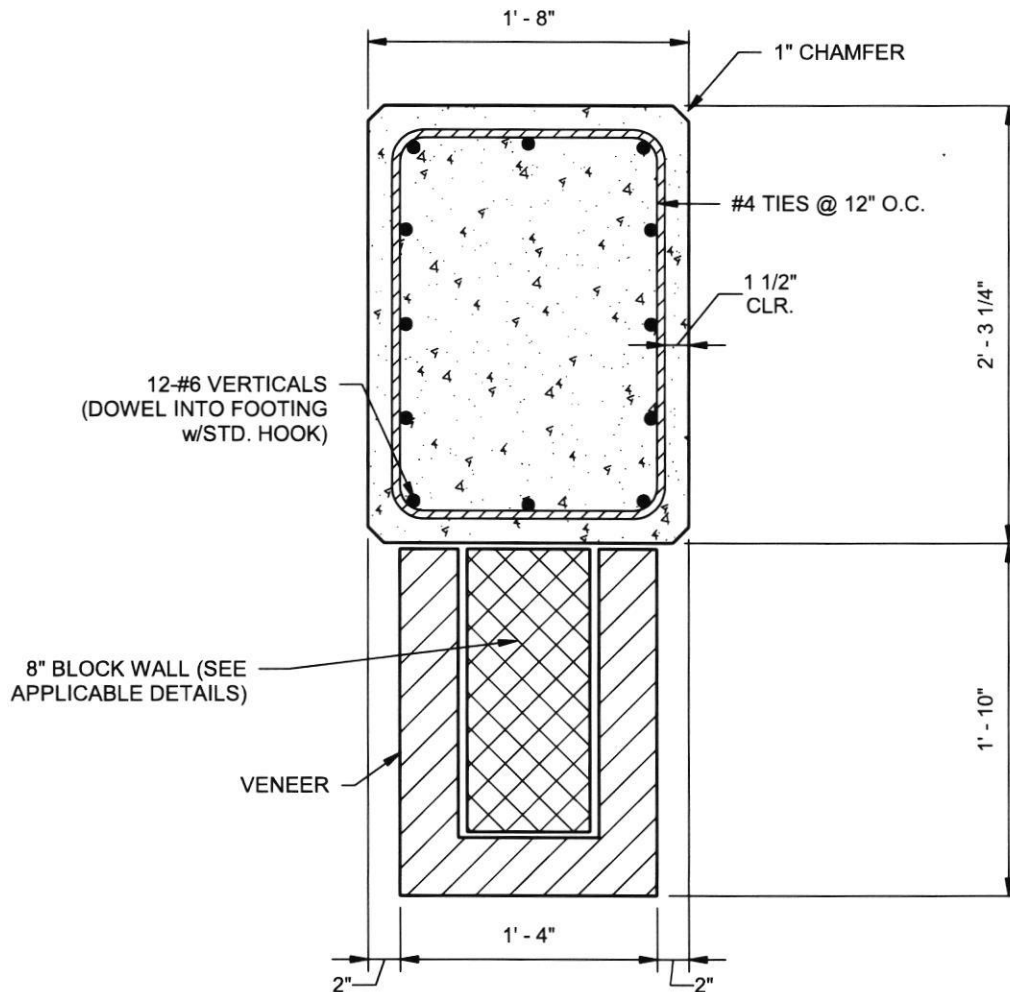

# 1 CONCRETE COLUMN AT SHELTER

SCALE: 1" = 1'-0"

HOPKINSVILLE - CHRISTIAN  
COUNTY ACADEMY

KDE # : BG 22-104

5185 FT. CAMPBELL BLVD  
HOPKINSVILLE, KY 42240

**HAFER**  
architects • designers • engineers

21 SE Third Street,  
Suite 800  
Evansville, IN 47708

T: 812.422.4187  
F: 812.421.6776  
www.haferdesign.com

ARCHITECTS PROJECT NO.

**2106-204**

DATE:

**10/13/23**

TYPE OF DRAWING NO.


**PR-1S12**

Architectural section drawing of a wall and foundation. The drawing includes the following details and dimensions:

- Wall Section:**
  - Top dimensions: 11 5/8" (horizontal), 4 3/8" (horizontal), 1' - 0" (horizontal).
  - Reinforcement: #5 HORIZONTALS @ 18" O.C., SEE SCHEDULE FOR REINF., JT. REINF. @ 16" O.C., #6 VERTICALS @ 8" O.C. EACH FACE.
  - Materials: 8" BLOCK, VENEER (SEE ARCH. DWGS.), INSULATING CONCRETE FORMING SYSTEM (SEE ARCH. DWGS.).
  - Other: VENEER TIES @ 16" O.C., 8" HIGH BD. BM. REINF. w/2-#5 CONT., CONC. BEAM.
- Foundation Section:**
  - Vertical dimensions: 2'-0" (wall height), 10" (beam height), 2'-0" (foundation height).
  - Horizontal dimensions: 1'-6" (wall width), 4" (beam width), 2'-3 1/4" (foundation width).
  - Reinforcement: #4 DOWELS @ 16" O.C. w/ 10" HOOK, 3-#6 CONT., 1 1/2" CLR., #4 STIRRUPS @ 12" O.C., 5-#6 CONT.
  - Other: 9 5/8" (foundation width segments), 4" (foundation width segments).
- Detail L3:**
  - Shows a cross-section of the block and reinforcement.
  - Labels: 2-#6 CONT., 1/4 LOOSE CK LINTEL.
- Other Notes:**
  - JOIST (at the top right).
  - B/BEAM ELEV. 109'-4" (at the bottom right).
  - EMBED PL 3/8x2'-7 1/4"xCONT. w/3 ROWS OF 1/2"x6" LONG HD STUDS @ 16" O.C. (at the bottom left).

HAFFER  
architects • designers • engineers

PR-1S13

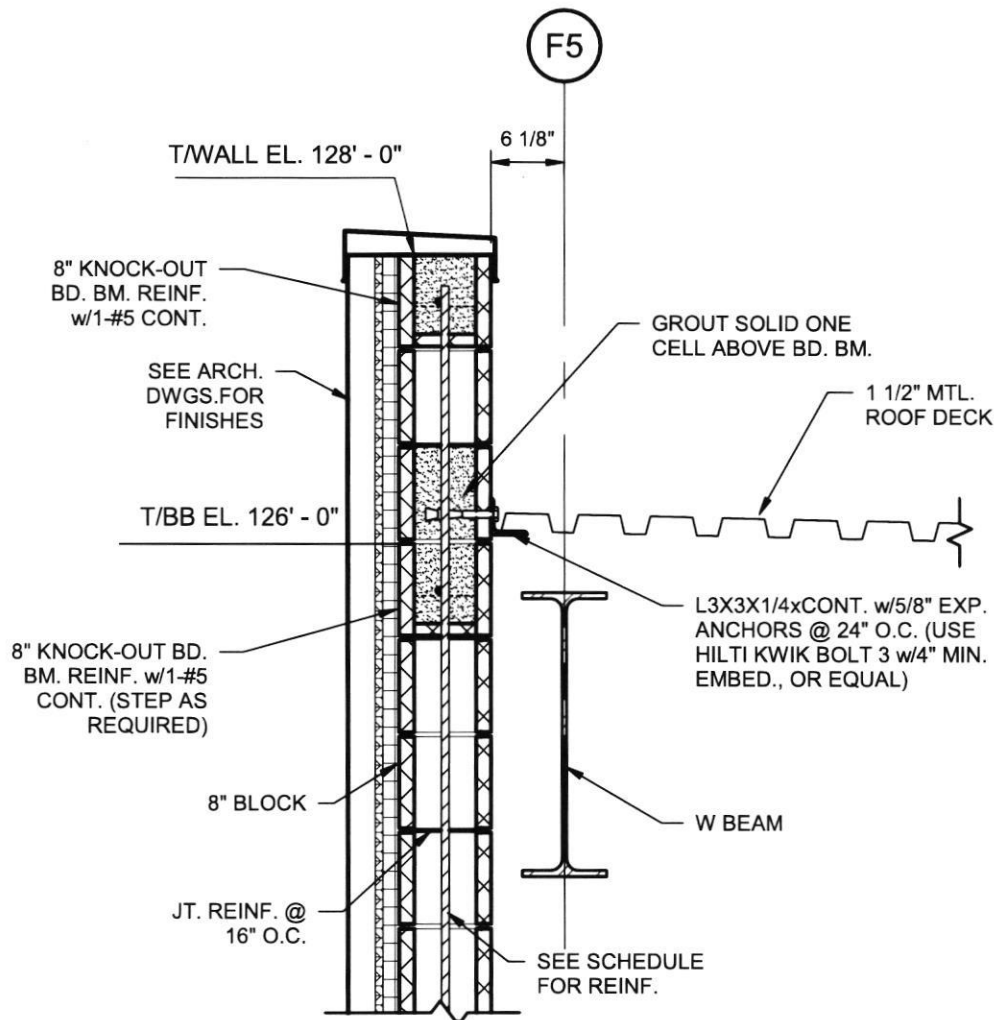

# 1 DECK CONNECTION TO WALL

SCALE: 3/4" = 1'-0"

HOPKINSVILLE - CHRISTIAN  
COUNTY ACADEMY

KDE # : BG 22-104

5185 FT. CAMPBELL BLVD  
HOPKINSVILLE, KY 42240

**HAFER**  
architects • designers • engineers

21 SE Third Street,  
Suite 800  
Evansville, IN 47708

T: 812.422.4187  
F: 812.421.6776  
www.hafersdesign.com

ARCHITECTS PROJECT NO.

2106-204

DATE:


10/13/23

TYPE OF DRAWING NO.

PR-1S14



AT CONTRACTOR'S OPTION, HOOKED  
DOWELS MAY BE REPLACED w/STRAIGHT  
DOWELS SECURED TO THICKENED SLAB  
w/HILTI HIT-HY 200 ADHESIVE w/6" EMBED.

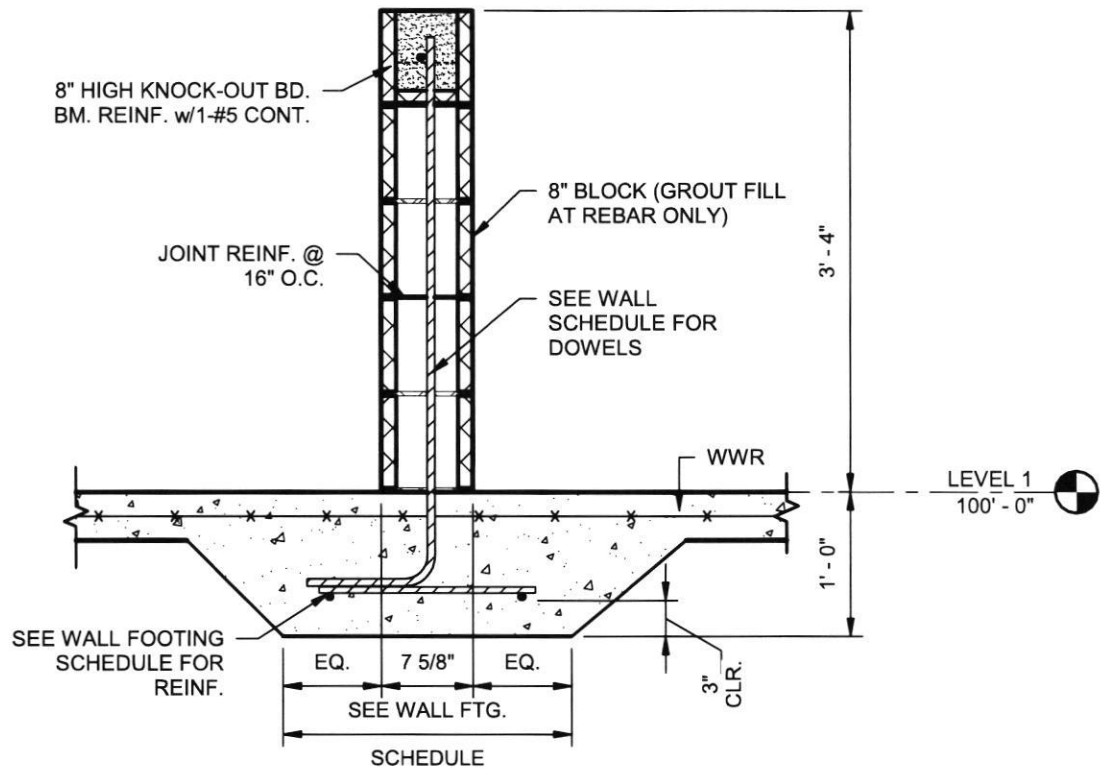

**1 THICKENED SLAB AT CMU**  
SCALE: 3/4" = 1'-0"

5185 FT. CAMPBELL BLVD  
HOPKINSVILLE, KY 42240

**HAFFER**  
architects • designers • engineers


T: 812.422.4187  
F: 812.421.6776  
[www.haferdesign.com](http://www.haferdesign.com)

2106-204

DATE:  
**10/13/23**

TYPE OF DRAWING NO.

PR-1S15

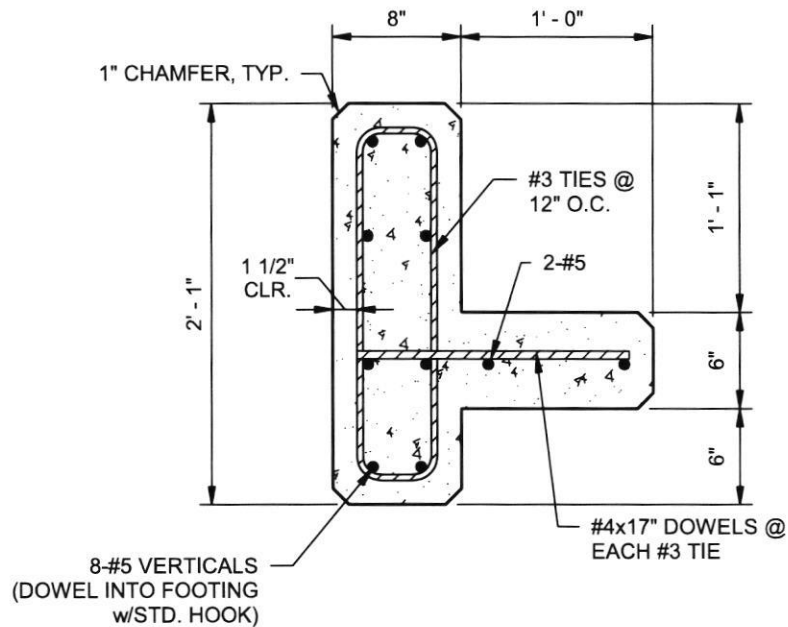

# 1 CONCRETE COLUMN

SCALE: 1" = 1'-0"

HOPKINSVILLE - CHRISTIAN  
COUNTY ACADEMY

KDE # : BG 22-104

5185 FT. CAMPBELL BLVD  
HOPKINSVILLE, KY 42240

**HAFER**  
architects • designers • engineers

21 SE Third Street,  
Suite 800  
Evansville, IN 47708

T: 812.422.4187  
F: 812.421.6776  
www.haferdesign.com

ARCHITECTS PROJECT NO.

**2106-204**


DATE:


**10/13/23**

TYPE OF DRAWING NO.

**PR-1S16**

TEMPERATURE CONTROL SYSTEM LTG CTRL RELAY PANEL SCHEDULE			
Panel ID:	LIGHTING CONTROL RELAY PANEL "TCRP11C"		
Location:	AREA "C" ELEC ROOM B190		
Surface/Flush:	SURFACE MOUNT		
Ctrl Pwr Circuit:	PANEL "EH11C" CIRCUIT NO. 12		
Description of Loads:	(BUILDING INTERIOR COMMON AREAS LTG)		
Relay #	Circuit	Description	Ltg Ctrl Requirements
1	H11C-6	ZONE "z" - 2ND FLR AREA "C" CORRIDOR	(SEE NOTES 1 & 2)
2	H11C-12	ZONE "y" - 1ST FLR AREA "C" RESTROOM	
3	H11C-12	ZONE "x" - 1ST FLR AREA "C" RESTROOM	
4	H11C-10	ZONE "w" - 1ST FLR AREA "C" CORRIDOR	(SEE NOTES 1 & 2)
5	H11C-20	ZONE "t" - 1ST FLR AREA "C" CORRIDOR	(SEE NOTES 1 & 2)
6	H11C-7	ZONE "s" - 1ST FLR AREA "C" CORRIDOR	(SEE NOTES 1 & 2)
7	H11C-11	ZONE "r" - 1ST FLR AREA "C" CORRIDOR	(SEE NOTES 1 & 2)
8	H11C-14	ZONE "q" - 1ST FLR AREA "C" CORRIDOR	(SEE NOTES 1 & 2)
9	H11C-16	ZONE "p" - 1ST FLR AREA "C" CORRIDOR	(SEE NOTES 1 & 2)
10	EH11C-10	ZONE "a" - EXTERIOR LIGHTING	(SEE NOTE 3)
11	EH11C-10	ZONE "b" - EXTERIOR LIGHTING	(SEE NOTE 4)
12	H11C-22	EXTERIOR LTG - CANOPY (D-O-E-O)	(SEE NOTE 4)
13	EH11C-16	EXTERIOR LTG - CANOPY (D-T-D)	(SEE NOTE 3)
14	EH11C-19	ZONE "c" - EXTERIOR LIGHTING	(SEE NOTE 3)
15	EH11C-19	ZONE "d" - EXTERIOR LIGHTING	(SEE NOTE 4)
16	___	SPARE	
17	___	SPARE	
18	___	SPARE	
<p><b>NOTES:</b></p> <p>1. LIGHTING ZONE SHALL BE CONTROLLED AS FOLLOWS: LIGHTING SHALL BE TURNED "ON" AND HELD "ON" DURING NORMAL BUSINESS TIME PERIODS. DURING AFTER NORMAL BUSINESS HOURS TIME PERIODS, THE LIGHTING SHALL BE CONTROLLED VIA OCCUPANCY SENSORS WITHIN THE ASSOCIATED ZONE SPACE. ON DETECTION OF OCCUPANCY, THE LIGHTING FIXTURES IN THE ASSOCIATED ZONE SHALL BE TURNED "ON" FOR A TIME PERIOD OF 15 MINUTES. AFTER 15 MINUTES OF LACK-OF-DETECTION-OF-OCCUPANCY, THE LIGHTING FIXTURES SHALL BE TURNED "OFF".</p> <p>2. CONTRACTOR SHALL COORDINATE THE NORMAL BUSINESS HOURS WITH THE OWNER AND THE OWNER'S TENANT PRIOR TO START OF PROGRAMMING.</p> <p>3. DUSK-TO-DAWN CONTROL VIA PHOTOCELL. PROVIDE OCCUPANCY SENSOR ON BUILDING EXTERIOR (NORTH SIDE) AWAY FROM ALL SOURCES OF DIRECT ILLUMINATION.</p> <p>4. DUSK "ON" - EARLY "OFF" CONTROL VIA PHOTOCELL SENSOR AND TIMECLOCK. PROVIDE PHOTOCELL CONTROL DEVICE ON BUILDING EXTERIOR (NORTH SIDE) AWAY FROM ALL SOURCES OF DIRECT ILLUMINATION.</p>			


ARCHITECT'S PROJECT NO. <b>2106-204</b>	DATE: <b>10/13/23</b>
	TYPE OF DRAWING NO. <b>PR-1E1</b>
21 SE Third Street, Suite 800 Evansville, IN 47708 T: 812 422 4187 F: 812 421 6776 www.hafedesign.com	
	
HOPKINSVILLE - CHRISTIAN COUNTY ACADEMY KDE # : BG 22-104 5185 FT. CAMPBELL BLVD HOPKINSVILLE, KY 42240	

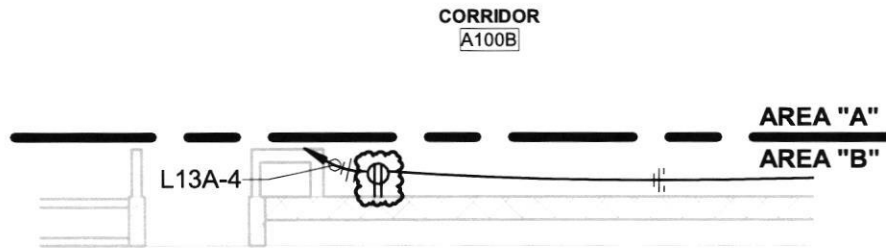

# POWER PLAN - FIRST FLOOR - AREA "B"

ORIGINAL DETAIL 2 / E2.1B

1/8" = 1'-0"

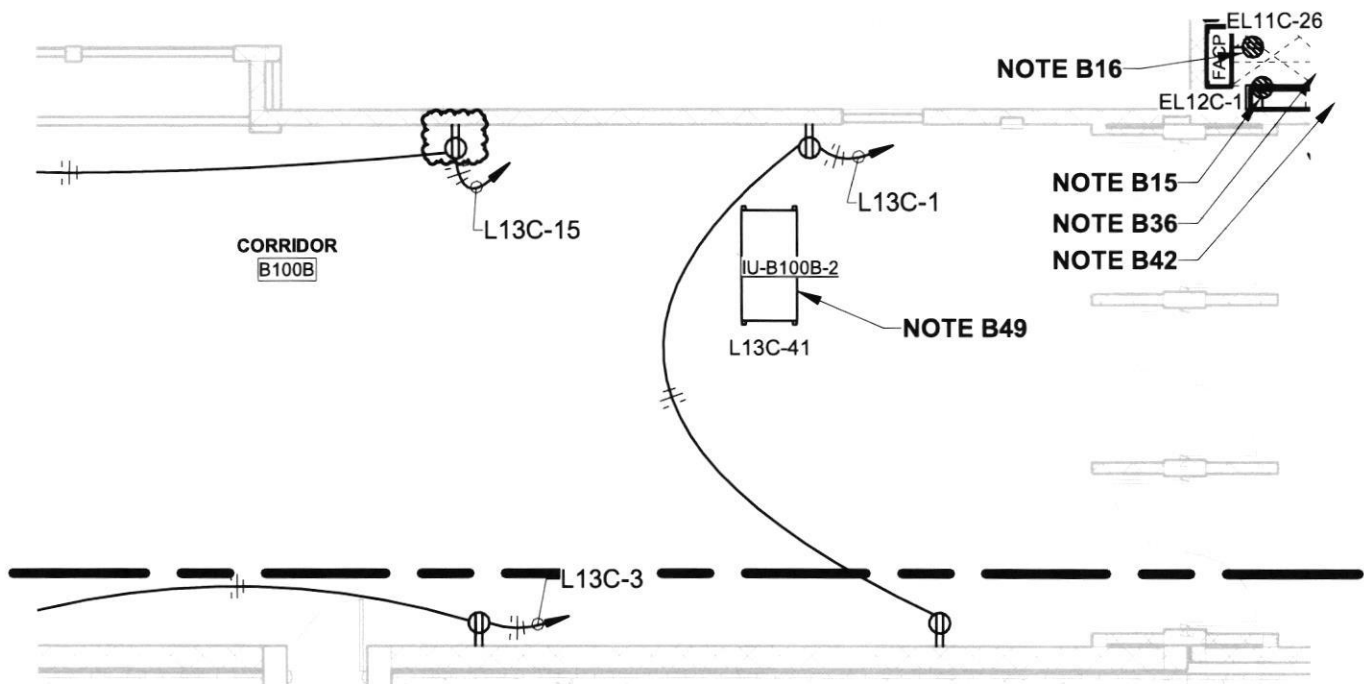

# POWER PLAN - FIRST FLOOR - AREA "B"

ORIGINAL DETAIL 2 / E2.1B

1/8" = 1'-0"

HOPKINSVILLE - CHRISTIAN  
COUNTY ACADEMY

KDE #: BG 22-104

5185 FT. CAMPBELL BLVD  
HOPKINSVILLE, KY 42240

**HAFER**

architects • designers • engineers

21 SE Third Street,  
Suite 800  
Evansville, IN 47708

T: 812.422.4187  
F: 812.421.6776  
www.haferdesign.com

ARCHITECTS PROJECT NO.


**2106-204**

DATE:

**10/13/23**

TYPE OF DRAWING NO.


**PR-1E2**

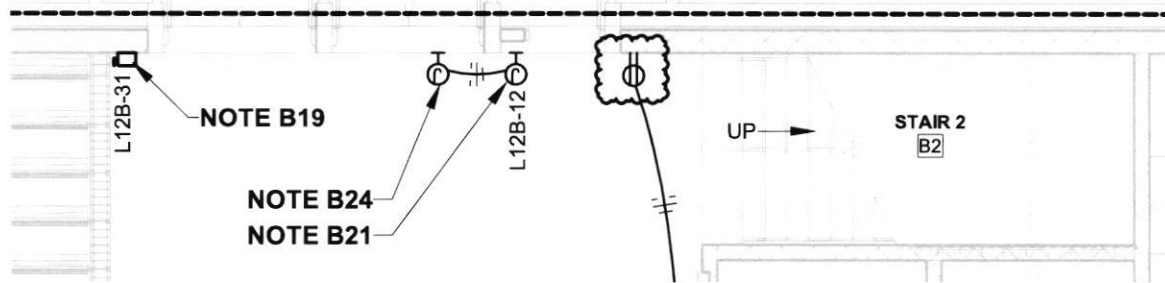

## POWER PLAN - FIRST FLOOR - AREA "B" ALT

ORIGINAL DETAIL 1 / E2.1B-Alt

1/8" = 1'-0"

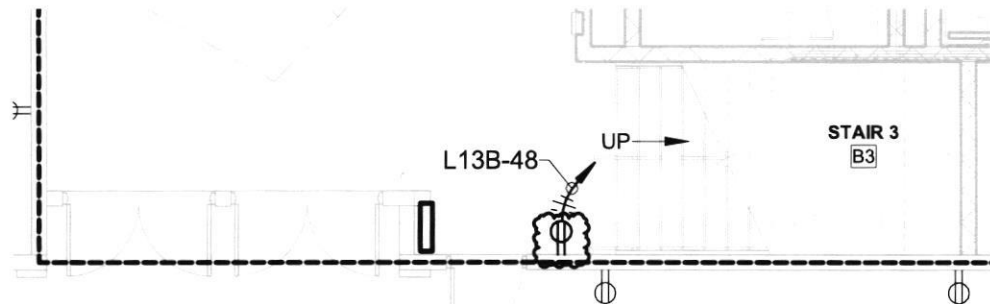

## POWER PLAN - FIRST FLOOR - AREA "B" ALT

ORIGINAL DETAIL 1 / E2.1B-Alt

1/8" = 1'-0"

HOPKINSVILLE - CHRISTIAN  
COUNTY ACADEMY

KDE # : BG 22-104

5185 FT. CAMPBELL BLVD  
HOPKINSVILLE, KY 42240

**HAFER**  
architects • designers • engineers

21 SE Third Street,  
Suite 800  
Evansville, IN 47708

T: 812.422.4187  
F: 812.421.6776  
www.haferdesign.com

ARCHITECTS PROJECT NO.


**2106-204**

DATE:

**10/13/23**

TYPE OF DRAWING NO.

**PR-1E3**

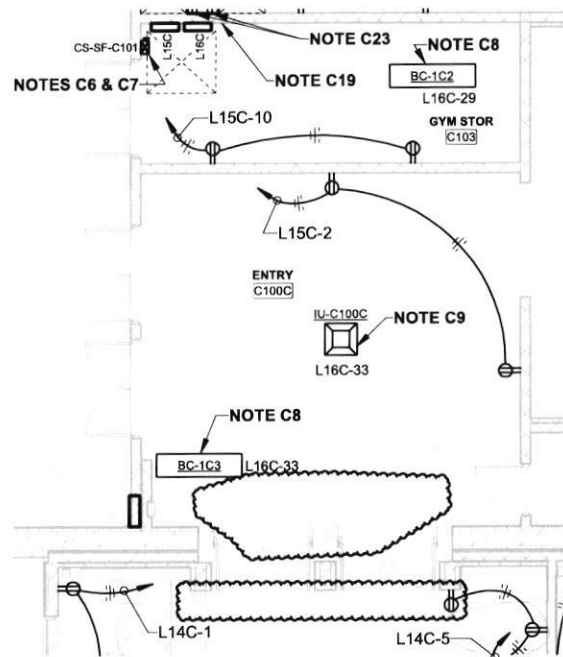

## POWER PLAN - FIRST FLOOR AREA "C"

ORIGINAL DETAIL 2 / E2.1C

1/8" = 1'-0"

### NOTES (FIRST FLOOR POWER PLAN - AREA "C") [CONT]:

C9. PROVIDE 30A/2 FUSIBLE SAFETY DISCONNECT SWITCH NEAR HVAC UNIT WITHIN THE ACCESSIBLE CEILING CAVITY SPACE. PROVIDE POWER CIRCUIT TO HVAC UNIT (THROUGH DISCONNECT SWITCH) PER THE MANUFACTURER'S REQUIREMENTS. PROVIDE POWER CIRCUIT FROM PANEL AND BRANCH CIRCUIT NO. AS INDICATED USING 2#12, 1#12G IN 3/4"C. PROVIDE FUSING PER THE EQUIPMENT MANUFACTURER'S REQUIREMENTS. COORDINATE REQUIRED INSTALLATION LOCATION IN FIELD WITH THE HVAC UNIT REQUIREMENTS AND ALL OTHER INSTALLATION WITHIN THE AREA.

C10. SEE FIRST FLOOR SYSTEMS & TECHNOLOGY PLAN - AREA "C", SHEET E3.1C, FOR ADDITIONAL REQUIREMENTS.

C11. RECEPTACLE FOR POWER TO AUDIO/VIDEO CONTROL CABINET. COORDINATE THE REQUIRED INSTALLATION LOCATION AND MOUNTING HEIGHT WITH THE INSTALLATION REQUIREMENTS OF THE AUDIO/VIDEO CONTROL CABINET. SEE TYPICAL INSTRUCTOR'S A/V ACCESS CABINET LOCATION ELECTRICAL REQUIREMENT DETAIL, SHEET E1.9, FOR ADDITIONAL REQUIREMENTS.

C12. COORDINATE THE REQUIRED INSTALLATION LOCATIONS AND MOUNTING HEIGHT OF ALL INSTALLATION ALONG THIS WALL WITH THE ARCHITECT PRIOR TO START OF ROUGH-IN.

C13. NOTE NOT USED.

C14. PROVIDE #10AWG CONDUCTORS FOR ALL "PHASE", "NEUTRAL" AND EQUIPMENT GROUND CONDUCTORS FOR ENTIRE LENGTH OF BRANCH CIRCUIT.

C15. PROVIDE POWER CIRCUIT TO THE ISOLATED GROUND TYPE DUPLEX RECEPTACLE WITHIN THE FLOOR BOX FROM PANEL "L15C" CIRCUIT NO. 29 USING 2#12, 1#12G, 1#12(IG) CONDUCTORS WITHIN A DEDICATED 3/4" CONDUIT FROM PANEL TO THE FLOOR BOX.

HOPKINSVILLE - CHRISTIAN  
COUNTY ACADEMY

KDE #: BG 22-104


5185 FT. CAMPBELL BLVD  
HOPKINSVILLE, KY 42240

**HAFFER**  
architects • designers • engineers  
21 SE Third Street,  
Suite 800  
Evansville, IN 47708  
T: 812.422.4187  
F: 812.421.6776  
www.hafferdesign.com

ARCHITECTS PROJECT NO.  
**2106-204**

DATE:  
**10/13/23**

TYPE OF DRAWING NO.  
**PR-1E4**

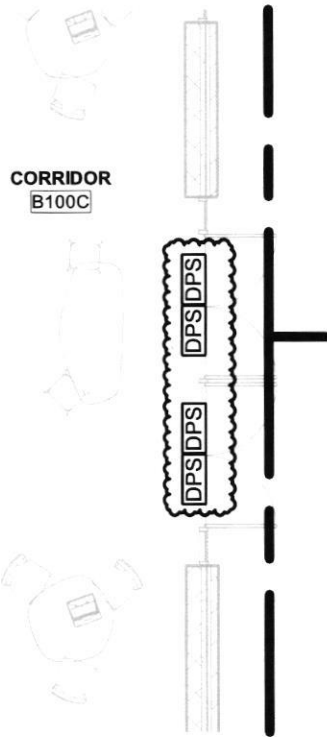

# SYSTEMS & TECHNOLOGY - FIRST FLOOR - AREA "B"

ORIGINAL DETAIL 2 / E3.1B

1/8" = 1'-0"

HOPKINSVILLE - CHRISTIAN  
COUNTY ACADEMY

KDE # : BG 22-104

5185 FT. CAMPBELL BLVD  
HOPKINSVILLE, KY 42240

**HAFER**  
architects • designers • engineers

21 SE Third Street,  
Suite 800  
Evansville, IN 47708

T: 812.422.4187  
F: 812.421.6776  
[www.haferdesign.com](http://www.haferdesign.com)

ARCHITECTS PROJECT NO.


**2106-204**

DATE:

**10/13/23**

TYPE OF DRAWING NO.


**PR-1E5**

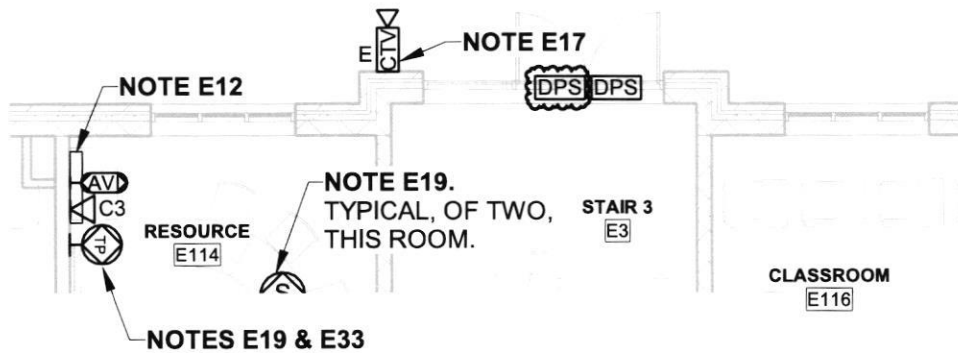

# SYSTEMS & TECHNOLOGY - FIRST FLOOR - AREA "E"

ORIGINAL DETAIL 2 / E3.1E

1/8" = 1'-0"

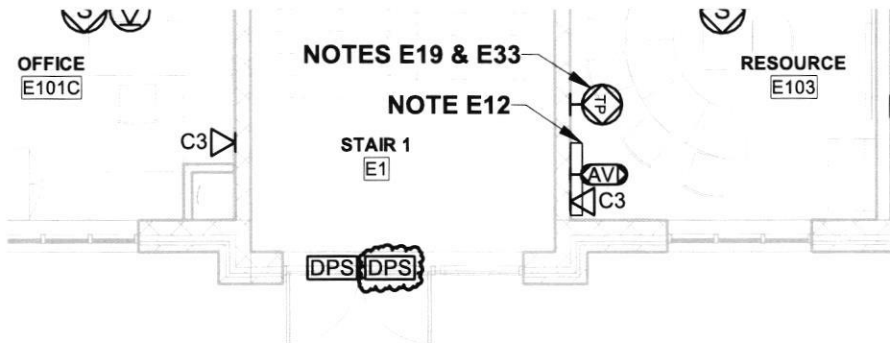

# SYSTEMS & TECHNOLOGY - FIRST FLOOR - AREA "E"

ORIGINAL DETAIL 2 / E3.1E

1/8" = 1'-0"

HOPKINSVILLE - CHRISTIAN  
COUNTY ACADEMY

KDE # : BG 22-104

5185 FT. CAMPBELL BLVD  
HOPKINSVILLE, KY 42240

**HAFER**  
architects • designers • engineers

21 SE Third Street,  
Suite 800  
Evansville, IN 47708

T: 812.422.4187  
F: 812.421.6776  
www.hafersdesign.com


ARCHITECTS PROJECT NO.  
**2106-204**

DATE:  
**10/13/23**

TYPE OF DRAWING NO.

**PR-1E6**



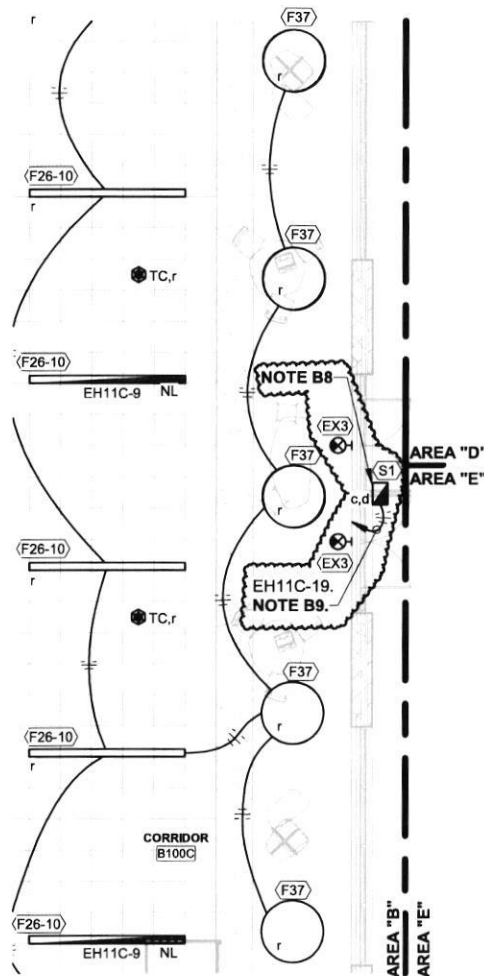

## NOTES (LIGHTING PLAN - FIRST FLOOR - AREA "B") [CONTINUED]:

B8. PROVIDE BOTH "DUSK-TO-DAWN" AND "DUSK-ON-EARLY-OFF" TYPE CONTROL CIRCUITS TO THIS FIXTURE.

B9. CONNECT TO BRANCH CIRCUIT AS INDICATED THRU LIGHTING CONTROL RELAY PANEL "TCRP11C". SEE LIGHTING CONTROL RELAY PANEL SCHEDULE, SHEET E1.12, FOR ADDITIONAL REQUIREMENTS.

## LIGHTING PLAN - FIRST FLOOR - AREA "B"

ORIGINAL DETAIL 1 / E4.1B

1/8" = 1'-0"


HOPKINSVILLE - CHRISTIAN  
COUNTY ACADEMY

KDE # : BG 22-104  
5185 FT. CAMPBELL BLVD  
HOPKINSVILLE, KY 42240

**HAFFER**  
architects • designers • engineers

21 SE Third Street,  
Suite 800  
Evansville, IN 47708  
T: 812.422.4187  
F: 812.421.6776  
www.hafferdesign.com


ARCHITECTS PROJECT NO. **2106-204** DATE: **10/13/23**  
TYPE OF DRAWING NO. **PR-1E7**

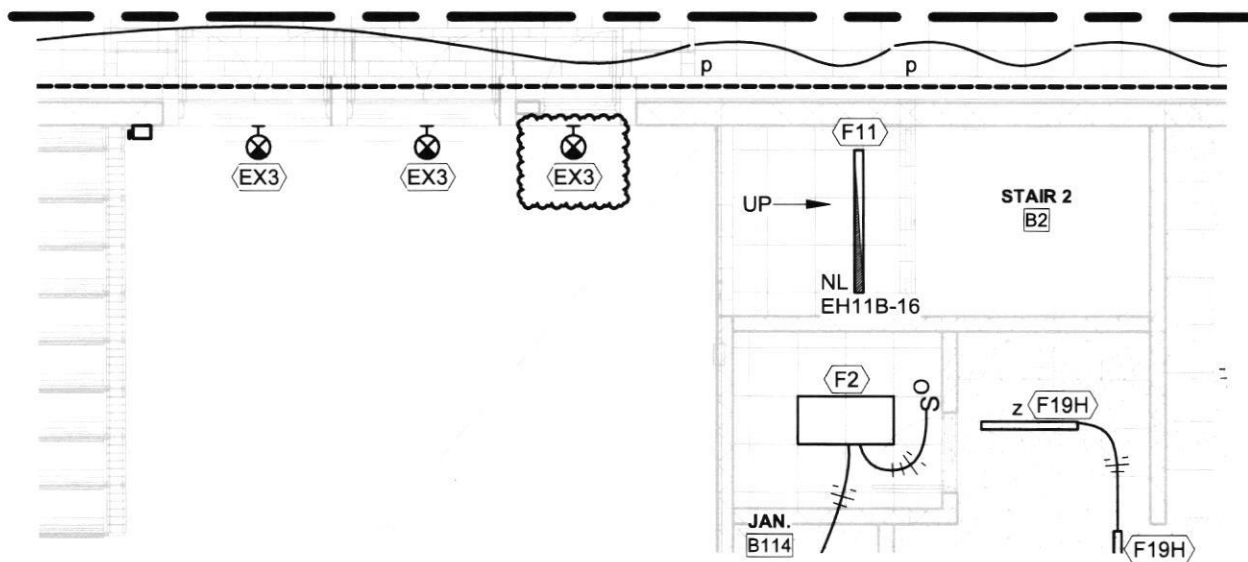

# LIGHTING PLAN - FIRST FLOOR AREA "B" ALT

ORIGINAL DETAIL 1 / E4.1B-Alt

1/8" = 1'-0"

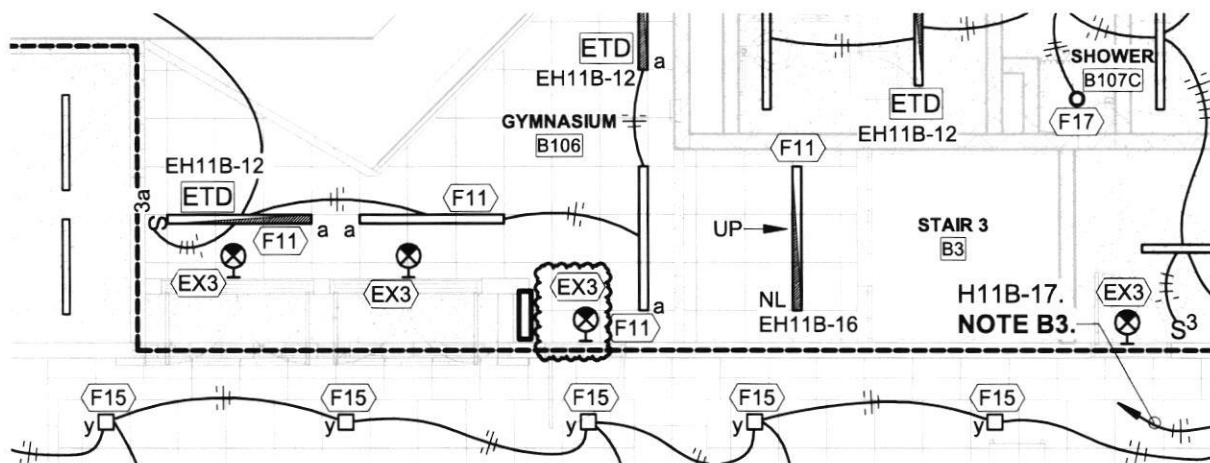

# LIGHTING PLAN - FIRST FLOOR AREA "B" ALT

ORIGINAL DETAIL 1 / E4.1B-Alt

1/8" = 1'-0"

HOPKINSVILLE - CHRISTIAN  
COUNTY ACADEMY

KDE #: BG 22-104

5185 FT. CAMPBELL BLVD  
HOPKINSVILLE, KY 42240

**HAFER**  
architects • designers • engineers

21 SE Third Street,  
Suite 800  
Evansville, IN 47708

T: 812.422.4187  
F: 812.421.6776  
www.haferdesign.com

ARCHITECTS PROJECT NO.


**2106-204**

DATE:

**10/13/23**

TYPE OF DRAWING NO.

**PR-1E8**

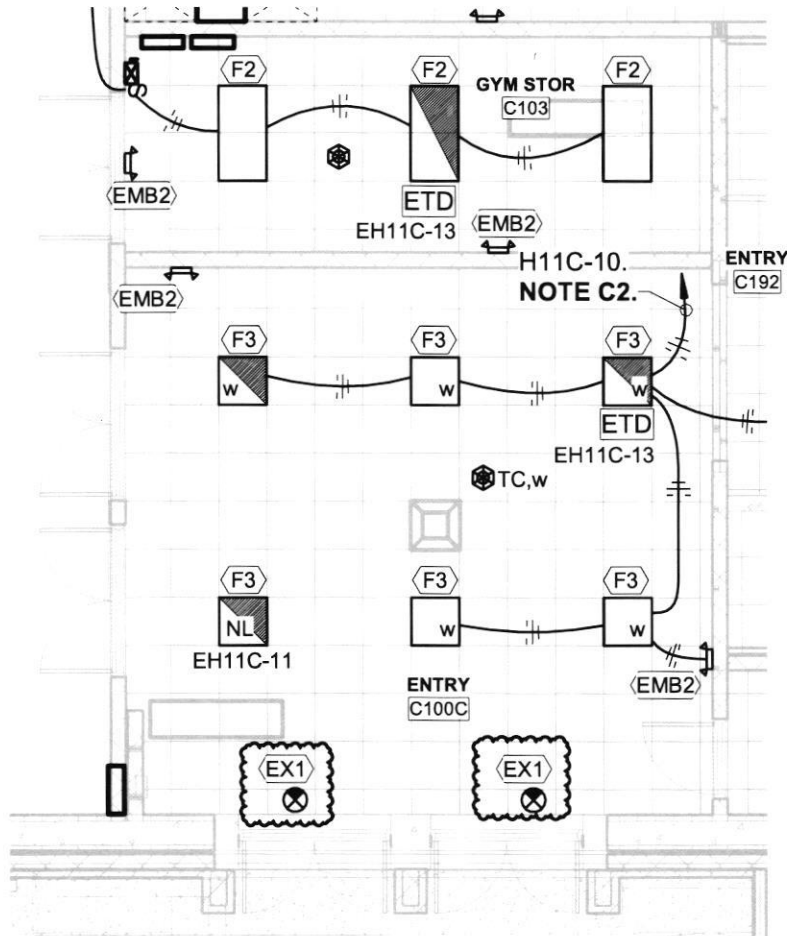

# LIGHTING PLAN - FIRST FLOOR AREA "C"

ORIGINAL DETAIL 1 / E4.1C

1/8" = 1'-0"

HOPKINSVILLE - CHRISTIAN  
COUNTY ACADEMY

KDE # : BG 22-104

5185 FT. CAMPBELL BLVD  
HOPKINSVILLE, KY 42240

**HAFER**  
architects • designers • engineers

21 SE Third Street,  
Suite 800  
Evansville, IN 47708

T: 812.422.4187  
F: 812.421.6776  
www.haferdesign.com

ARCHITECTS PROJECT NO.


**2106-204**

DATE:

**10/13/23**


TYPE OF DRAWING NO.

**PR-1E9**

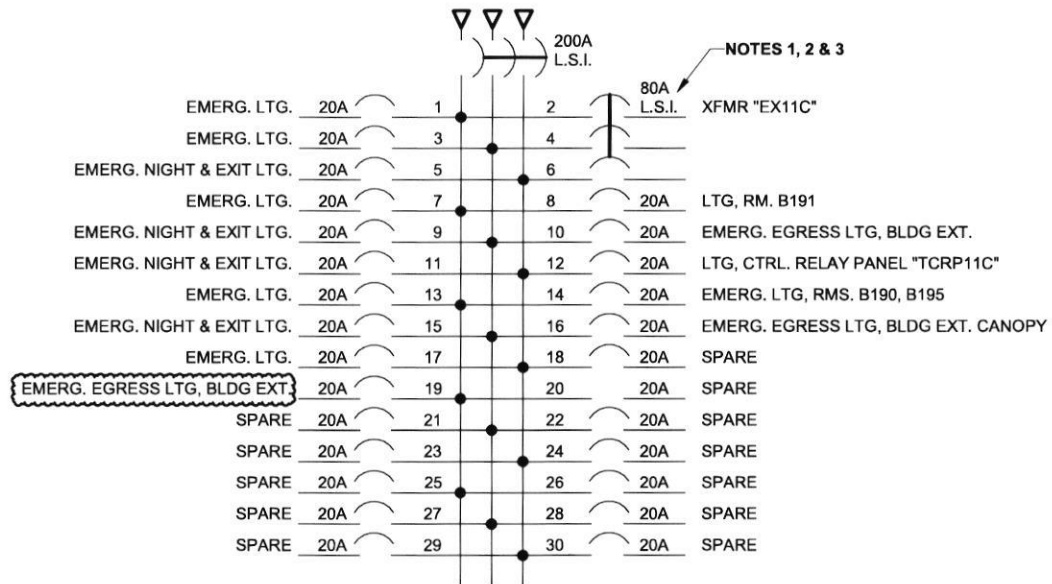



### PANEL "EH11C" [NEC700]

200A, 480Y/277V, 3PH, 4W  
 SURFACE MOUNT  
 30 SPACE  
 18,000 A.I.C.  
 PROVIDE WITH HINGED COVER ENCLOSURE.

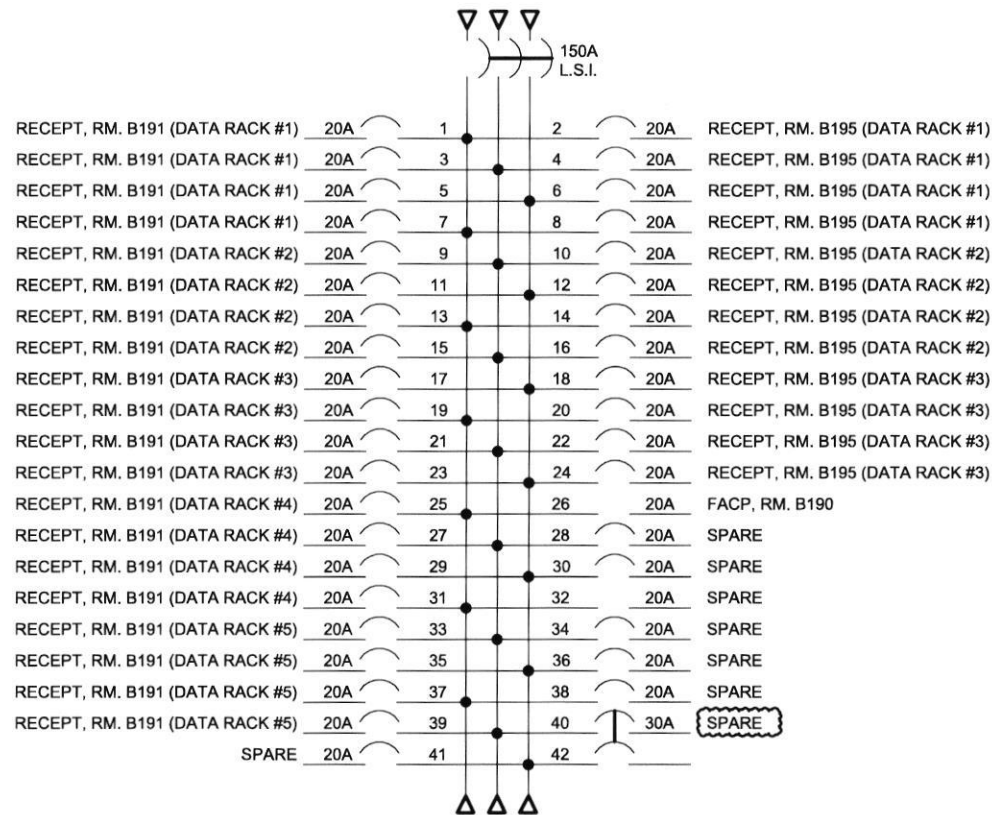

### PANEL "EL11C" [NEC700]

150A, 208Y/120V, 3PH, 4W  
 SURFACE MOUNT  
 42 SPACE  
 10,000 A.I.C.  
 PROVIDE WITH HINGED COVER ENCLOSURE.  
 PROVIDE WITH FEED-THRU LUGS.

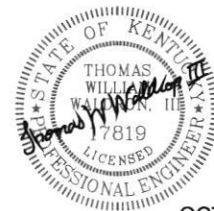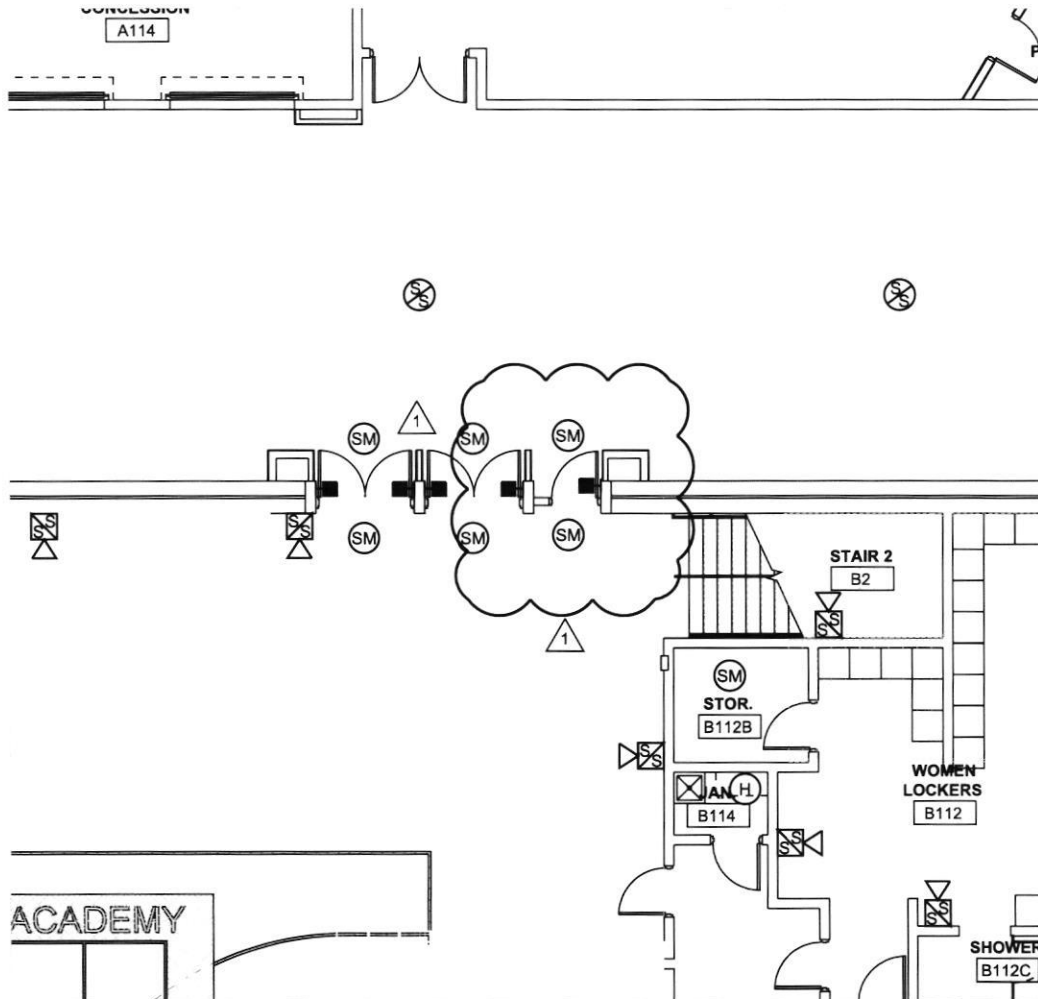

OCT, 2023

HOPKINSVILLE - CHRISTIAN  
COUNTY ACADEMY

KDE # : BG 22-104

5185 FT. CAMPBELL BLVD  
HOPKINSVILLE, KY 42240

**HAFER**  
architects designers engineers  
www.haferdesign.com



2155 Third Street  
Suite 800  
Evansville, IN 47708

T: 812 422 4187  
F: 812 421 6776  
www.haferdesign.com

ARCHITECTS PROJECT NO. DATE:  
**2106-201** **09/23/2023**

TYPE OF DRAWING NO.

**PR-1E12**

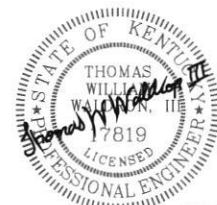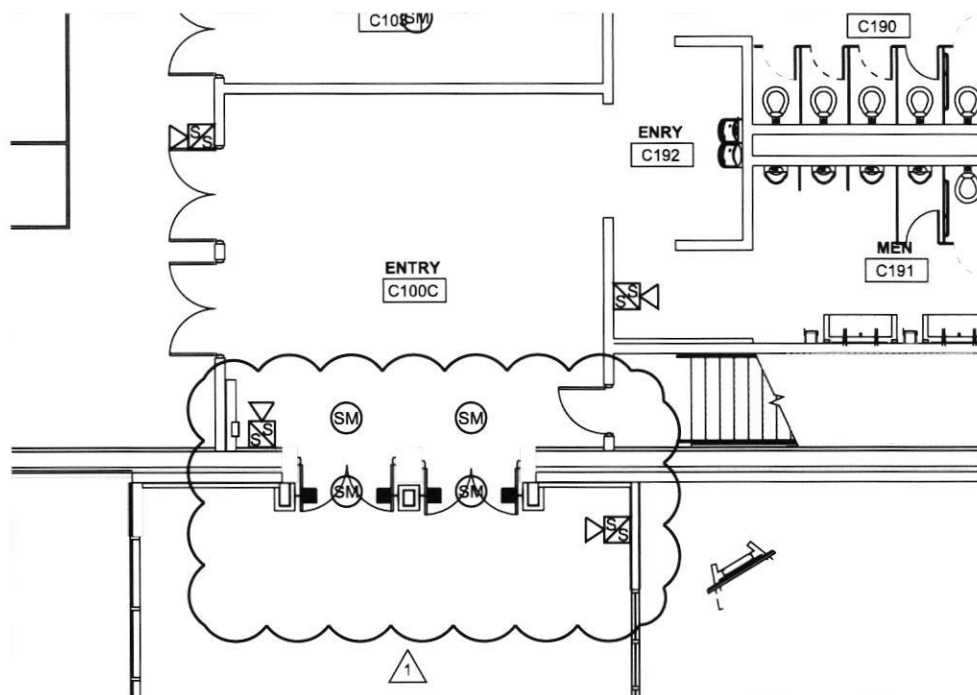

OCT, 2023

HOPKINSVILLE - CHRISTIAN  
COUNTY ACADEMY

KDE # : BG 22-104

5185 FT. CAMPBELL BLVD  
HOPKINSVILLE, KY 42240

**HAFER**  
architects • designers • engineers



21 SE Third Street,  
Suite 800  
Evansville, IN 47708

T 812.422.4187  
F 812.421.6776  
www.hafardesign.com

ARCHITECTS PROJECT NO. DATE:  
**2106-201** **09/23/2023**

TYPE OF DRAWING NO.

**PR-1E13**

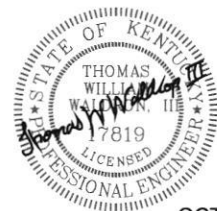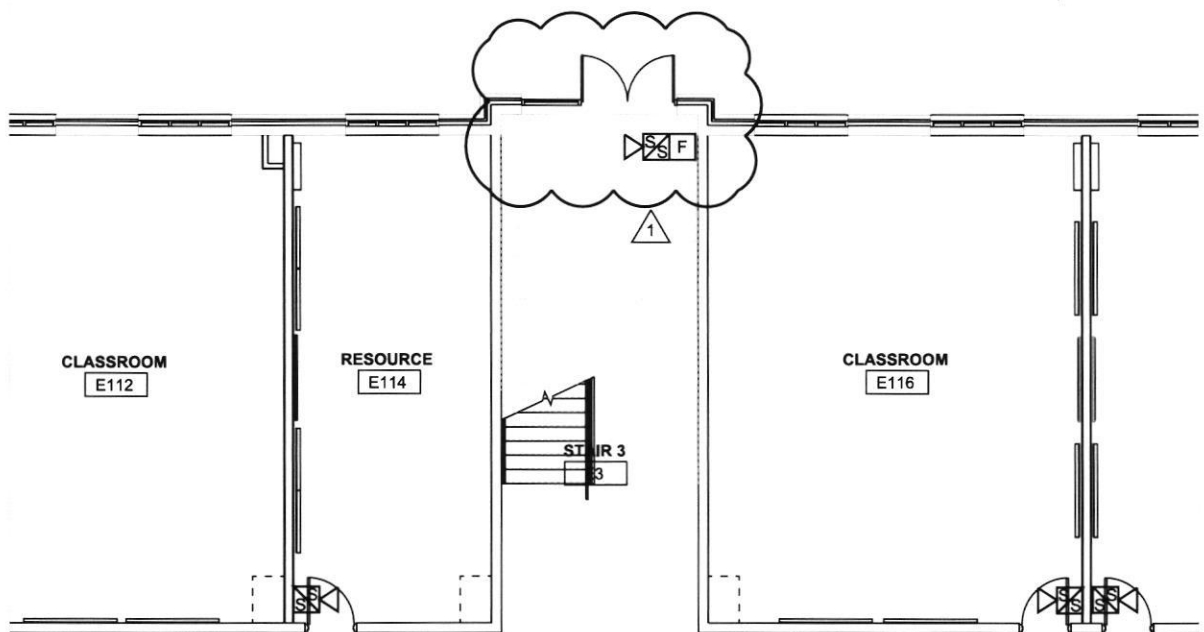

OCT, 2023

HOPKINSVILLE - CHRISTIAN  
COUNTY ACADEMY

KDE #: BG 22-104

5185 FT. CAMPBELL BLVD  
HOPKINSVILLE, KY 42240

**HAFER**  
architects designers engineers

2156 Third Street,  
Suite 800  
Evansville, IN 47708  
P: 812-422-6187  
F: 812-421-6776  
www.hafersdesign.com

ARCHITECTS PROJECT NO. DATE:



2106-201

09/23/2023

TYPE OF DRAWING NO.

**PR-1E14**



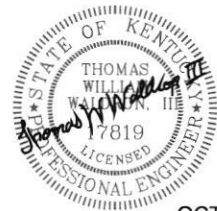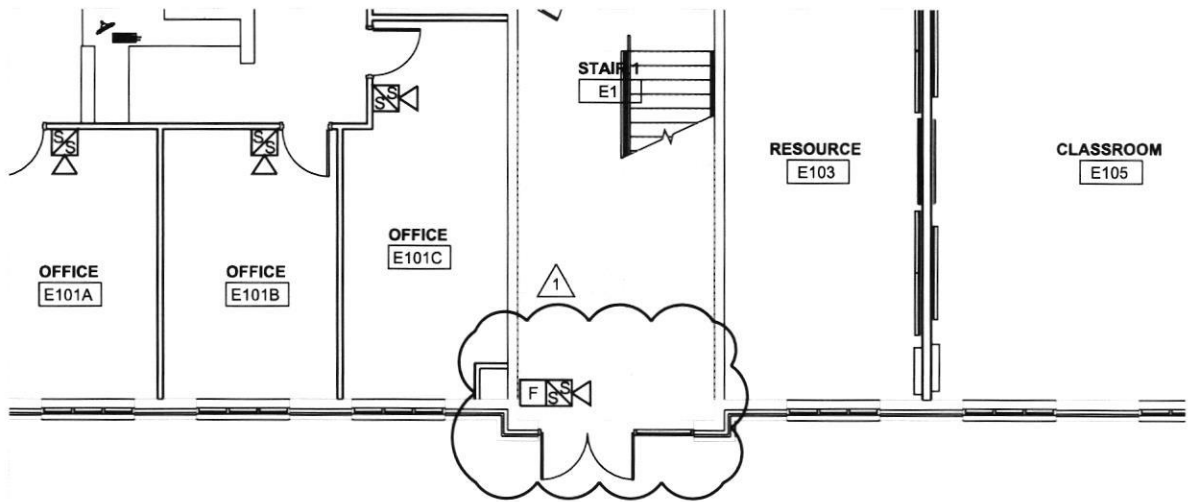

OCT, 2023

HOPKINSVILLE - CHRISTIAN  
COUNTY ACADEMY

KDE # : BG 22-104

5185 FT. CAMPBELL BLVD  
HOPKINSVILLE, KY 42240

HAFER  
architects designers engineers

215 Third Street,  
Suite 800  
Evansville, IN 47708

VT 812-422-4187  
IN 812-421-6776  
www.hafersdesign.com

ARCHITECTS PROJECT NO. DATE:  
2106-201 09/23/2023

TYPE OF DRAWING NO.

PR-1E15



140 college St.  
Crofton, KY 42217  
PH(270) 424-8242

CCHS  
Alliance Corporation  
RE: PR-001  
Adder

12/20/2023

Discription: PR-001 - ADDER Door changes

Item Discription:	Qty:	Unit:	Total:	Unit Hrs:	Total Hrs:	Labor Unit:	Total Labor:
Material	1	\$1,400.00	\$1,400.00		60	\$65.00	\$3,900.00
Added EX1, EX3, S1	1	1063	\$1,063.00		0	\$0.00	\$0.00
Pemier Fire door wire	1	5225	\$5,225.00		0	\$0.00	\$0.00
Truck cost	3.75	125	\$468.75		0	\$0.00	\$0.00
	0	0	\$0.00		0	\$0.00	\$0.00
	0	0	\$0.00		0	\$0.00	\$0.00
Material Cost		\$8,156.75
Sales Tax	6.0%	\$489.41
Material Subtotal		\$8,646.16

Labor Cost		\$3,900.00
Labor Burden 26%	26%	\$1,014.00
Labor Subtotal		\$4,914.00

Labor/Mat. Subtotal		\$13,560.16
Overhead/Profit	15%	\$2,034.02
Total Change Cost		\$15,594.18



1251 North 6<sup>th</sup> St  
Paducah KY 42001

(270) 443-7060

P O Box 1037  
Paducah, KY 42002

December 13, 2023

To: State Electric

Re: Christian Co. Academy – PR001 Change Order

**Premier Fire & Security, Inc.** proposes the following systems:

- Access Control Wiring: To furnish Belden Composite Access Control Cabling and installation labor for the installation of the Composite Access Control Cabling for (4) new Door Position Switch locations per the PR001 documentation. All access control equipment and door hardware to be provided by others. All 120vac circuits, conduit and back boxes to be provided by the EC. All final start-up and certification documents/testing will be provided. All shop/as-built drawings and project management will also be provided.

<b>Material:</b>	<b>\$ 3,300.00</b>
<b>Labor:</b>	<b>\$ 1,925.00</b>
<b>Total Price:</b>	<b>\$ 5,225.00</b>

Exclusions:

- Any conduit, back boxes, t-bars or flex for the above systems
- 120vac Power for the equipment
- Access Control Equipment
- Door Position Switches
- Fire Stopping/Proofing
- Duct Banks / Underground Conduit
- Any digging / excavating
- Grounding / Bonding
- Any other systems other than shown above

**Notes:**

- 1) Dedicated 120VAC circuits for the Fire Alarm Control Panels shall be provided by the EC.
- 2) All work to be performed during normal business hours, Monday through Friday, 7am to 4pm.

---

[www.premierfire.net](http://www.premierfire.net)

Fire Sprinklers • Fire & Security Alarms • Fire Extinguishers • Special Hazards Systems • Data/Voice • Monitoring  
Paducah, KY • Charleston, SC • Effingham, IL • Cape Girardeau, MO

- 3) All necessary pathways (conduits, flex, t-bars, sleeves) and boxes for the installation of the above described systems shall be provided and installed by the EC.
- 4) 120VAC Electrical and Surge Protection for the above described systems shall be provided and installed by the EC.
- 5) All new equipment and labor to have a 1-Year warranty excluding abuse and acts of nature.
- 6) Files will need to be provided in CAD format for the design of the above systems.
- 7) Price does not include the cost of any COVID testing, vaccination mandates, or other COVID related impacts not outlined in the solicitation/bid documents or mandated as of the date of the proposal.
- 8) Price valid for 30 days from the date of the proposal.

Sincerely,

Todd Sexton  
Premier Fire & Security



# Quote

**Job Name:** Christian County Academy -  
Hopkinsville  
**Quote #:** 22-79165-17  
**Quote Label:** PR001  
**Job Location:** Hopkinsville, Kentucky  
**Issue Date:** 12/14/2023  
**Good Through:** 3/10/2024  
**Quoted By:** Wingo, Joe



**John Aebersold**

*Lighting Quotations*

m: 502.744.7165 t: 812.738.3232 e: [johnaebersold@eckart.com](mailto:johnaebersold@eckart.com)

ECKART SUPPLY | 1815 PLANTSIDE DR. LOUISVILLE, KY 40299

[www.eckartsupply.com](http://www.eckartsupply.com)

Type	Qty	Manufacturer/Brand	Catalog #	Line Comment	Unit \$	Ext \$
EX1	2	ABL-Lithonia Lighting	EXRG EL M6			
EX3	4	ABL-Lithonia Lighting	EXRG EL M6			
S1	1	ABL-Lithonia Lighting	WSR LED P3 40K SR4 MVOLT BBW DS DDBXD			
FREIGHT NOT INCLUDED						

**Grand Total: \$1,063.00**

# FACPAC Contract Change Order Supplemental Information Form (Ref# 59444)

Form Status: Saved

Tier 1 Project: Consolidated High School

BG Number: 22-104

Status: Active

District: Christian County (HB678)

Phase: Project Initiation (View Checklist)

Contract: State Electric Co Inc. , 0260, Electrical

Type: CM Bid Package

Proposed

Change Order Number	2
Time Extension Required	No
Date Of Change Order	2/9/2024
Change Order Amount To Date	Increase

## Construction Contingency

Calculations below are project wide. Remaining negative Construction Contingency may require the submission of a revised BG1.

Current Approved Amount	\$6,320,436.60
Net Approved COs	\$0.00
Remaining After Approved COs	\$6,320,436.60
Net All COs	\$401,704.82
Remaining After All COs	\$5,918,731.78

This Requested Change Order Amount \$15,594.18

+/-

Change In A/E Fee This Change Order \$779.70

+/-

Change In CM Fee This Change Order \$0.00

+/-

Remaining Construction Contingency \$5,918,731.78

Balance

Contract Change Requested By Architect/Engineer

Contract Change Reason Code Expansion of Scope

Change Order Description And Justification

Access to control infrastructure, fire alarm, and electrical revisions per PR# 1.

Cost Benefit To Owner

The cost of this change order has been reviewed and determined to be reasonable.

Contract unit prices have been utilized No  
to support the cost associated with this  
change order.

Detailed Cost Breakdown

Contract unit prices have not been utilized, provide a detailed cost breakdown which separates labor, material, profit and overhead.

Detail Item	Amount	Percent of Total
Labor	\$4,914.00	31.51%
Materials	\$8,646.16	55.44%
Profit and Overhead	\$2,034.02	13.04%
Bond Insurance		0.00%
Cost Breakdown Total:	\$15,594.18	
Cost for this Change Order supported by an alternate bid or competitive price quote	No	
Explain Why		
Executed contract with contractor.		

## **Change Order Supplemental Information Form Signature Page (Online Form Ref# 59444)**

\_\_\_\_\_  
Architect

\_\_\_\_\_  
Date

\_\_\_\_\_  
Construction Manager

\_\_\_\_\_  
Date

\_\_\_\_\_  
Finance Officer

\_\_\_\_\_  
Date

\_\_\_\_\_  
Local Board of Education Designee

\_\_\_\_\_  
Date