LETTER OF TRANSMITTAL



DATEAugust 3, 2016JOB NAMECVESATTENTIONJohn StithJOB NUMBER1429TOHardin Co. SchoolsFROMTom Smith

| Sharman | Carter | Rarnhart | Architects |
|---------|--------|----------|------------|
| Snerman | Carter | Darmiari | WICHITECT2 |

2405 Harrodsburg Road, Lexington, KY 40504 859 224 1351 Office 859 224 8446 Fax scbarchitects.com

| WE ARE SENDING YOU | | | | |
|------------------------|---|---------------------------------------|---------------------------------|----------------------------|
| Attached | Under separate | cover via hand carried by Ju | ustin McElfresh the | e following items: |
| Shop drawings | ASI | Plans | Samples | Specs |
| Copy of letter | Change order | Contracts | Prop. Req. | Disk(s) |
| Other | | | | |
| Copies Date | No. | Description | | |
| . 1 | | Change Order No. 1 - Isaa | c Tatum with attachments | |
| | | | | |
| • | | · · · · · · · · · · · · · · · · · · · | | |
| | | | | |
| | | | | |
| THESE ARE TRANSMITT | ED AS CHECKED BELOW | , | | |
| For approval | For review and | comment Re | esubmit copies for approve | al |
| For your use | Approved as no | oted Re | esubmit copies for distribu | tion |
| As requested | Returned for co | rrections Re | esubmit corrected plans | - |
| (Other) | | | | |
| | enda and approval. Upo te for their review and a | | opy of Board Order to SCB and v | ve will post to KDE |
| | | | | |
| | | | | |
| | | | | |
| COPYTO: File 1429 B/CC |) (Efile Copy) | SI | GNED: Tom Smith | |
| a | | | Charman Cartar Barnbart Arc | hitacts 950 224 1351 Offic |



Change Order

| - · · · · · · · · · · · · · · · · · · · | | |
|--|--|--|
| PROJECT (Name and address): | CHANGE ORDER NUMBER: 001 | OWNER: |
| Cecilia Valley Elem School | DATE: August 1, 2016 | ARCHITECT: |
| Elizabethtown, KY TO CONTRACTOR (Name and address): | ARCHITECT'S PROJECT NUMBER: 1429 / BO | CONTRACTOR: |
| Isaac Tatum Construction, Inc. | CONTRACT DATE: May 27, 2016 | FIELD: |
| PO Box 665 85 Sulfur Springs Road Lebanon, KY 40033 | CONTRACT FOR: General Construction | OTHER: |
| THE CONTRACT IS CHANGED AS FOLLO (Include, where applicable, any undisputed Revisions to the entrance drive as per Prop | l amount attributable to previously executed C | Construction Change Directives) |
| The original Contract Sum was The net change by previously authorized C The Contract Sum prior to this Change Or The Contract Sum will be increased by this The new Contract Sum including this Chan | der was s Change Order in the amount of | \$ 10,904,515.00 \$ 0.00 \$ 10,904,515.00 \$ 3,765.00 \$ 10,908,280.00 |
| The Contract Time will be increased by Ze The date of Substantial Completion as of t | ero (0) days. he date of this Change Order therefore is | |
| been authorized by Construction Change I | changes in the Contract Sum, Contract Time of Directive until the cost and time have been agrees is executed to supersede the Construction Changes | eed upon by both the Owner and |
| NOT VALID UNTIL SIGNED BY THE | ARCHITECT, CONTRACTOR AND OWNE | R. |
| Sherman Carter Barnhart Architects PLLC | Isaac Tatum Construction, Inc. | Hardin County Schools |
| ARCHITECT (Firm name) | CONTRACTOR (Firm name) | OWNER (Firm name) |
| 2405 Harrodsburg Road, Lexington, KY 40504 | PO Box 665, 85 Sulfur Springs Road, Lebanon, KY 40033 | 65 W. A. Jenkins Rd Elizabethtown, KY 42701 |
| ADDRESS | ADDRESS | ADDRESS |
| BY (Signature) | BY (Signature) | BY (Signature) |
| Tom Smth, Project Manager (Typed name) | (Typed name) | (Typed name) |
| 1yped name) AU6. 2, 21/6 | DATE | DATE |

KENTUCKY DEPARTMENT OF EDUCATION 702 KAR 4:160

CHANGE ORDER SUPPLEMENTAL INFORMATION FORM

| BG #:13-017 Change Order No.:01 | |
|---|---|
| District | Facility |
| District: Hardin County Code: | Name: Celia Valley Elementary School Code: |
| Project_Cecilia Valley Elementary School Time Ex | tension Required: Yes No If yes, by day(s) |
| Date of Change Order: August 1, 2016 Change Or | der Amount: 🛛 Increase 🔲 Decrease 🗖 Unchanged |
| Contractor / Vendor Name:Isaac Tatum Construction_ | Bid Package No.: |
| This Requested Change Order Amount + / - | \$ 3,765.00 |
| 2. Remaining Construction Contingency Balance: (include | ding line 1 above) \$ |
| 3. Change in A/E Fee for this Change Order +/- | \$ 192.02 |
| 4. Change in CM Fee for this Change Order +/- | \$ |
| Note: Change Orders equal to or greater than \$25,000 | shall be submitted to KDE with detail cost breakdown. |
| Attach additional pages if necessary. | |
| Contract change requested by: Local Board of Educat | |
| ☐ Construction Manager ☐ Code Enforcement Off | icial 🛘 Other: |
| Contract change recease and | ☐ Eventagion of Spans ☐ Improved Plans/Spans |
| Contract change reason code: | ☐ Expansion of Scope ☐ Improved Plans/Specs ☐ Other: |
| - Odde Compilance | |
| Change Order Description and Justification: | Cost Benefit to Owner: |
| Revisions to entrance drive. | Price is fair and reasonable. |
| | |
| | |
| Have contract unit prices been utilized to support the cost a Yes No If no, provide a detailed cost breakdow | ssociated with this change order? /n which separates labor, material, profit and overhead. |
| Cost Breakdown Refer to attachment. | |
| | Materials Profit & Overhead* Bond & Insurance |
| \$3,765.00 \$ | \$ \$ |
| % of Total Change Order Amt.: % | % % |
| *Profit & Overhead shall not exceed 15% of net cost of chang | e order |
| Is the cost for this change order supported by an alternate | |
| Yes No If no, explain why | Architect's Signature Date |
| | Architect's Signature Date |
| Board of Education Designee's Signature Date | |
| $(\mathcal{A}_{\mathbf{k}}, \mathcal{A}_{\mathbf{k}}) = (\mathcal{A}_{\mathbf{k}}, \mathcal{A}_{\mathbf{k}}, \mathcal{A}_{\mathbf{k}})$ | |
| Finance Officer's Signature Date | Construction Manager's Signature Date |
| | |



P.O. Box 665 215 N. Depot St. Lebanon, KY 40033 Tel (270) 692-4045 Fax (270) 692-2324 www.isaactatumconstruction.com

July 27, 2016

SCB Architects
Attn: Jim Pearcy

Reference: CVES PR#2

UNIT PRICES

1000 CY's Mass Earth@\$3.19/CY

\$3,190.00

Additional Survey Mobilization

\$500.00

15% Profit & Overhead:

\$75.00

Total:

\$3,765.00

Thank you,

Isaac Tatum

Isaac Tatum Construction, Inc.



Work Changes Proposal Request

PROJECT (Name and address): Cecilia Valley Elem School Elizabethtown, KY

OWNER (Name and address): Hardin County Schools 65 W. A. Jenkins Rd Elizabethtown, KY 42701

FROM ARCHITECT (Name and address): Sherman Carter Barnhart Architects PLLC 2405 Harrodsburg Road Lexington, KY 40504

TO CONTRACTOR (Name and address): Isaac Tatum Construction, Inc. PO Box 665 85 Sulfur Springs Road Lebanon, KY 40033

PROPOSAL REQUEST NUMBER: 002 - REVISED

DATE OF ISSUANCE: July 18, 2016

CONTRACT FOR: General Construction

CONTRACT DATE: May 27, 2016

ARCHITECT'S PROJECT NUMBER: 1429 /

ARCHITECT: 🛛

OWNER: 🖂

CONSULTANT: 🛛

CONTRACTOR:

FIELD: File 1429X, CA Copy: X

BG 13-017

Please submit an itemized proposal for changes in the Contract Sum and Contract Time for proposed modifications to the Contract Documents described herein. Within ten (10) days, the Contractor must submit this proposal or notify the Architect, in writing, of the date on which proposal submission is anticipated.

THIS IS NOT A CHANGE ORDER, A CONSTRUCTION CHANGE DIRECTIVE OR A DIRECTION TO PROCEED WITH THE WORK DESCRIBED IN THE PROPOSED MODIFICATIONS.

DESCRIPTION (Insert a written description of the Work):

Please provide pricing including all labor and materials required to modify the bus entrance as shown on the attached PR#2 drawings SD1.2 and REVISED SD2.5 and SU3.1A.

Please provide separate break out pricing for all work in right of way including clearing, storm drainage and grading, paving, and signage.

Also REVISE the storm inlet structure at the southern entrance from a TYPE 3 inlet to a NEENAH R-3360 A to match the revised inlet at the north (bus) entrance as well.


ATTACHMENTS (List attached documents that support description):

Sheet SD1.2, SD2.1, STW Drawing SU3.1A Revised Drawing SD2.5


REQUESTED BY THE ARCHITECT:

Ben Sorrell, Landscape Architect (Printed name and title)


AIA Document G709 TM - 2001. Copyright © 1993 and 2001 by The American Institute of Architects. All rights reserved. WARNING: This AIA* Document is protected by U.S. Copyright Law and International Treaties. Unauthorized reproduction or distribution of this AIA* Document, or any portion of it, may result in sovere givil and oriminal panalties, and will be prosecuted to the maximum extent possible under the law. This document was produced by AIA software at 09:34:07 on 07/07/2016 under Order No.1661214750_1 which expires on 09/11/2016, and is not for resale. (2003073384) **User Notes:**

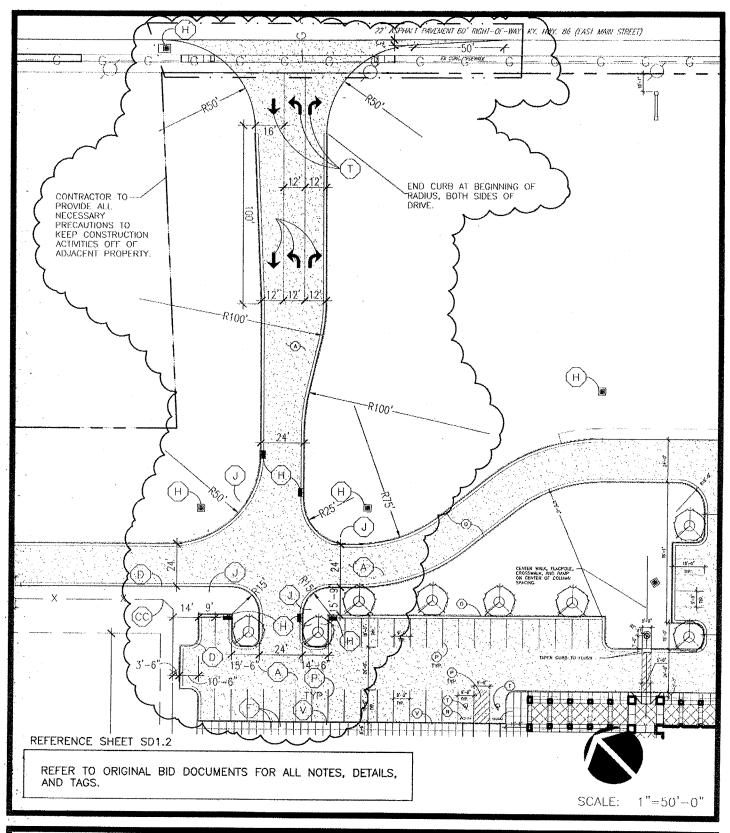

PROPOSAL REQUEST#2 DRAWING SD1.2 - SD1.2 REVISED SITE PLAN JOB NO. 1429 SHEET NO. SD1.2 SHERMAN CARTER BARNHART **COPYRIGHT © 2016 SHERMAN CARTER** PROJECT NAME **CECILIA VALLEY ELEMENTARY** DATE 7/6/16 BARNHART ARCHITECTS, PLLC PROJECT LOCATION HARDIN COUNTY, KENTUCKY DRAWN KP

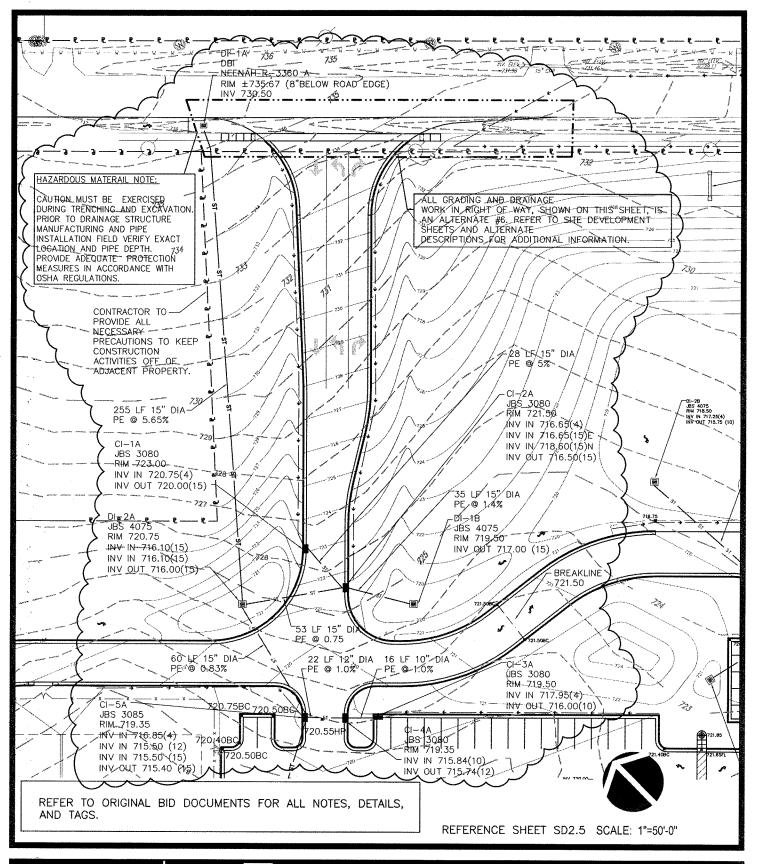

| PROPOSAL REQUEST: #2 DRAWING SD2.5 - SD2.5 REVISED GRADING/DRAINAGE | | | | | | |
|--|----------------|------------------|---------------------------|-------|---------|--|
| SHERMAN CARTER BARNHART ARCHITECTS COPYRIGHT © 2016 SHERMAN CARTER BARNHART ARCHITECTS, PLLC | JOB NO. | 1429 | SHEET NO. | SD2.1 | | |
| | SHERMAN CARTER | PROJECT NAME | CECILIA VALLEY ELEMENTARY | DATE | 7/18/16 | |
| | | PROJECT LOCATION | HARDIN COUNTY, KENTUCKY | DRAWN | KP | |

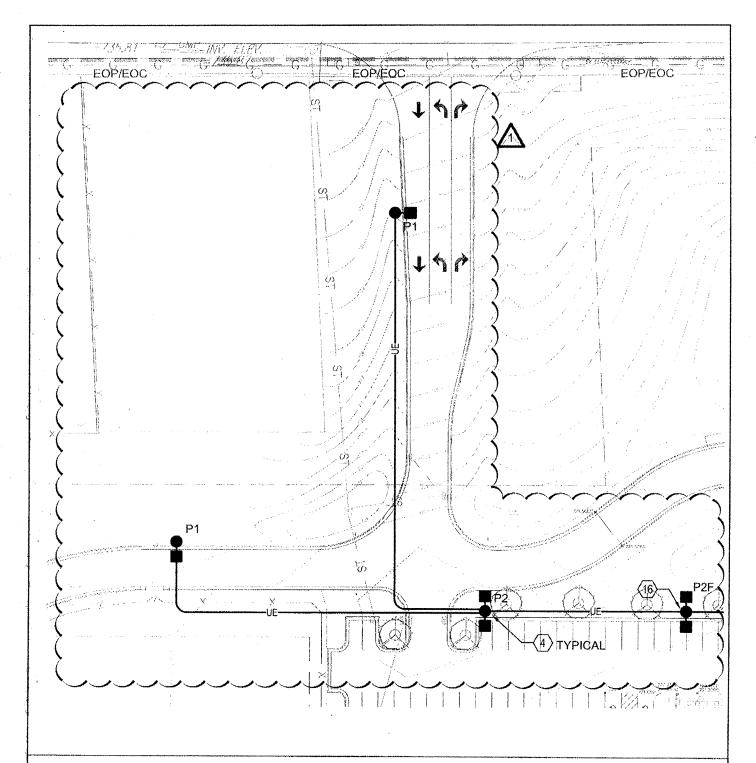

PARTIAL SITE UTILITIES PLAN - ELECTRICAL



Lexington - Louisville 628 Winchester Road Lexington, KY 40505 t: 859.277.8177 www.stweng.com

CECILIA VALLEY ELEMENTARY SCHOOL

KY HIGHWAY 86 (E. MAIN STREET) CECILIA, KY

| ISSUED FOR: | DRAWN BY: | CHECKED BY: | SCALE: | DATE: | SHEET: |
|-----------------|-----------|-------------|-------------|-----------|--------|
| PR#1 07.05.2016 | DE | DE | 1" = 50'-0" | 7/05/2016 | SU3.1A |