

WCHS Track and Field: Change Order #04 Summary

1.) Additional Requested Days

- (36 Days) PR 06 Bleachers- Musco lighting lead-time up to 12 weeks from approval.

Total Additional Days Requested: 36

Updated Substantial Completion Date: 2/10/2025

2.) PR #05 Electrical at Fence

Provide credit to delete conduit, wiring and devices for receptacles shown along fence.

02-04 Rising Sun Developing

- Total Cost Deduct: -(\$1,376.66)

Total Deduct: -(\$1,376.66)

3.) PR #06 Bleachers

Add 4" and 6" concrete, foundations, site drainage, and utilities for a future 2,485 person grandstand.

05-01 Olympic Construction

- Total Cost Add: \$306,035.70

Total Add: \$306,035.70

CO#04 Total Cost Add = \$304,659.04

| | | | |
|-------|---|-------|---|
| DATE: | 10/17/2024 | PR #: | PR 006 |
| TO: | Clay Ratliff – Trace Creek Construction | RE: | Woodford County Board of Education Versailles, Kentucky BG 19-353 RTA 1916 Phase 2 |

Please submit an itemized quotation for changes in the Contract Sum and/or Time incidental to proposed modifications to the Contract Documents described therein.

THIS IS NOT A CHANGE ORDER NOR A DIRECTION TO PROCEED WITH THE WORK DESCRIBED HEREIN.

Please provide labor and material pricing breakdown for review.

DESCRIPTION:

1. Refer to SA1.2 – SITE LAYOUT AND DEVELOPMENT PLAN:
 - a) Add 4" and 6" concrete pavement as shown for bleachers.
 - b) Add bleacher structure.
 - c) Add gravel pavement under bleachers as shown.
 - d) Sod area around bleachers as shown.
 - e) Relocate light poles to be 122' O.C. from the 50-yard line.
2. Refer to SA2.1 – SITE GRADING AND DRAINAGE PLAN:
 - a) Modify grading and drainage layout as shown.
3. Refer to SA2.2 – SITE GRADING PLAN:
 - a) Slope new pavement at a 1% from north to south.
 - b) Slope area under bleachers at 2% to low point.
 - c) Modify swales to not be under bleachers.
 - d) Raise rim/ground elevation over DS-34.
4. Refer to SA2.3 – SITE DRAINAGE PLAN:
 - a) Add perforated piping under bleachers as shown. Space perf pipes 20' minimum O.C. Space around bleacher foundations.
 - b) Relocate manhole DS-34 along the outgoing pipe. Adjust piping length and add risers to manhole to meet new grade/rim elevation.
 - c) Tie perforated piping to DS-34 and DS-85. Seal penetrations to be watertight.
5. Refer to SA4.3:
 - a) Add stone section detail as shown.
6. Refer to the revised site utility drawings UE2.1:
 - a) Add infrastructure to support pressbox and videoboard.

7. Add devices and equipment per E1.2 pressbox plans.
8. Add electrical equipment to support pressbox and videoboard per E2.0 one-line diagram.
9. Add pressbox communication riser and modify fiber one-line diagram to support pressbox and videoboard.
10. Provide a separate price to perform the following work: Upgrade athletic field lighting system to be 50FC.

Attachments:



SA1.2, SA2.1, SA2.2, SA2.3, SA4.3, UE2.1, E1.2, E2.0, E3.0,
ST110

Prepared By:

Chandler Sergent, AIA Associate

/cs


c: Sarah Lamere, Michael Hughes – RTA
Clay Ratliff -Trace Creek
Shane Smith – Woodford County Schools
File 1916-4B
PR 006

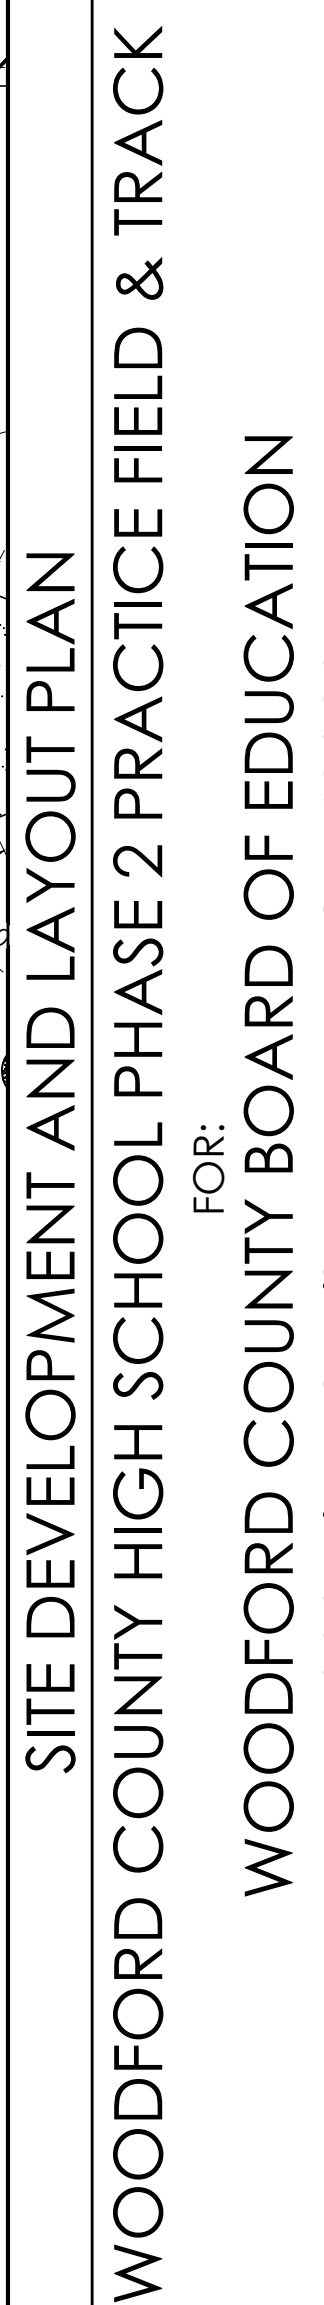

SA1.5
SITE DEVELOPMENT AND
LAYOUT PLAN
DATE ISSUED:
10/28/2022


| SITE GRADING NOTES | | SITE STORM DRAINAGE NOTES | | LEGEND | GENERAL SITE NOTES | | |
|---|--|---|--|---|--------------------|--|--|
| <div>1. THE CONTRACTOR SHALL VERIFY LOCATIONS AND ACTUAL DEPTHS OF ALL EXISTING STORM DRAINS, GAS MAINS, WATER MAINS, AND PIPES TO ALL NEW CONNECTIONS AND CROSSINGS. CONTRACTOR SHALL PAY PARTICULAR ATTENTION TO AREAS WHERE CONSTRUCTION OR GRADING MAY INTERFERE WITH SUCH LINES.</div> <div>2. ANY DISCREPANCIES BETWEEN THIS GRADING PLAN AND ACTUAL FIELD CONDITIONS SHALL BE BROUGHT TO THE ATTENTION OF THE ARCHITECT IN WRITING PRIOR TO EXCAVATION, GRADING, TRENCHING, OR OTHER CONSTRUCTION OF ANY SORT. FAILURE TO NOTIFY THE ARCHITECT IN WRITING PRIOR TO COMMENCEMENT OF EXCAVATION, GRADING, TRENCHING, OR OTHER CONSTRUCTION SHALL IMPLY THE CONTRACTORS VERIFICATION OF AND ACCEPTANCE OF EXISTING SITE CONDITIONS. SAID FAILURE TO NOTIFY THE ARCHITECT IN WRITING SHALL IDENTIFY AND HOLD HARMLESS THE OWNER FROM ANY ADDITIONAL COSTS INCURRED BY THE CONTRACTOR DUE TO DISCREPANCIES NOT REPORTED WHICH COULD HAVE BEEN DETECTED BY PRUDENT AND REASONABLE OBSERVATION AND VERIFICATION BY THE CONTRACTOR.</div> <div>3. ALL IMPERVIOUS SURFACES SHALL BE GRADED AND INSTALLED WITH A MINIMUM SLOPE OF ONE PERCENT (1%) AND A MAXIMUM SLOPE OF SEVEN PERCENT (7%)</div> <div>4. ALL PERVIOUS SURFACES SHALL BE GRADED AND INSTALLED WITH A MINIMUM SLOPE OF TWO PERCENT (2 %) AND A MAXIMUM SLOPE OF THIRTY-THREE PERCENT (33%) EXCEPT WHERE SHOWN.</div> <div>5. SLOPE PERVIOUS SURFACES MIN. 5 % AND IMPERVIOUS SURFACES MIN. 1% AWAY FROM BUILDING FOUNDATIONS.</div> <div>6. MAINTAIN GRADING TO PROMOTE POSITIVE DRAINAGE AT ALL TIMES. DO NOT ALLOW WATER TO POND IN CONSTRUCTION AREAS.</div> <div>7. RELOCATE ALL BURIED UTILITIES THAT ARE IMPACTED BY ANY EARTHWORK. RELOCATED UTILITY LOCATIONS ARE TO BE APPROVED BY THE ARCHITECT PRIOR TO STARTING WORK.</div> <div>8. PROTECT AREAS TO BE SEEDED AS FOLLOWS:<div>A) DITCHES AND DRAINAGE SWALES ARE TO RECEIVE HIGH-VELOCITY EROSION-CONTROL BLANKETS.</div><div>B) SLOPES 4:1 (H:V) OR GREATER ARE TO RECEIVE LONG-TERM EROSION-CONTROL BLANKETS.</div><div>C) SLOPES BETWEEN 4:1 AND 6:1 (H:V) ARE TO RECEIVE SHORT-TERM EROSION CONTROL BLANKETS.</div><div>D) SLOPES BELOW 6:1 (H:V) ARE TO RECEIVE STRAW MULCH PER THE SPECIFICATIONS. DO NOT USE HAY.</div></div> <div>9. ANY AREAS DISTURBED DURING CONSTRUCTION ARE TO BE RECONDITIONED, SEEDED, AND MULCHED PER THE SPECIFICATIONS.</div> | | <div>10. ANY AREAS DISTURBED DURING CONSTRUCTION ARE TO BE RECONDITIONED, SEEDED AND MULCHED PER THE SPECIFICATIONS.</div> <div>11. COMPACT SOIL TO NOT LESS THAN THE FOLLOWING PERCENTAGES OF THEIR STANDARD PROCTOR MAXIMUM DRY DENSITY AT PLUS OR MINUS TWO (2) PERCENT OF OPTIMUM MOISTURE CONTENT:<div>A) UNDER FLOOR SLABS AND FOUNDATIONS ON STRUCTURAL FILL - 98%</div><div>B) FILLS ON EXISTING SOILS, ROCK CUTS OR SHOT-ROCK FILL - 98%</div><div>C) PAVED AREAS AND WALKS - 95%</div><div>D) LANDSCAPE AREAS OUTSIDE MASS FILL AREAS - 85%</div></div> <div>12. ALL TREES THAT ARE IDENTIFIED BY THE ARCHITECT TO REMAIN, EITHER ON THE DRAWING OR IN THE FIELD, ARE TO BE PROTECTED IN ACCORDANCE WITH THE SPECIFICATIONS. ALL TREES LOCATED OUTSIDE OF AREAS IDENTIFIED TO BE RE-GRADED ARE TO BE PROTECTED IN ACCORDANCE WITH THE SPECIFICATIONS.</div> <div>13. THE CONTRACTOR SHALL ENSURE THAT CONSTRUCTION DEBRIS AND SEDIMENT ARE REMOVED DAILY FROM SITE DRIVEWAYS, PARKING AREAS, WALKWAYS AND SURROUNDING ROADWAYS AND WALKWAYS.</div> <div>14. EXCESS SATISFACTORY SOILS ARE TO BE DISPOSED OF OFF SITE.</div> <div>15. THE NEW PARKING, ROADS AND ROAD BASE ARE NOT DESIGNED TO ACCOMMODATE CONSTRUCTION TRAFFIC AND SHOULD NOT BE USED FOR SUCH UNLESS STABILIZED USING #2 CRUSHED STONE AND/OR GEO-GRID IN ADDITION TO THE PAVEMENT DESIGN SECTION SHOWN. IF THE CONTRACTOR WISHES TO USE THE NEW ROAD ALIGNMENTS DURING CONSTRUCTION, IT IS THE CONTRACTORS RESPONSIBILITY TO STABILIZE THE ROAD ALIGNMENT SUBGRADES AND PREVENT THEM FROM BEING DAMAGED DURING CONSTRUCTION.</div> <div>16. THE CONTRACTOR SHALL INSTALL AND MAINTAIN A CRUSHED STONE ENTRY AND DRIVE TO REDUCE SOIL TRACKING. SEE SHEET SA0.1 AND DETAIL J/S44.1 FOR ADDITIONAL INFORMATION.</div> | | <div>1. DRAINAGE PIPE THAT CROSSES UNDER ROADS OR PARKING AREAS SHALL BE REINFORCED CONCRETE. ALL PE PIPE SHALL BE DUAL WALL POLYETHYLENE PIPE WITH SMOOTH INTERIOR WALL, OR EQUIVALENT AS APPROVED IN THE SPECIFICATIONS. ALL STORM PIPING SHALL BE INSTALLED AT A CONSTANT, POSITIVE SLOPE FROM INLET CONNECTION TO DISCHARGED CONNECTION. PIPE SLOPE IS TO BE 0.3% MINIMUM.</div> <div>2. SEDIMENT PROTECTION DEVICES, SUCH AS SILT FENCING SHALL BE INSTALLED IN AND/OR AROUND ALL STORM STRUCTURES.</div> <div>3. EROSION CONTROL BLANKETS ARE TO BE INSTALLED AS INDICATED IN THE SPECIFICATIONS.</div> <div>4. ALL STORM STRUCTURES ARE TO BE DESIGNED FOR H-20 LOADING.</div> <div>5. ALL GRATES AND MANHOLE COVERS ARE TO BE HEAVY DUTY CAST IRON DESIGNED FOR H-20 LOADING.</div> <div>6. MAINTAIN GRADING TO PROMOTE POSITIVE DRAINAGE AT ALL TIMES.</div> <div>7. ALL ROOF DRAINS AND DOWNSPOUTS, INCLUDING CANOPY DOWNSPOUTS, ARE TO BE PIPED UNDERGROUND AND CONNECTED TO STORM WATER STRUCTURES. DOWNSPOUT BOOT AND DOWNSPOUT SIZES ARE TO BE COORDINATED WITH THE MANUFACTURERS AND INSTALLERS OF EACH ITEM. CLEANOUTS ARE TO BE LOCATED AT EACH CHANGE IN DIRECTION OF THE PIPING. ENSURE CLEANOUTS ARE DESIGNED FOR AUTOMOBILE TRAFFIC, AND ARE FLUSH WITH THE SURROUNDING SURFACES.</div> <div>8. THE LOCATIONS SHOWN FOR THE NEW STORM SEWER PIPING AND STRUCTURES ARE APPROXIMATE. ACTUAL LOCATIONS CAN BE ADJUSTED WITH ARCHITECTS WRITTEN APPROVAL IN ORDER TO AVOID UNFORESEEN CONDITIONS OR OTHER CONSTRUCTION CONFLICTS. CONTRACTOR IS TO COORDINATE STORM SEWER INSTALLATION WITH ALL OTHER TRADES AND WORK.</div> | | <div><div>DS-P</div>DRAINAGE STRUCTURE. REFER TO STORM DRAINAGE STRUCTURE SCHEDULE.</div> <div><div>DS-B</div>DOWNSPOUT BOOT [334993]. SEE DETAIL C/S44.1</div> <div>TC - TOP OF CURB</div> <div>BC - BOTTOM OF CURB</div> <div>FFE - FINISHED FLOOR ELEVATION</div> | <div>1. THE SITE PLANS WERE PREPARED BASED UPON TOPOGRAPHIC SURVEYS BY S&M; 2020 LIBERTY ROAD SITE 105, LEXINGTON, KY, 40505. REFER TO SITE SURVEY SHEETS.</div> <div>2. THE CONTRACTOR SHALL FIELD VERIFY ALL EXISTING SITE FEATURES AND CONDITIONS. REPORT ANY DISCREPANCIES TO THE ARCHITECT PRIOR TO THE START OF CONSTRUCTION.</div> <div>3. THE ARCHITECT AND ARCHITECTS CONSULTANTS SHALL HAVE NO RESPONSIBILITY FOR THE DISCOVERY, PRESENCE, HANDLING, REMOVAL OR DISPOSAL OF, OR EXPOSURE OF PERSONS TO HAZARDOUS MATERIALS IN ANY FORM AT THE PROJECT SITE, INCLUDING BUT NOT LIMITED TO ASBESTOS, ASBESTOS PRODUCTS, POLYCHLORINATED BIPHENYL (PCB) OR OTHER TOXIC SUBSTANCES.</div> <div>4. THE CONTRACTOR SHALL USE EXTREME CARE IN WORKING AROUND EXISTING OVERHEAD AND UNDERGROUND UTILITIES. MEASURES SHOULD BE TAKEN TO PROTECT ALL UTILITIES FROM DAMAGE DURING CONSTRUCTION.</div> <div>5. SEE EROSION POLLUTION AND SEDIMENT CONTROL PLAN ON SD0.1 FOR RECOMMENDED BEST MANAGEMENT PRACTICES INFORMATION AND SEDIMENT CONTROLS.</div> <div>6. REFER TO CONSTRUCTION MANAGER'S PLANS AND SPECIFICATIONS FOR INFORMATION REGARDING CONSTRUCTION SCHEDULE/SEQUENCING, CONSTRUCTION FENCING/STAGING.</div> |

| STRUCTURE SCHEDULE | | | | | | | |
|--------------------|-------------|--------------|---------------------|------------------------|---------------------|---------|-------------|
| STRC. NO. | GRATE ELEV. | INVERT ELEV. | STR. DESC. | GRATE TYPE | FRAME TYPE | DETAIL | EASTING |
| DS-1 | N/A | 886.00 | HEADWALL | GALVANIZED BAR & GRATE | N/A | B/SA4.1 | 198503.0713 |
| DS-2 | 904.68 | 887.02 | 48" MANHOLE (MIN) | SOLID LID | NEENAH R-1733 | A/SD4.1 | 198460.8143 |
| DS-3 | 904.50 | 896.88 | 48" MANHOLE (MIN) | SOLID LID | NEENAH R-1733 | A/SA4.1 | 198382.5589 |
| DS-4 | 904.50 | 900.23 | 48" MANHOLE (MIN) | SOLID LID | NEENAH R-1733 | A/SA4.1 | 198181.9131 |
| DS-5 | 904.50 | 897.92 | 48" MANHOLE (MIN) | SOLID LID | NEENAH R-1733 | A/SA4.1 | 198226.1349 |
| DS-6 | 904.50 | 899.80 | 48" MANHOLE (MIN) | SOLID LID | NEENAH R-1733 | A/SA4.1 | 198026.0843 |
| DS-10 | 904.00 | 900.00 | 18" DRAIN BASIN | 18" STD. SLOTTED GRATE | N/A | D/SA4.1 | 198461.8404 |
| DS-11 | 904.36 | 900.81 | CLEANOUT | BRONZE COVER W/ SCREWS | CAST IRON VALVE BOX | F/SA4.1 | 198244.7995 |
| DS-13 | 903.57 | 901.57 | 18" DRAIN BASIN | 18" STD. SLOTTED GRATE | N/A | D/SA4.1 | 197981.0261 |
| DS-14 | N/A | 900.11 | PERF. PIPE HEADWALL | RODENT SCREEN | N/A | B/SA4.1 | 198151.6819 |
| DS-15 | 904.50 | 900.86 | 18" DRAIN BASIN | 18" STD. SLOTTED GRATE | N/A | D/SD4.1 | 198214.2499 |
| DS-16 | VARIES | 902.72 | 100 LF TRENCH DRAIN | LONGITUDINAL CAST IRON | ACO X200 | F/SA4.1 | 198187.8857 |

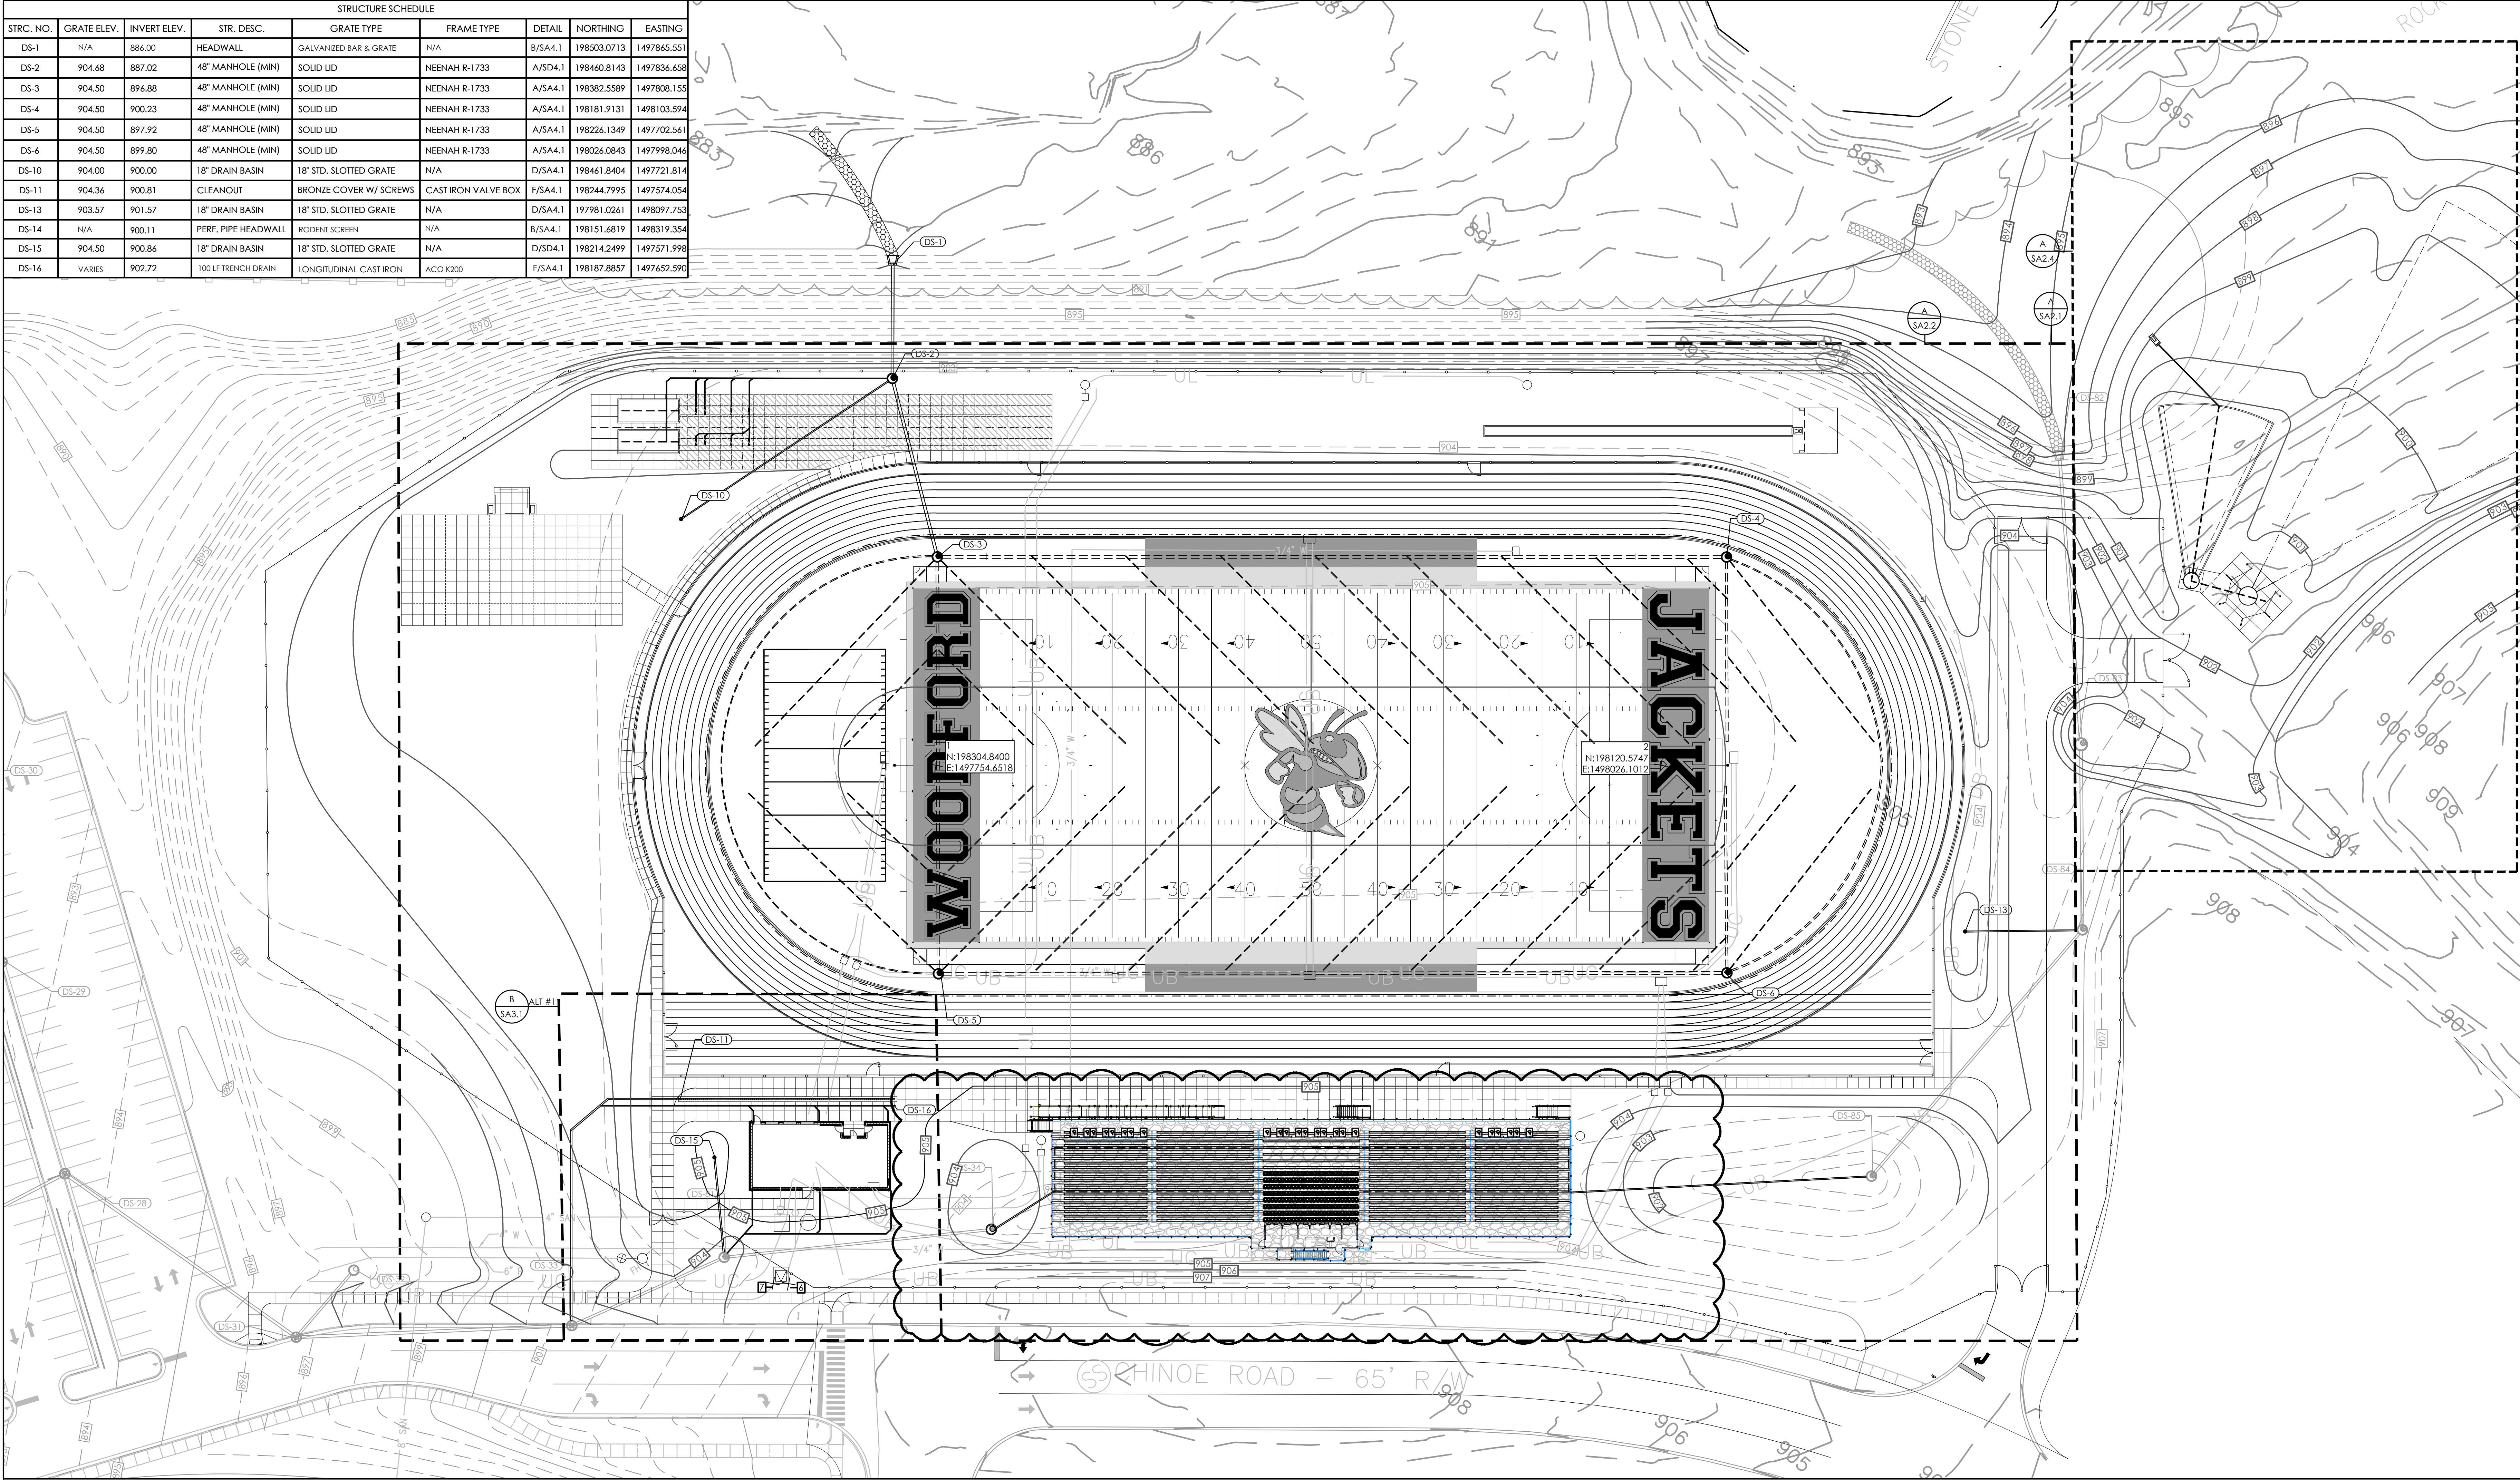

SITE GRADING & DRAINAGE PLAN

SCALE: 1"=30'

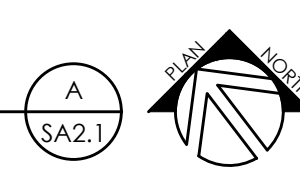

SA2.1

SITE GRADING AND DRAINAGE PLAN

DATE ISSUED: 10/28/2022

SITE GRADING & DRAINAGE PLAN
WOODFORD COUNTY HIGH SCHOOL PHASE 2 PRACTICE FIELD & TRACK
FOR:
WOODFORD COUNTY BOARD OF EDUCATION
330 Pisgah Pike, Kentucky 40383

M/E & P Engineer:
CMAA, Inc.
2429 Members Way
Lexington, KY 40504
p 859.253.0892
Structural Engineer:
Structural Design Group, Inc.
220 Great Circle Rd., Suite 106
Nashville, TN 37228
p 615.255.5537
Construction Manager:
Trace Creek Construction, Inc.
127 Market Street, Suite 200
PO Box 539
Vanceburg, KY 41179-0539
p 606.796.3867

BG# 23-120

Project No: 1916
Drawn By: ELW/ESS
Rev'd By: NBN/KAM

| SHEET RELEASE | |
|---------------|----------------------|
| 1 | 11/29/22 ADDENDUM #1 |
| 2 | 6/21/23 PR 01 |
| 3 | 5/29/24 PR 04 |
| 4 | 10/17/24 PR 06 |
| 5 | |
| 6 | |
| 7 | |
| 8 | |

COPYRIGHT © 2022
CONSTRUCTION DOCUMENTS

rosstarrant
architects
10 oldbryants avenue lexington, kentucky 40302 p 859.254.0183

10/28/2022

| SITE GRADING NOTES | |
|--|--|
| 1. THE CONTRACTOR SHALL VERIFY LOCATIONS AND ACTUAL DEPTHS OF ALL EXISTING STORM DRAINS, GAS MAINS, WATER MAINS, AND PIPES TO ALL NEW CONNECTIONS AND CROSSINGS. CONTRACTOR SHALL PAY PARTICULAR ATTENTION TO AREAS WHERE CONSTRUCTION OR GRADING MAY INTERFERE WITH SUCH LINES. | 10. COMPACT SOIL TO NOT LESS THAN THE FOLLOWING PERCENTAGES OF THEIR STANDARD PROCTOR MAXIMUM DRY DENSITY AT PLUS OR MINUS TWO (2) PERCENT OF OPTIMUM MOISTURE CONTENT: |
| 2. ANY DISCREPANCIES BETWEEN THIS GRADING PLAN AND ACTUAL FIELD CONDITIONS SHALL BE BROUGHT TO THE ATTENTION OF THE ARCHITECT IN WRITING PRIOR TO EXCAVATION, GRADING, TRENCING, OR OTHER CONSTRUCTION OF ANY SORT. FAILURE TO NOTIFY THE ARCHITECT IN WRITING PRIOR TO COMMENCEMENT OF EXCAVATION, GRADING, TRENCING, OR OTHER CONSTRUCTION, LIMITS THE CONTRACTOR'S VERIFICATION OF AND ACCEPTANCE OF EXISTING SITE CONDITIONS. SAID FAILURE TO NOTIFY THE ARCHITECT IN WRITING SHALL IDENTIFY AND HOLD HARMLESS THE OWNER FROM ANY ADDITIONAL COSTS INCURRED BY THE CONTRACTOR DUE TO DISCREPANCIES NOT REPORTED WHICH COULD HAVE BEEN DETECTED BY PRUDENT AND REASONABLE OBSERVATION AND VERIFICATION BY THE CONTRACTOR. | A) UNDER FLOOR SLABS AND FOUNDATIONS ON STRUCTURAL FILL - 98% B) FILLS ON EXISTING SOILS, ROCK CUTS OR SHOT-ROCK FILL - 98% C) PAVED AREAS AND WALKS - 95% D) LANDSCAPE AREAS OUTSIDE MASS FILL AREAS - 85% |
| 3. ALL IMPERVIOUS SURFACES SHALL BE GRADED AND INSTALLED WITH A MINIMUM SLOPE OF ONE PERCENT (1%) AND A MAXIMUM SLOPE OF SEVEN PERCENT (7%) | 11. ALL TREES THAT ARE IDENTIFIED BY THE ARCHITECT TO REMAIN, EITHER ON THE DRAWING OR IN THE FIELD, ARE TO BE PROTECTED IN ACCORDANCE WITH THE SPECIFICATIONS. ALL TREES LOCATED OUTSIDE OF AREAS IDENTIFIED TO BE RE-GRADED ARE TO BE PROTECTED IN ACCORDANCE WITH THE SPECIFICATIONS. |
| 4. ALL PERVIOUS SURFACES SHALL BE GRADED AND INSTALLED WITH A MINIMUM SLOPE OF TWO PERCENT (2%) AND A MAXIMUM SLOPE OF THIRTY-THREE PERCENT (33%) EXCEPT WHERE SHOWN. | 12. THE CONTRACTOR SHALL ENSURE THAT CONSTRUCTION DEBRIS AND SEDIMENT ARE REMOVED DAILY FROM SITE DRIVEWAYS, PARKING AREAS, WALKWAYS AND SURROUNDING ROADWAYS AND WALKWAYS. |
| 5. SLOPE PERVIOUS SURFACES MIN. 5% AND IMPERVIOUS SURFACES MIN. 1% AWAY FROM BUILDING FOUNDATIONS. | 13. EXCESS SATISFACTORY SOILS ARE TO BE DISPOSED OF OFF-SITE. |
| 6. MAINTAIN GRADING TO PROMOTE POSITIVE DRAINAGE AT ALL TIMES. DO NOT ALLOW WATER TO POND IN CONSTRUCTION AREAS. | 14. THE NEW PARKING, ROADS AND ROAD BASE ARE NOT DESIGNED TO ACCOMMODATE CONSTRUCTION TRAFFIC AND SHOULD NOT BE USED FOR SUCH UNLESS STABILIZED USING #2 CRUSHED STONE AND/OR GEO-GRID IN ADDITION TO THE PAVEMENT DESIGN SECTION SHOWN. IF THE CONTRACTOR WISHES TO USE THE NEW ROAD ALIGNMENTS DURING CONSTRUCTION, IT IS THE CONTRACTOR'S RESPONSIBILITY TO STABILIZE THE ROAD ALIGNMENT SUBGRADES AND PREVENT THEM FROM BEING DAMAGED DURING CONSTRUCTION. |
| 7. RELOCATE ALL BURIED UTILITIES THAT ARE IMPACTED BY ANY EARTHWORK. RELOCATED UTILITY LOCATIONS ARE TO BE APPROVED BY THE ARCHITECT PRIOR TO STARTING WORK. | 15. THE CONTRACTOR SHALL INSTALL AND MAINTAIN A CRUSHED STONE ENTRY AND DRIVE TO REDUCE SOIL TRACKING. REFER TO S&O.1 AND DETAIL J/S&O.1 FOR ADDITIONAL INFORMATION. |
| 8. PROTECT AREAS TO BE SEEDED AS FOLLOWS: A) DITCHES AND DRAINAGE SWALES ARE TO RECEIVE HIGH-VELOCITY EROSION-CONTROL BLANKETS. B) SLOPES 4:1 (H:V) OR GREATER ARE TO RECEIVE LONG-TERM EROSION-CONTROL BLANKETS. C) SLOPES BETWEEN 4:1 AND 6:1 (H:V) ARE TO RECEIVE SHORT-TERM EROSION-CONTROL BLANKETS. D) SLOPES BELOW 6:1 (H:V) ARE TO RECEIVE STRAW MULCH PER THE SPECIFICATIONS. DO NOT USE HAY. | |
| 9. ANY AREAS DISTURBED DURING CONSTRUCTION ARE TO BE RECONDITIONED, SEEDED AND MULCHED PER THE SPECIFICATIONS. | |

SPOT ELEVATION LEGEND

| | |
|-----|----------------------------|
| TC | - TOP OF CURB |
| BC | - BOTTOM OF CURB |
| FFE | - FINISHED FLOOR ELEVATION |

GENERAL SITE NOTES

1. THE SITE PLANS WERE PREPARED BASED UPON TOPOGRAPHIC SURVEYS BY S&ME, 2000 LIBERTY ROAD, SUITE 105, LEXINGTON, KENTUCKY 40505. REFER TO SITE SURVEY SHEETS.
2. THE CONTRACTOR SHALL FIELD VERIFY ALL EXISTING SITE FEATURES AND CONDITIONS, REPORT ANY DISCREPANCIES TO THE ARCHITECT PRIOR TO THE START OF CONSTRUCTION.
3. THE ARCHITECT AND ARCHITECT'S CONSULTANTS SHALL HAVE NO RESPONSIBILITY FOR THE DISCOVERY, PRESENCE, HANDLING, REMOVAL OR DISPOSAL OF, OR EXPOSURE OF PERSONS TO HAZARDOUS MATERIALS IN ANY FORM AT THE PROJECT SITE, INCLUDING BUT NOT LIMITED TO ASBESTOS, ASBESTOS PRODUCTS, POLYCHLORINATED BIPHENYL (PCB) OR OTHER TOXIC SUBSTANCES.
4. THE CONTRACTOR SHALL USE EXTREME CARE IN WORKING AROUND EXISTING OVERHEAD AND UNDERGROUND UTILITIES. MEASURES SHOULD BE TAKEN TO PROTECT ALL UTILITIES FROM DAMAGE DURING CONSTRUCTION.
5. SEE EROSION POLLUTION AND SEDIMENT CONTROL PLAN ON S001. FOR RECOMMENDED BEST MANAGEMENT PRACTICES INFORMATION AND SEDIMENT CONTROLS.
6. REFER TO CONSTRUCTION MANAGER'S PLANS AND SPECIFICATIONS FOR INFORMATION REGARDING CONSTRUCTION SCHEDULE/SEQUENCING, CONSTRUCTION FENCING/STAGING, AND LEED SPECIFIC REQUIREMENTS.

101 old lafayette avenue lexington, kentucky 40502 p 859.254.4018

1

SITE GRADING PLAN

WOODFORD COUNTY HIGH SCHOOL PHASE 2 PRACTICE FIELD & TRACK

FOR:

WOODFORD COUNTY BOARD OF EDUCATION

330 Pisgah Pike , Kentucky 40383

M,E,P Engineer:
CMTA, Inc.
2429 Members Way
Lexington, KY 40504
p 859.253.0892

Structural Engineer:
Structural Design Group, Inc.
220 Great Circle Rd. Suite 106
Nashville, TN 37228
p 615.255.5537

Construction Manager:
Trace Creek Construction, Inc.
127 Market Street, Suite 200
PO Box 539
Vanceburg, KY 41179-0539
p 606.796.3867

| |
|------------|
| BG# 23-120 |
|------------|

| | |
|-------------|---------|
| Project No: | 1916 |
| Drawn By: | ELM/EGS |
| Rev'd By: | MBM/KAM |

| | | |
|---------------|----------|-------------|
| SHEET RELEASE | | |
| 1 | 11/29/22 | ADDENDUM #1 |
| 2 | 6/21/23 | PROJ |

| | | |
|---|---------|------|
| 2 | 5/27/23 | PR01 |
| 3 | 5/29/24 | PR04 |
| 4 | | |
| 5 | | |


| | | |
|---|--|--|
| 5 | | |
| 6 | | |
| 7 | | |
| 8 | | |

COPYRIGHT © 2022
CONSTRUCTION DOCUMENTS

SA2 2

5A2.2

SITE GRADING PLAN

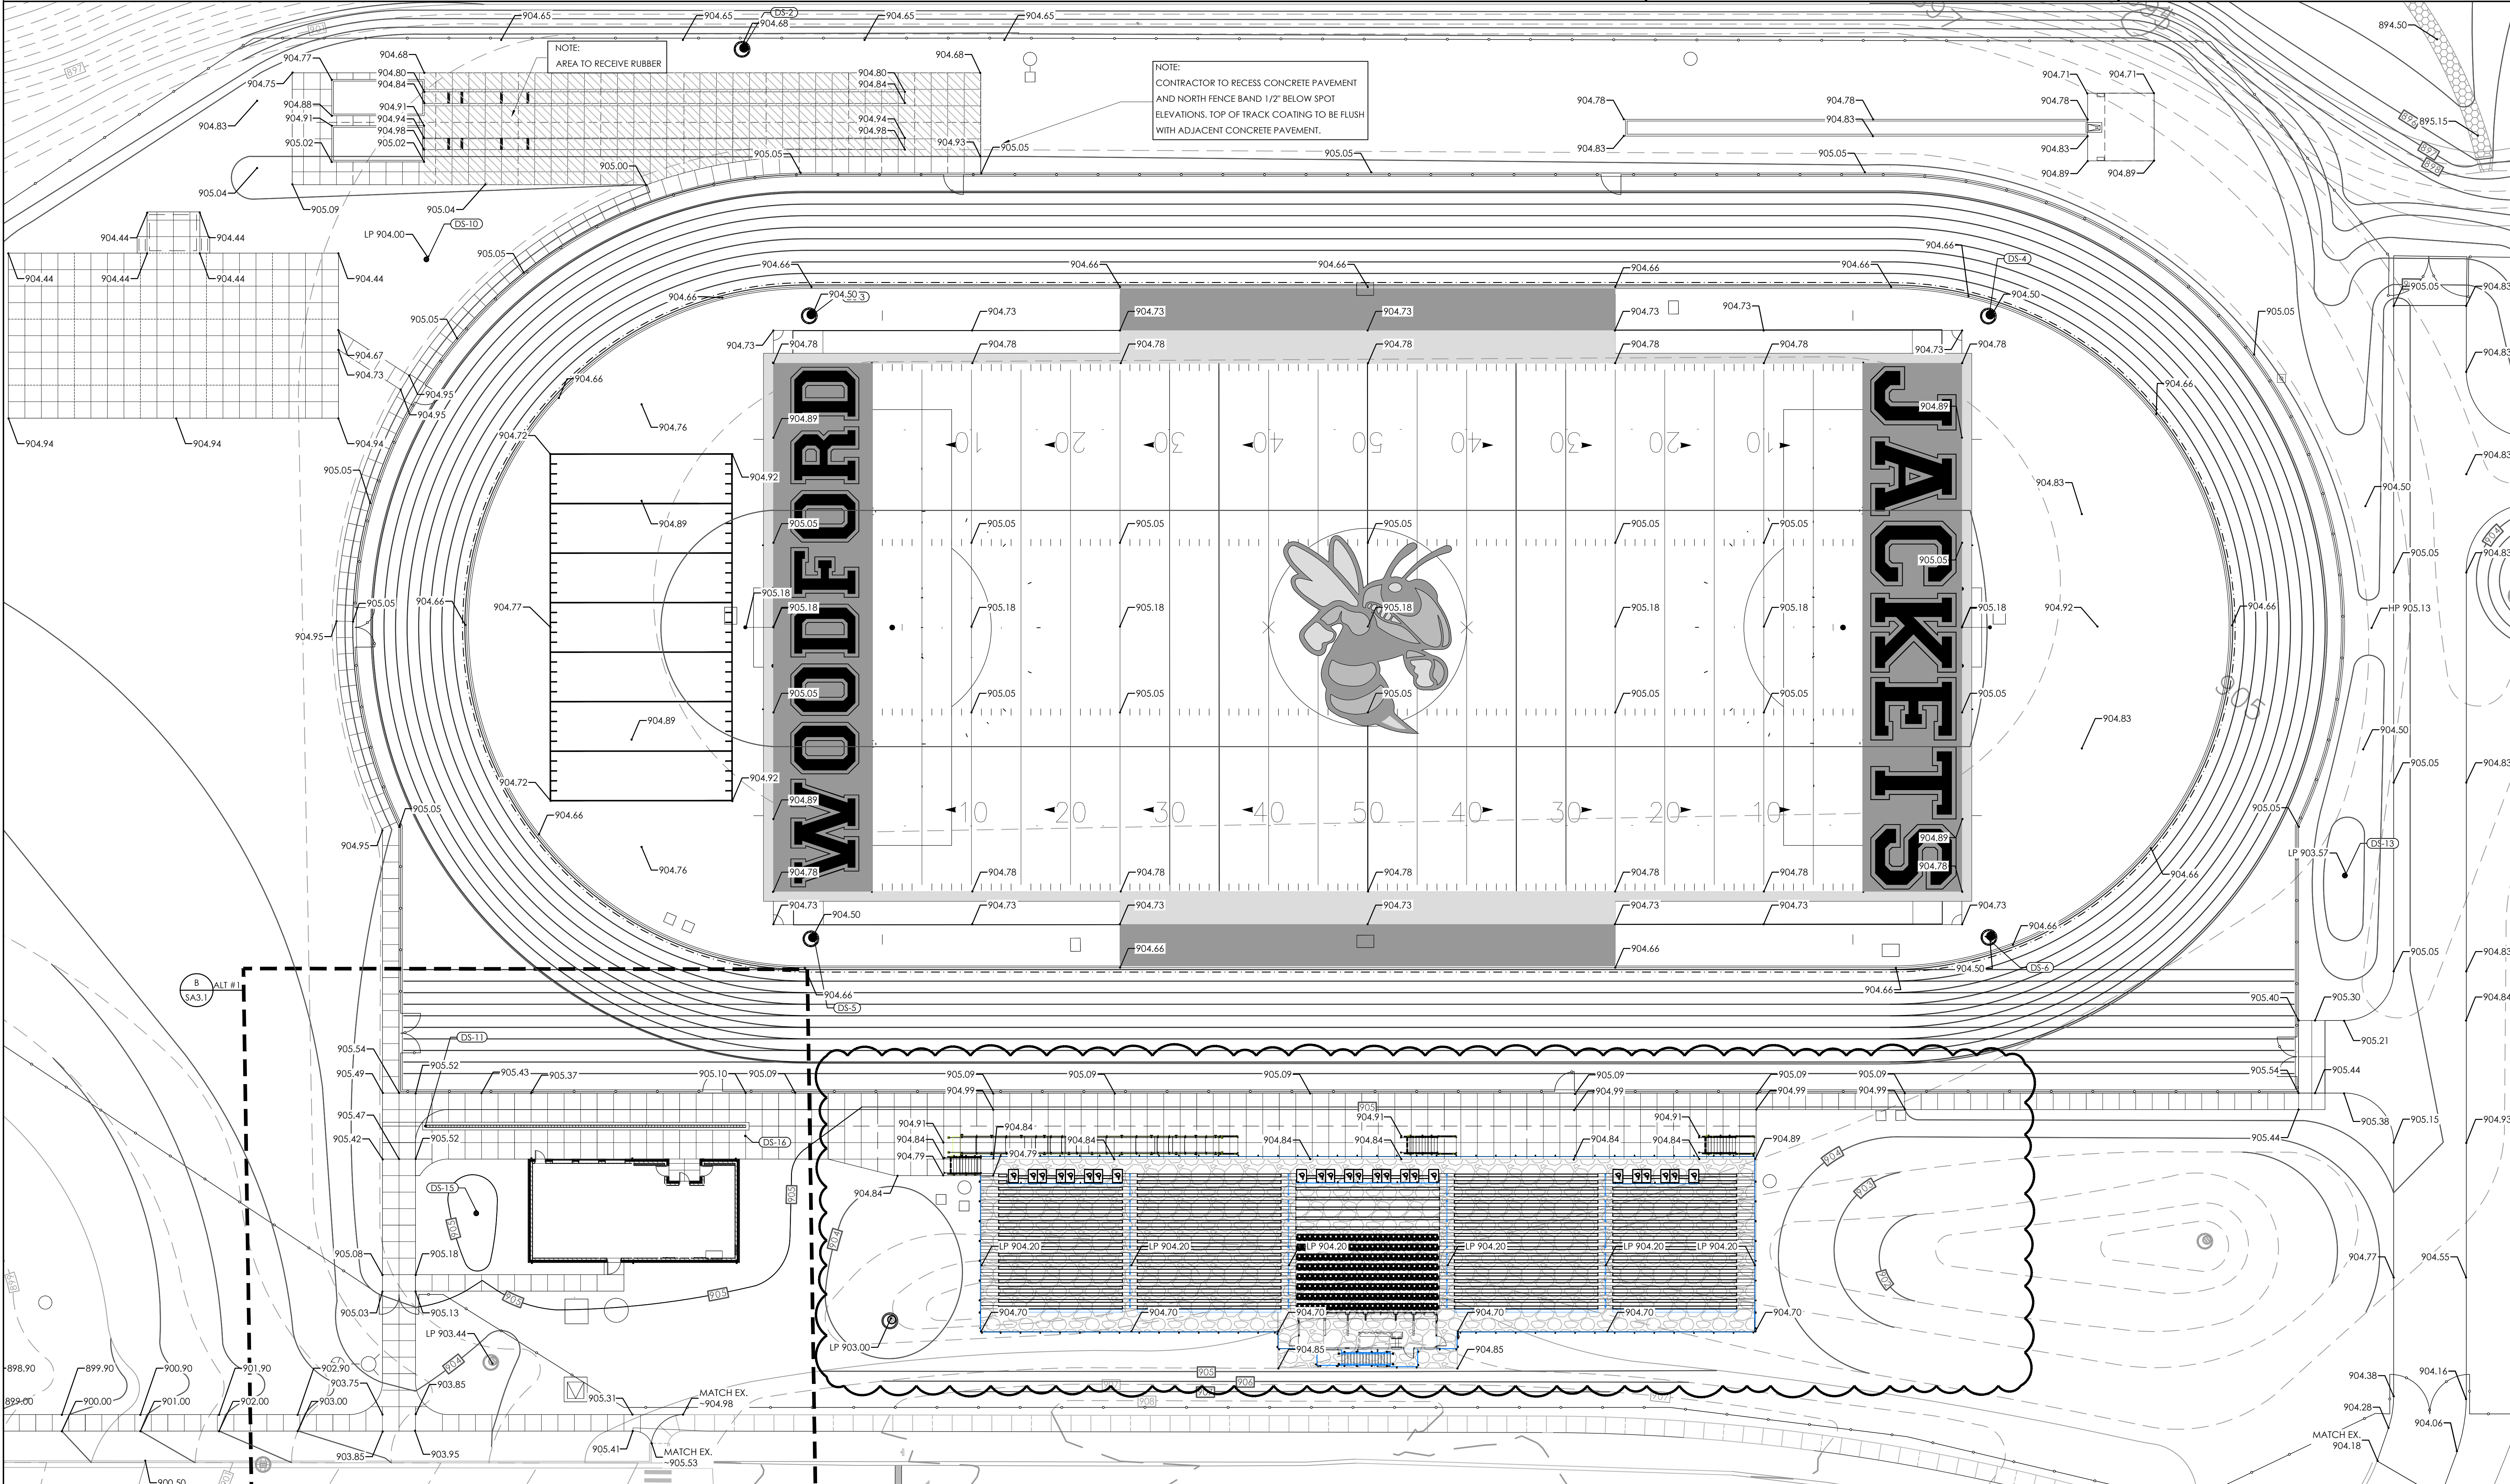

SCALE: 1"=20'

0 20 40



SITE GRADING PLAN

SITE STORM DRAINAGE NOTES

1. DRAINAGE PIPE THAT CROSSES UNDER ROADS OR PARKING AREAS SHALL BE REINFORCED CONCRETE. ALL PE PIPE SHALL BE DUAL WALL POLYETHYLENE PIPE WITH SMOOTH INTERIOR WALL OR EQUIVALENT AS APPROVED IN THE SPECIFICATIONS. ALL STORM PIPING SHALL BE INSTALLED AT A CONSTANT, POSITIVE SLOPE FROM INLET CONNECTION TO DISCHARGED CONNECTION. PIPE SLOPE IS TO BE 0.5% MINIMUM.
2. SEDIMENT PROTECTION DEVICES, SUCH AS SILT FENCING SHALL BE INSTALLED IN AND/OR AROUND ALL STORM STRUCTURES.
3. EROSION CONTROL BLANKETS ARE TO BE INSTALLED AS INDICATED IN THE SPECIFICATIONS.
4. ALL STORM STRUCTURES ARE TO BE DESIGNED FOR H-20 LOADING.
5. ALL GRATES AND MANHOLE COVERS ARE TO BE HEAVY DUTY CAST IRON DESIGNED FOR H-20 LOADING.
6. MAINTAIN GRADING TO PROMOTE POSITIVE DRAINAGE AT ALL TIMES.
7. ALL ROOF DRAINS AND DOWNSPOUTS, INCLUDING CANOPY DOWNSPOUTS, ARE TO BE PIPED UNDERGROUND AND CONNECTED TO STORM WATER STRUCTURES. DOWNSPOUT BOOT AND DOWNSPOUT SIZES ARE TO BE COORDINATED WITH THE MANUFACTURERS AND INSTALLERS OF EACH ITEM. CLEANOUTS ARE TO BE LOCATED AT EACH CHANGE IN DIRECTION OF THE PIPING. ENSURE CLEANOUTS ARE DESIGNED FOR AUTOMOBILE TRAFFIC, AND ARE FLUSH WITH THE SURROUNDING SURFACES.
8. THE LOCATIONS SHOWN FOR THE NEW STORM SEWER PIPING AND STRUCTURES ARE APPROXIMATE. ACTUAL LOCATIONS CAN BE ADJUSTED WITH ARCHITECT'S WRITTEN APPROVAL IN ORDER TO AVOID UNFORESEEN CONDITIONS OR OTHER CONSTRUCTION CONFLICTS. CONTRACTOR IS TO COORDINATE STORM SEWER INSTALLATION WITH ALL OTHER TRADES AND WORK.

LEGEND

- DS-D DRAINAGE STRUCTURE. REFER TO STORM DRAINAGE STRUCTURE SCHEDULE.
- DS-S DOWNSPOUT BOOT (334993). SEE DETAIL C/SA4.1

GENERAL SITE NOTES

1. THE SITE PLANS WERE PREPARED BASED UPON TOPOGRAPHIC SURVEYS BY S&ME, 2020 LIBERTY ROAD, SUITE 105, LEXINGTON, KENTUCKY, 40505. REFER TO SITE SURVEY SHEETS.
2. THE CONTRACTOR SHALL FIELD VERIFY ALL EXISTING SITE FEATURES AND CONDITIONS. REPORT ANY DISCREPANCIES TO THE ARCHITECT PRIOR TO THE START OF CONSTRUCTION.
3. THE ARCHITECT AND ARCHITECT'S CONSULTANTS SHALL HAVE NO RESPONSIBILITY FOR THE DISCOVERY, PRESENCE, HANDLING, REMOVAL OR DISPOSAL OF, OR EXPOSURE OF PERSONS TO HAZARDOUS MATERIALS IN ANY FORM AT THE PROJECT SITE, INCLUDING BUT NOT LIMITED TO ASBESTOS, ASBESTOS PRODUCTS, POLYCHLORINATED BI-PHENYL (PCB) OR OTHER TOXIC SUBSTANCES.
4. THE CONTRACTOR SHALL USE EXTREME CARE IN WORKING AROUND EXISTING OVERHEAD AND UNDERGROUND UTILITIES. MEASURES SHOULD BE TAKEN TO PROTECT ALL UTILITIES FROM DAMAGE DURING CONSTRUCTION.
5. SEE EROSION POLLUTION AND SEDIMENT CONTROL PLAN ON SD0.1 FOR RECOMMENDED BEST MANAGEMENT PRACTICES INFORMATION AND SEDIMENT CONTROLS.
6. REFER TO CONSTRUCTION MANAGER'S PLANS AND SPECIFICATIONS FOR INFORMATION REGARDING CONSTRUCTION SCHEDULE/SEQUENCING, CONSTRUCTION FENCING/STAGING, AND LEED SPECIFIC REQUIREMENTS.

10/28/2022

SITE DRAINAGE PLAN

WOODFORD COUNTY HIGH SCHOOL PHASE 2 PRACTICE FIELD & TRACK

FOR:

WOODFORD COUNTY BOARD OF EDUCATION

330 Pisgah Pike, Kentucky 40383

M.E.&P. Engineer:
CMAA, Inc.
2429 Members Way
Lexington, KY 40504
p 859.253.0892

Structural Engineer:
Structural Design Group, Inc.
220 Great Circle Rd., Suite 106
Nashville, TN 37228
p 615.255.5537

Construction Manager:
Trace Creek Construction, Inc.
127 Market Street, Suite 200
PO Box 539
Vanceburg, KY 41179-0539
p 606.796.3867

BG# 23-120


| | |
|---------------|----------------------|
| Project No: | 1916 |
| Drawn By: | ELW/ESS |
| Rev'd By: | MSH/KAM |
| SHEET RELEASE | |
| 1 | 11/29/22 ADDENDUM #1 |
| 2 | 6/21/23 PRO1 |
| 3 | 5/29/24 PR04 |
| 4 | |
| 5 | |
| 6 | |
| 7 | |
| 8 | |

COPYRIGHT © 2022
CONSTRUCTION DOCUMENTS

SA2.3

SITE DRAINAGE PLAN




DATE ISSUED:
10/28/2022

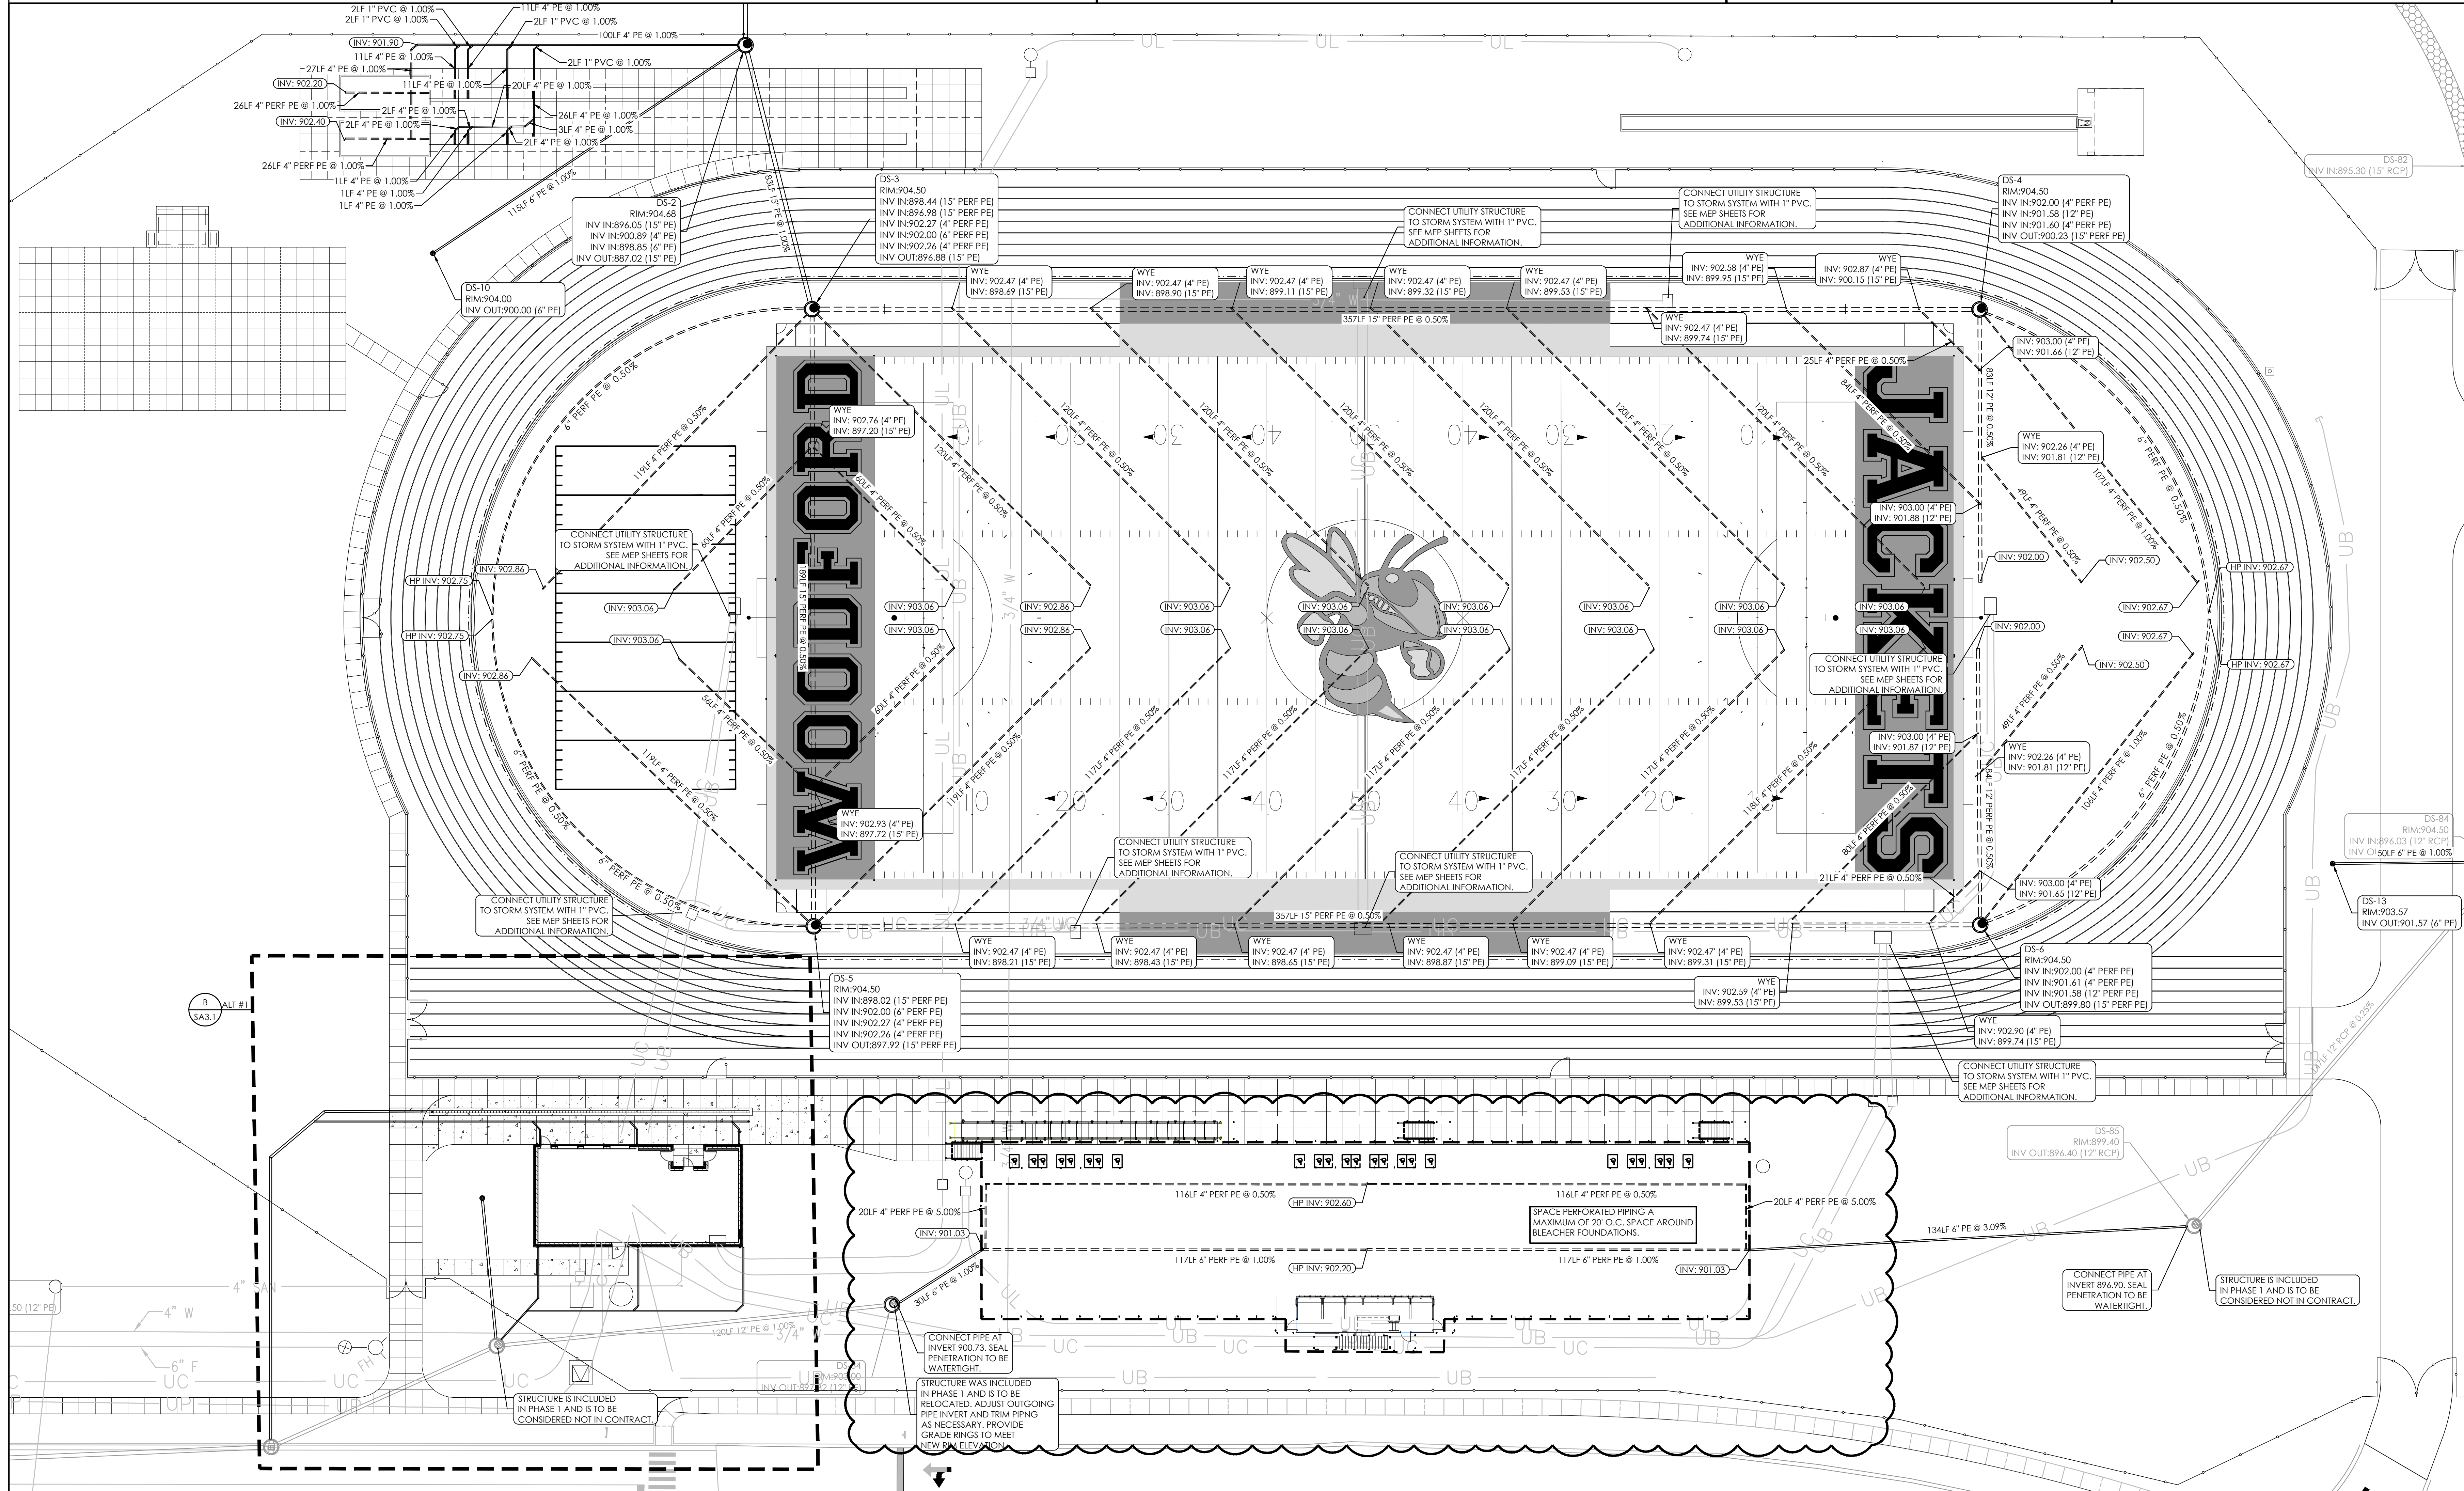

SITE DRAINAGE PLAN

SCALE: 1"=20'

0 20 40 Feet

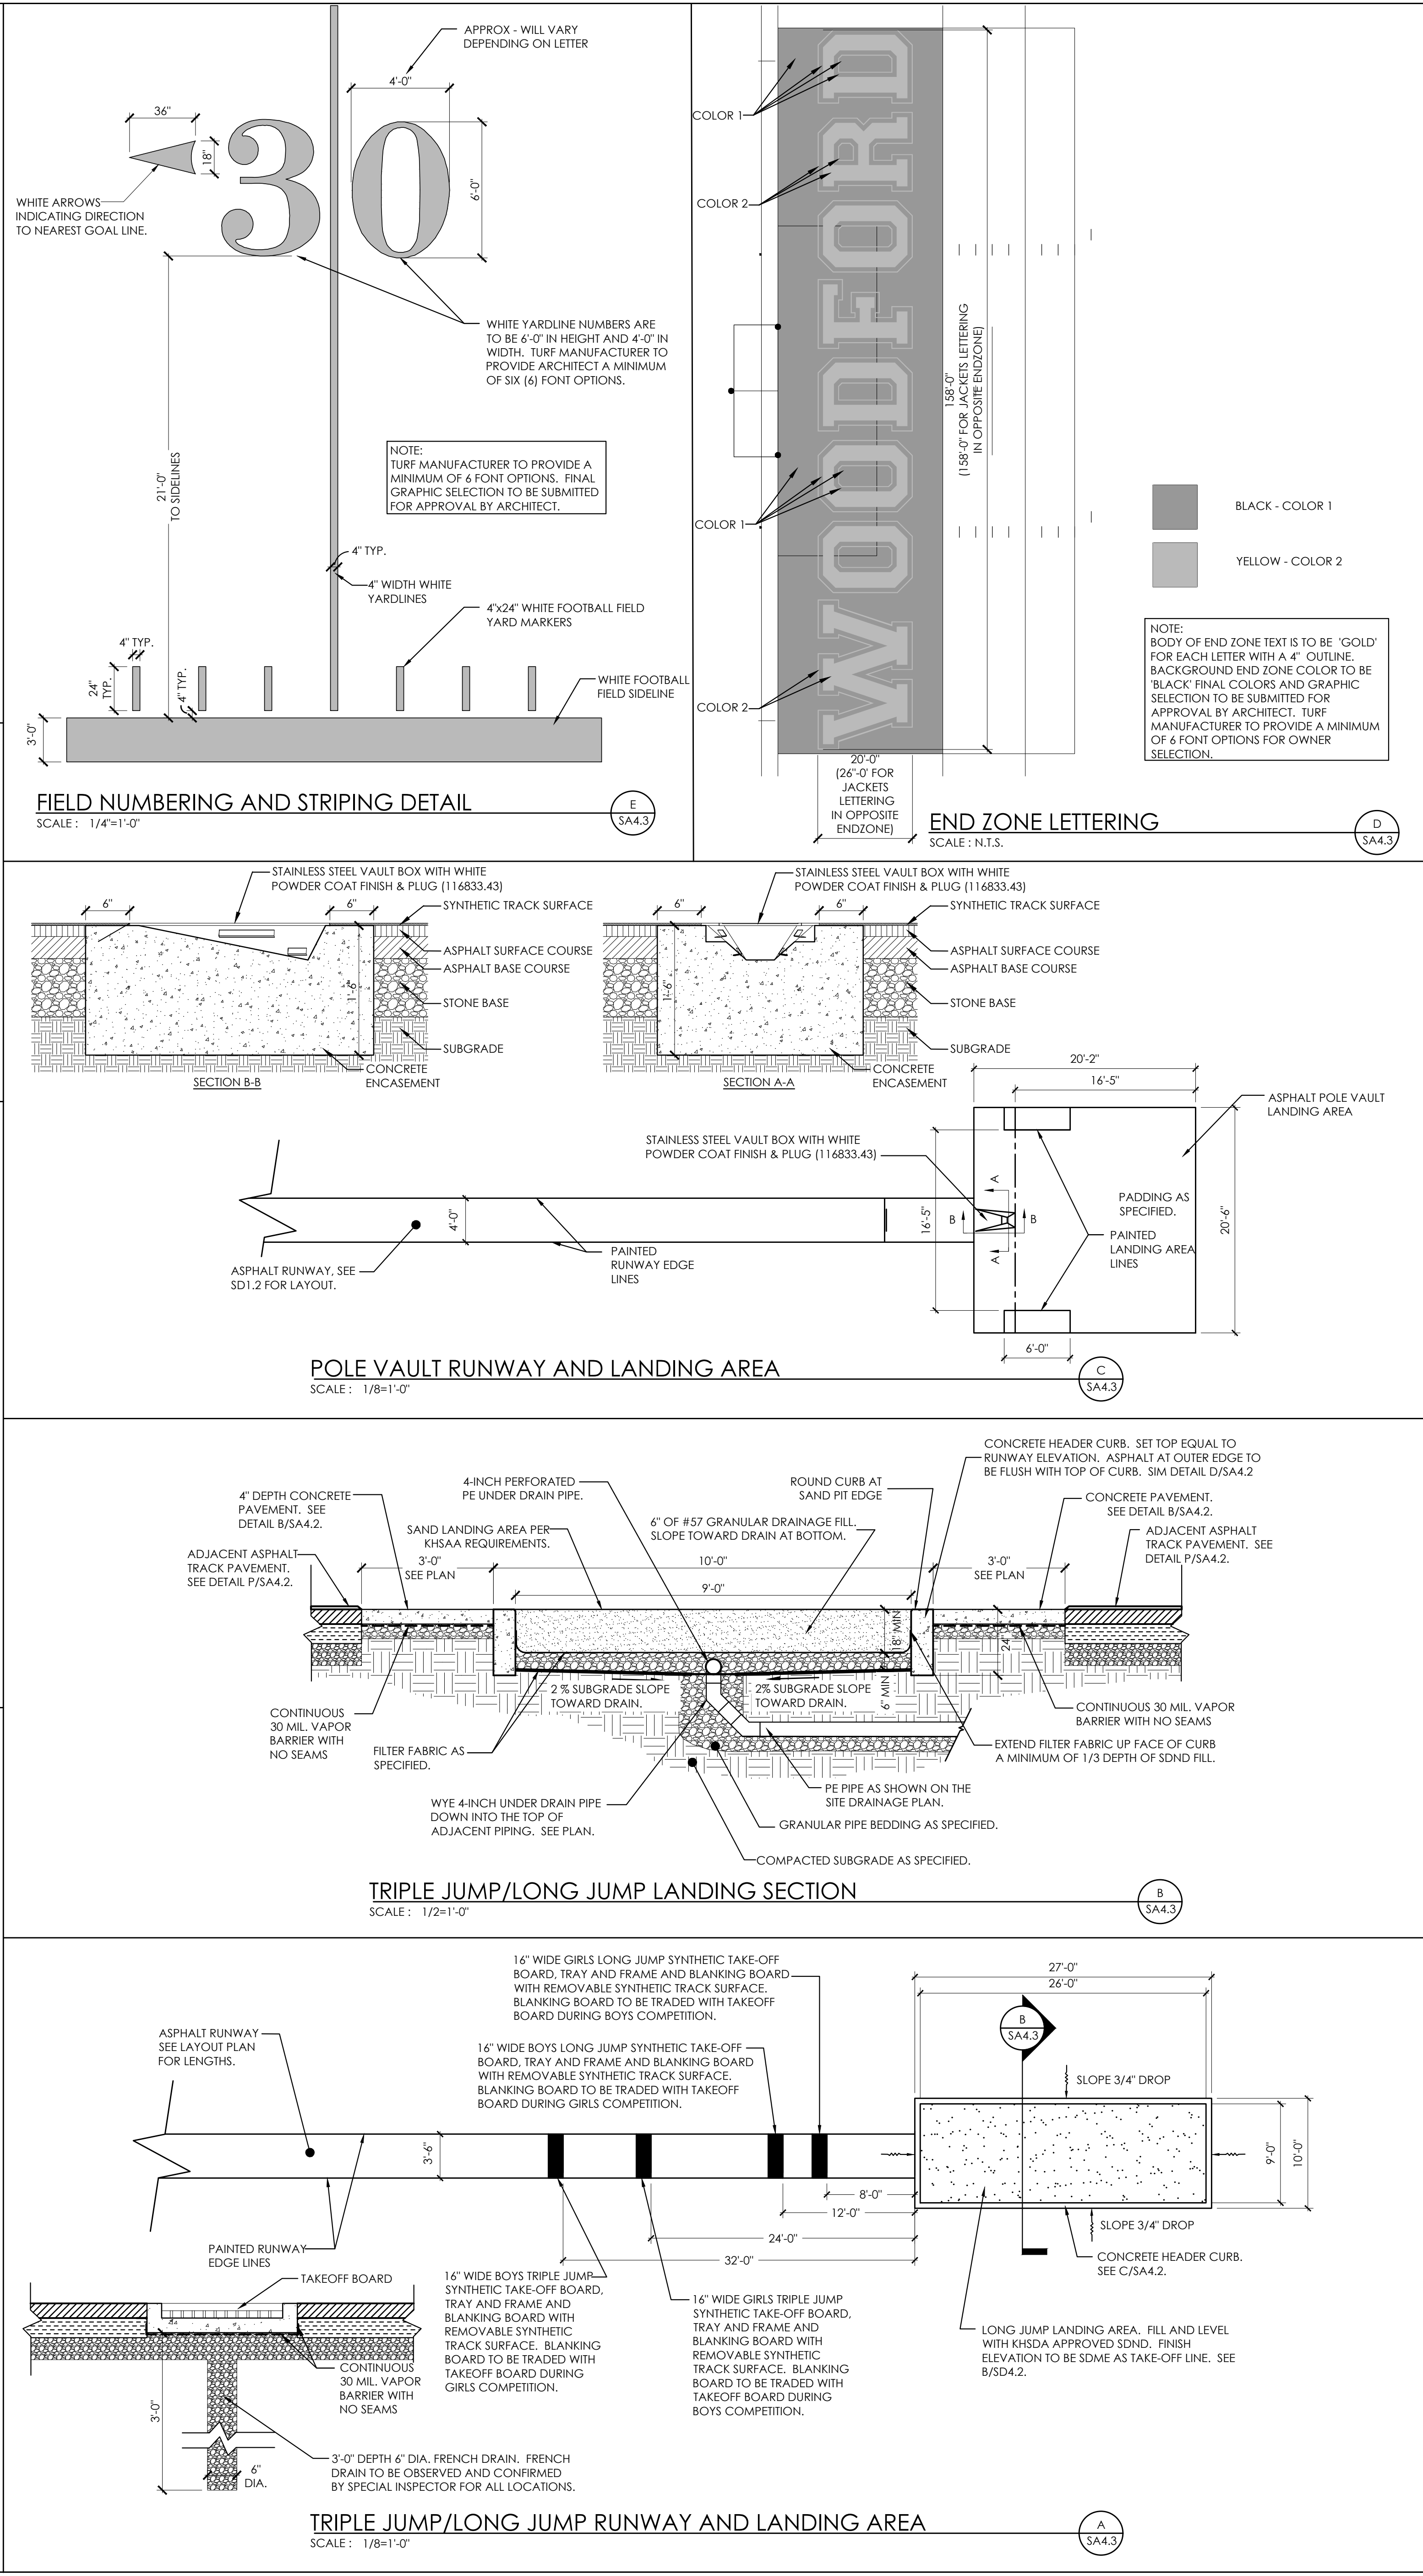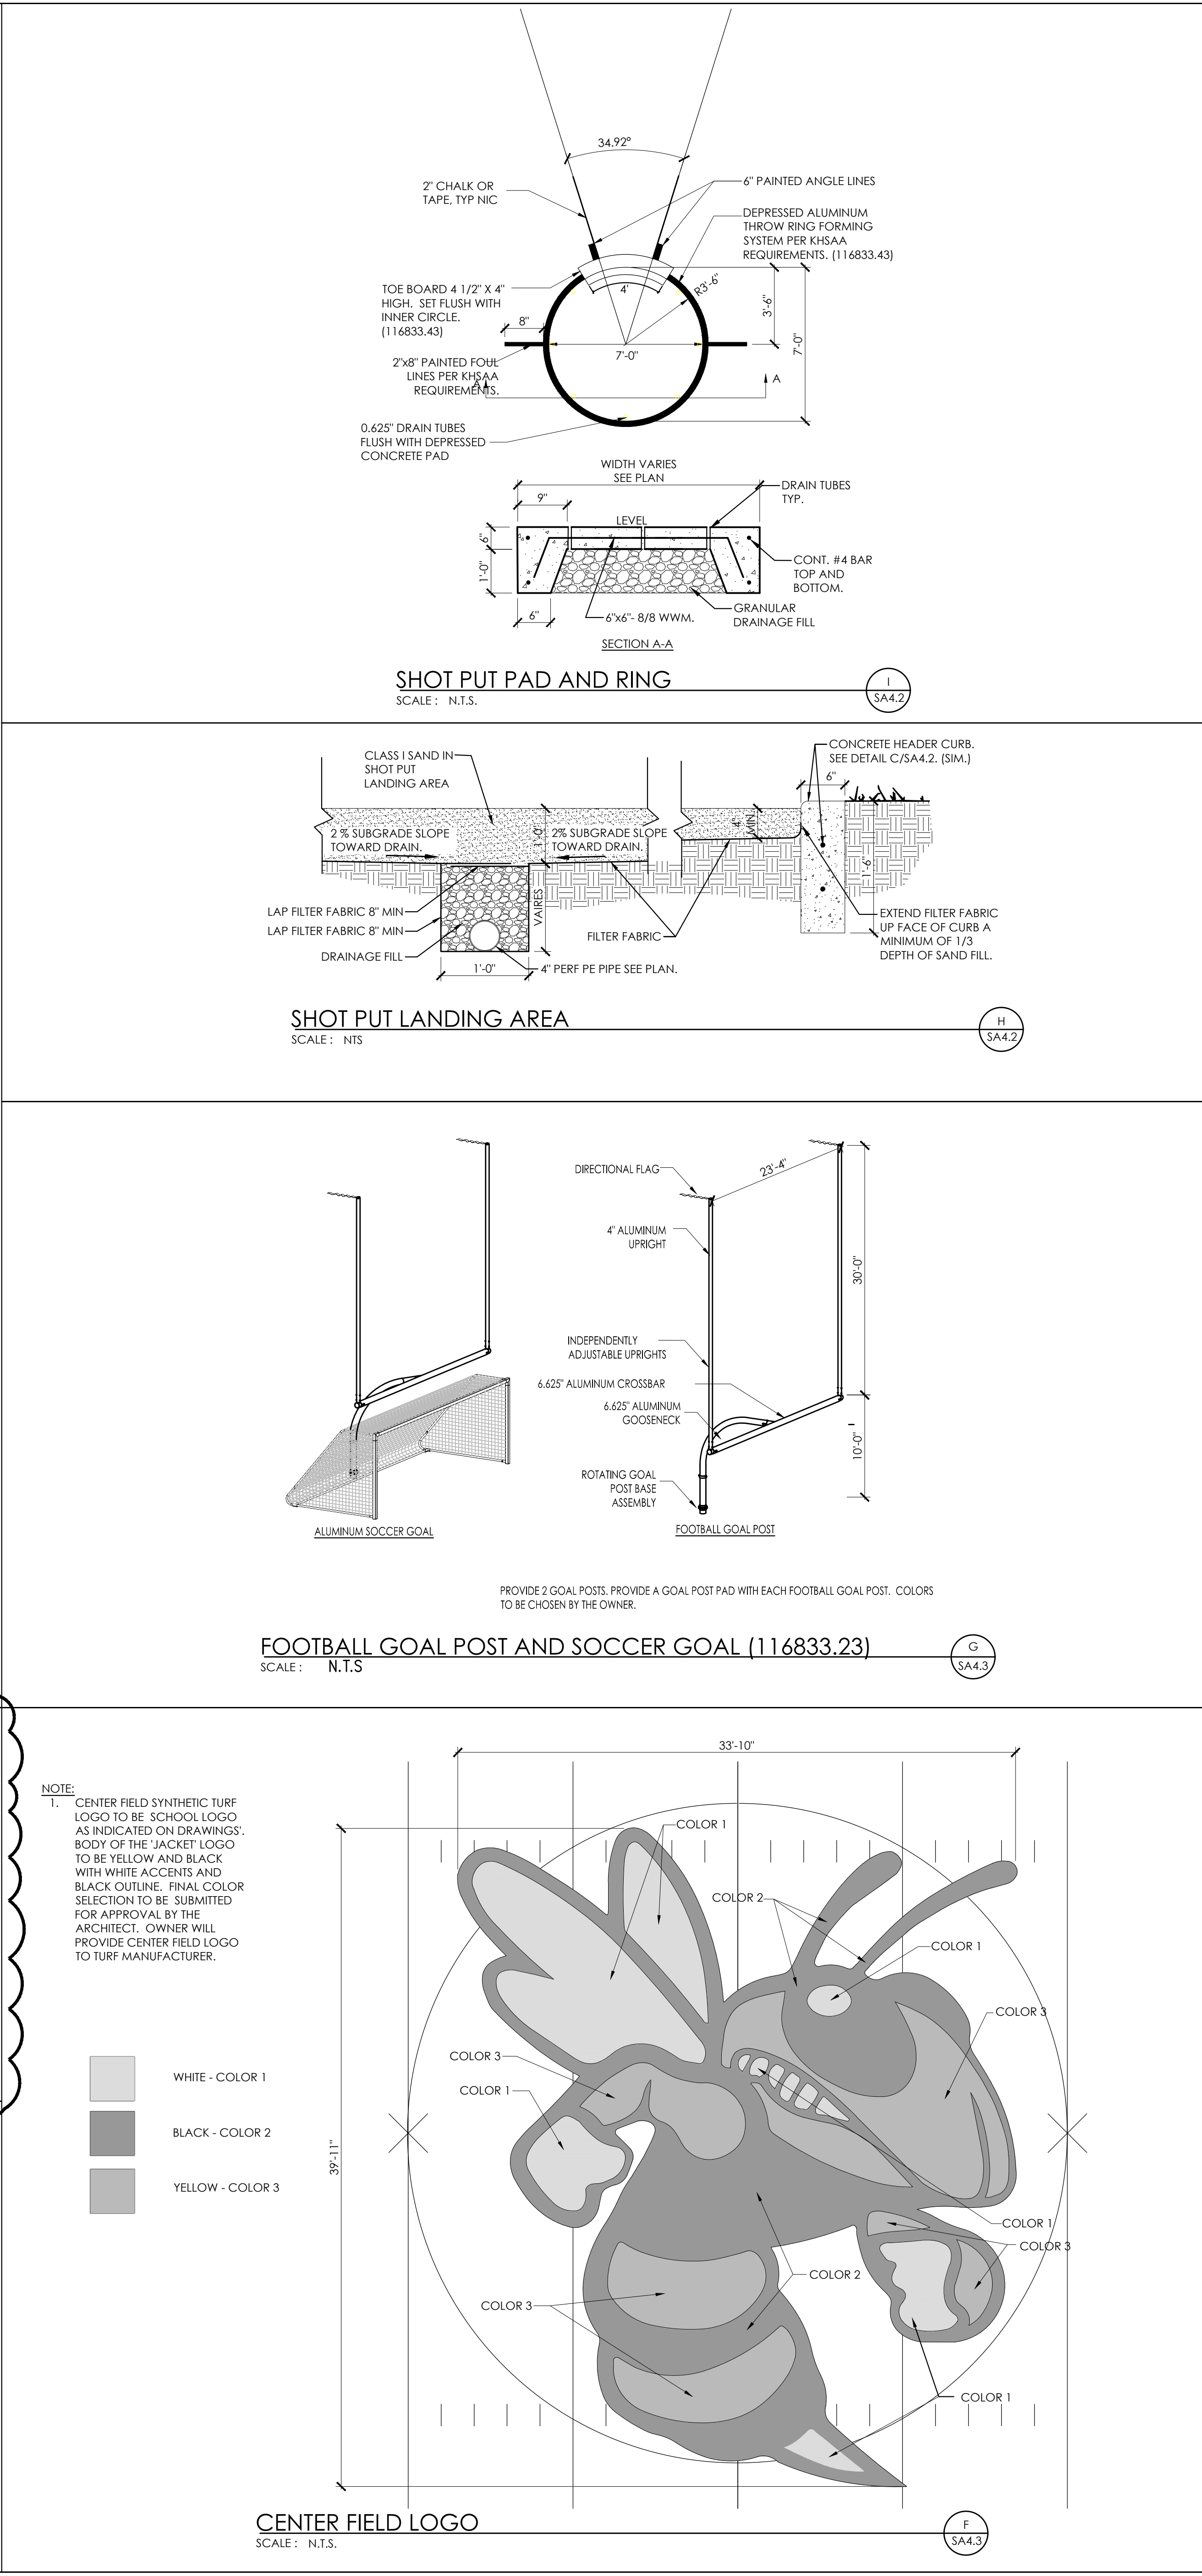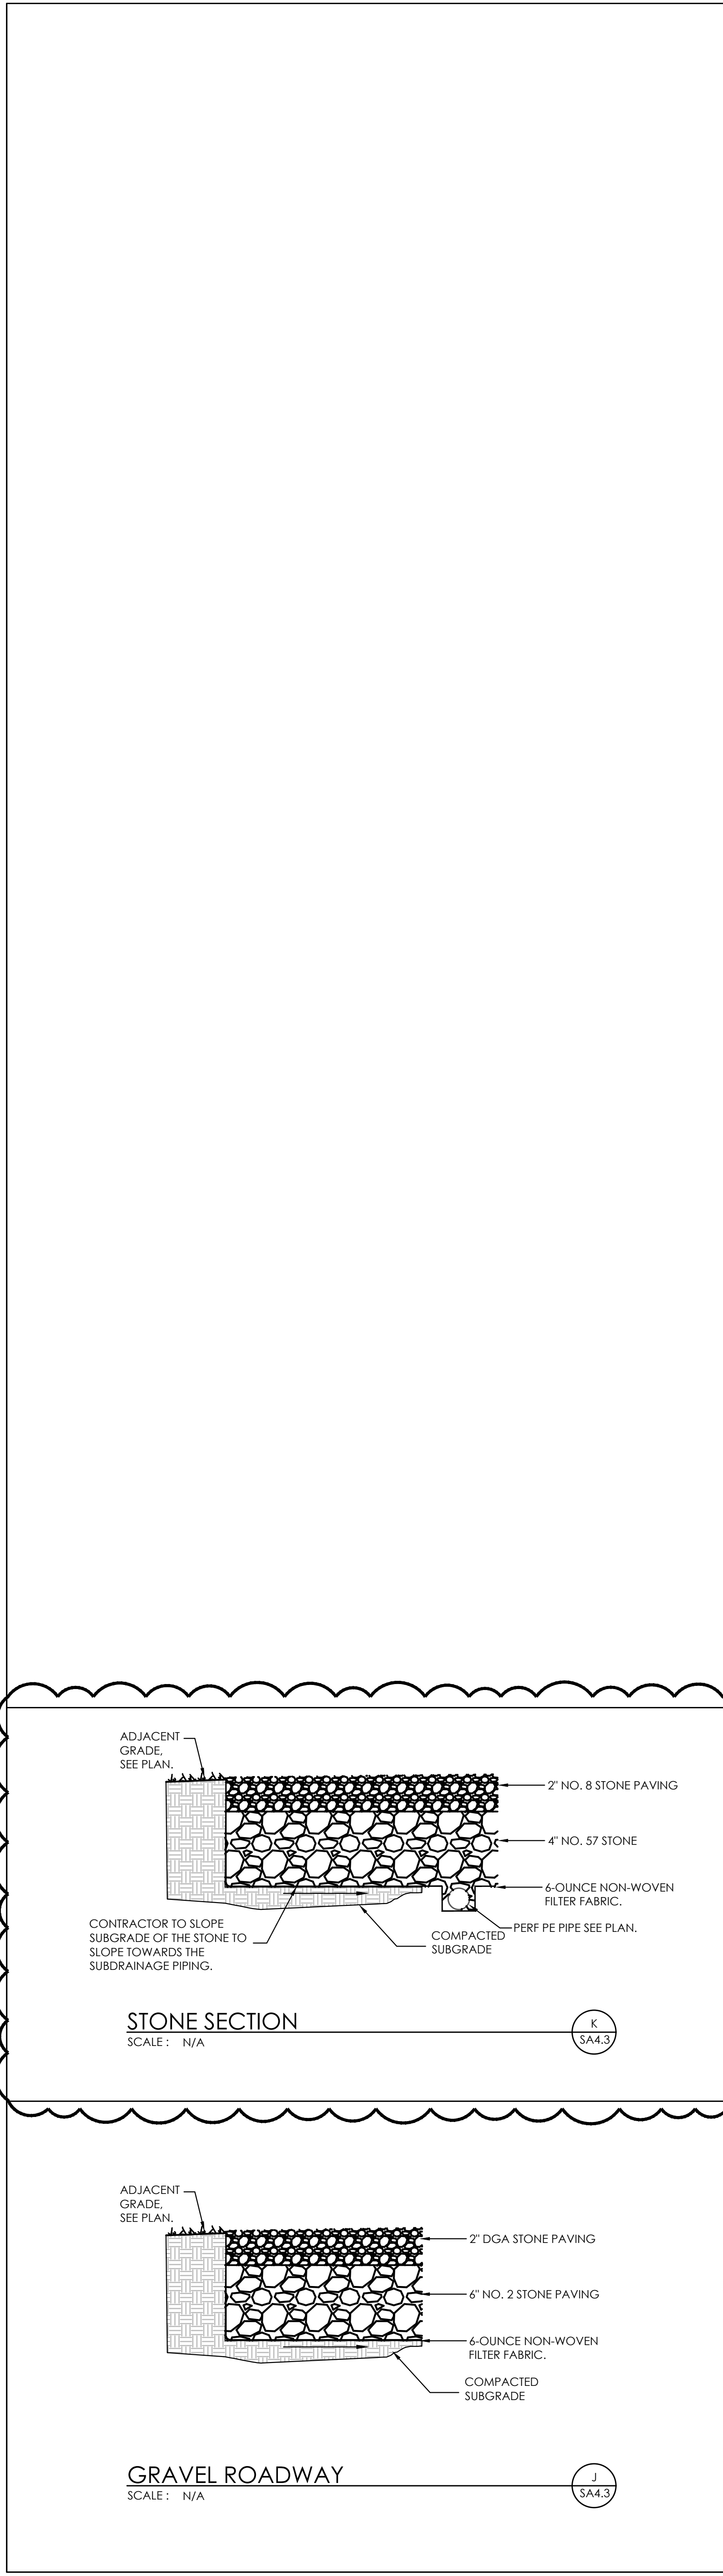

rosrarrant
architects

101 edelroyette avenue leavittown, kentucky 40502 p.859.254.4018

10/28/2022

SITE DETAILS

WOODFORD COUNTY HIGH SCHOOL PHASE 2 PRACTICE FIELD & TRACK

FOR:

WOODFORD COUNTY BOARD OF EDUCATION

330 Pisgah Pike , Kentucky 40383

M.E.&P Engineer:
CM&A, Inc.
2429 Members Way
Lexington, KY 40504
p.859.253.0892

Structural Engineer:
Structural Design Group, Inc.
220 Great Circle Rd., Suite 106
Nashville, TN 37228
p.615.255.5537

Construction Manager:
Traces Creek Construction, Inc.
127 Market Street, Suite 200
PO Box 539
Vanceburg, KY 41179-0539
p.606.796.3867

BG# 23-120

Project No: 1916

Drawn By: ELM/EGS

Rev'd By: MBM/KAM

SHEET RELEASE

1

2

3

4

5

6

7

8

COPYRIGHT © 2022

CONSTRUCTION DOCUMENTS

SA4.3

SITE DETAILS

DATE ISSUED:
10/28/2022



Project Number
50618.1A

Consultants

Professional Seal

[illegible]

Key Plan

Submittal Type

Sheet Title

Foundation Plan


Sheet number

FROST DEPTH - 24"


SOIL BEARING CAPACITY - 2000 PSF

ST110

© 2019 DANT CLAYTON

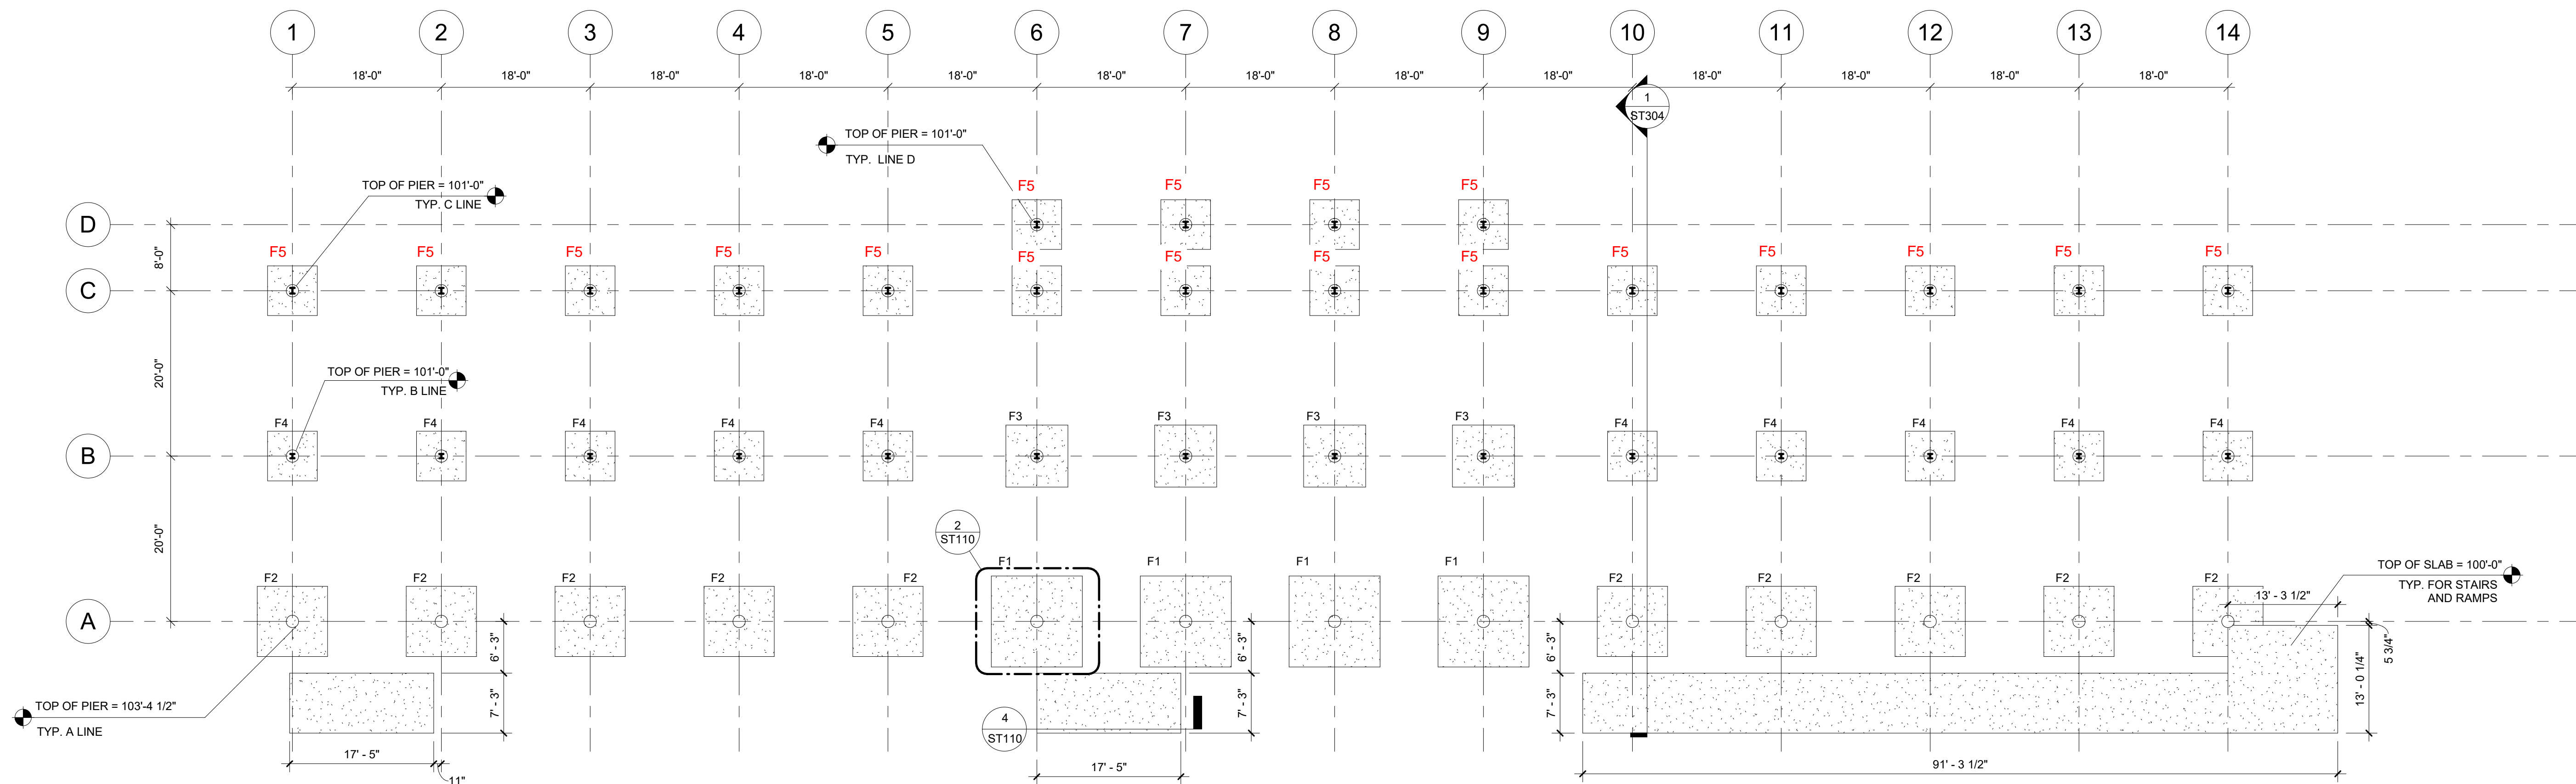


Foundation Plan

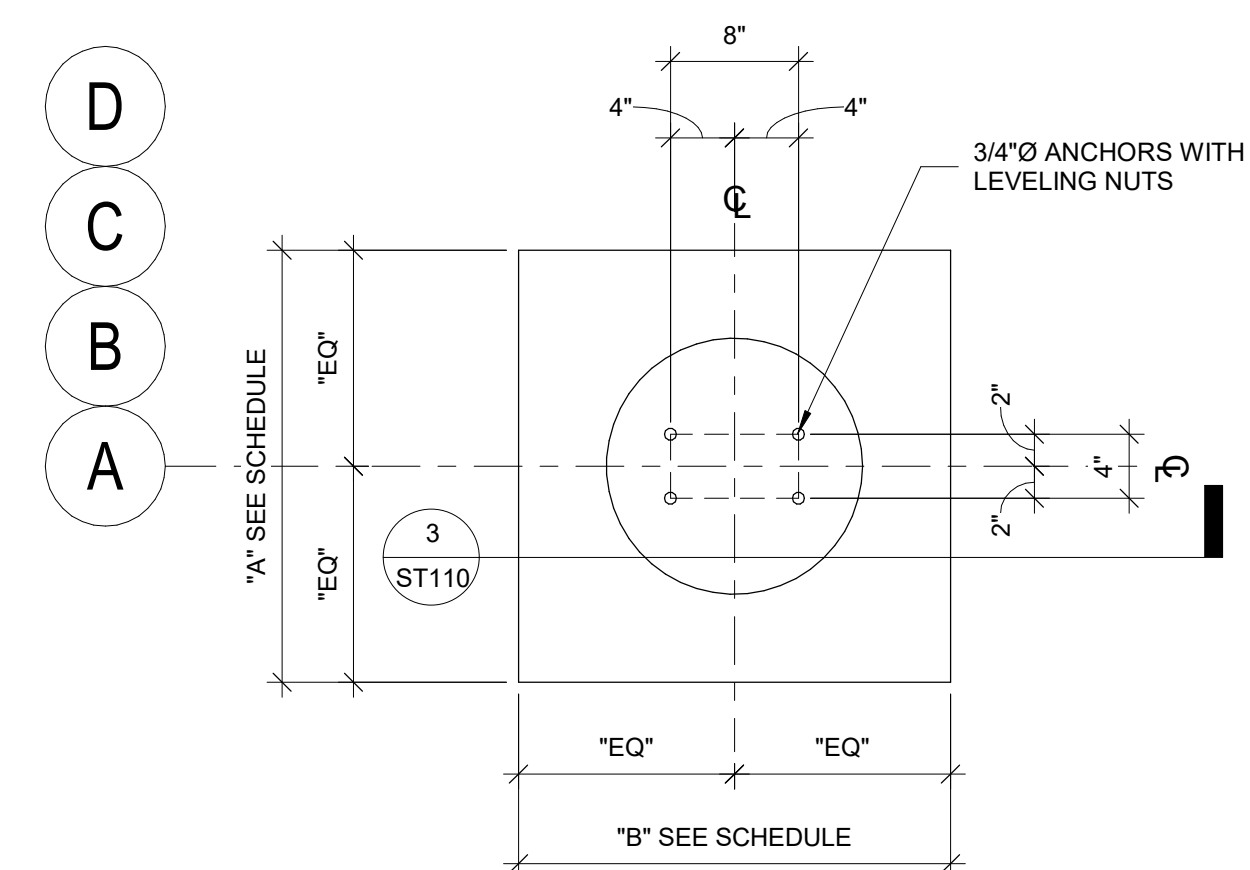

2
ST110

ANCHOR BOLT LAYOUT - PLAN OF FOOTING & PIER


1" = 1'-0"

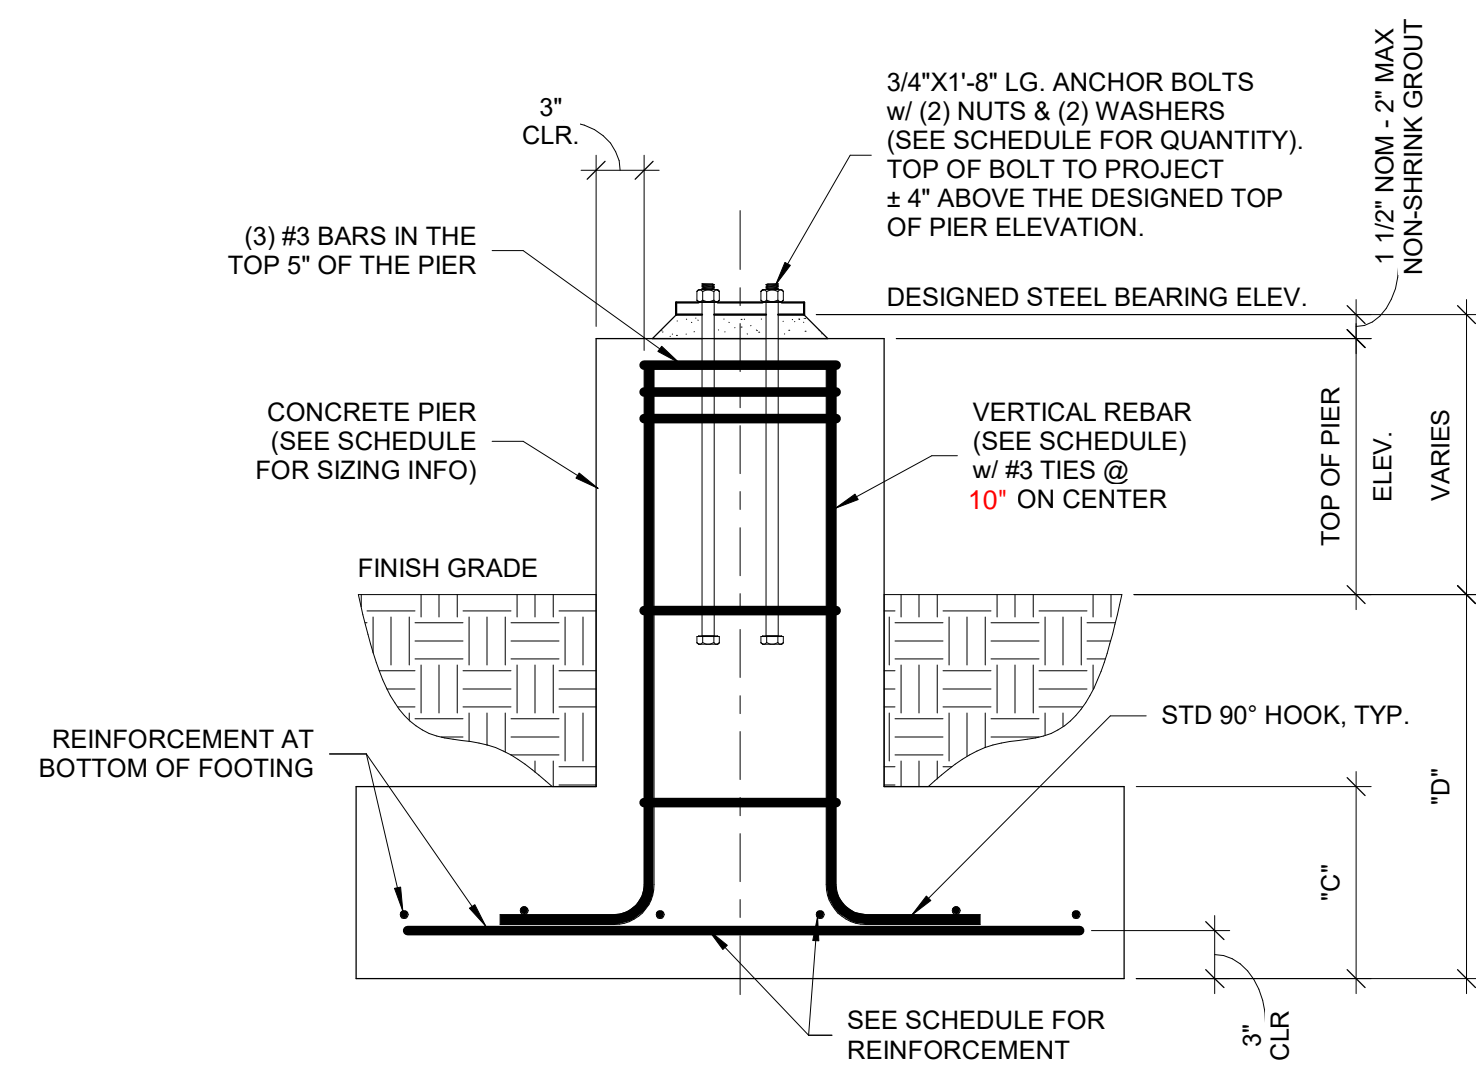

3
ST110


SECTION THRU FOOTER FOUNDATION

1" = 1'-0"

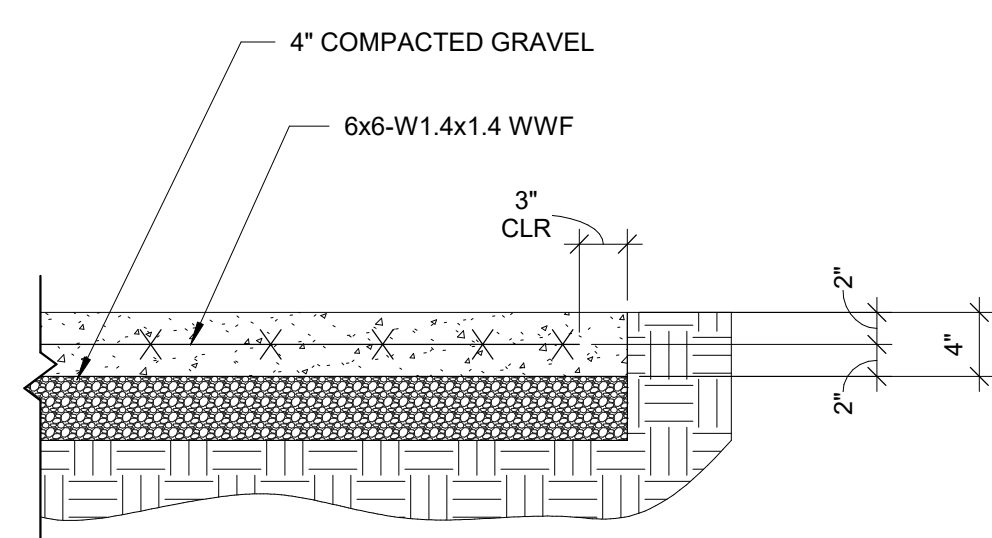

SECTION OF SLAB ON GRADE

| FOOTING SCHEDULE | | | | | PIER SCHEDULE | | | | | |
|------------------|--------|--------|-------|-------|---------------|------|-------------|--------------|---------------------------------|--------------------------|
| MARK | SIZE | | | | REINFORCING | SIZE | REINFORCING | # OF ANCHORS | SIZE OF ANCHORS | ANCHOR BOLT TEMPLATE NO. |
| | "A" | "B" | "C" | "D" | | | | | | |
| F1 | 11'-0" | 11'-0" | 1'-6" | 3'-0" | (14) #5 BOT | 24"ø | (9) #5 BARS | 4 | 3/4"x11'-8" H'VY HEX HEAD GR 55 | 0055517 |
| F2 | 8'-6" | 8'-6" | 1'-6" | 3'-0" | (11) #5 BOT | 24"ø | (8) #5 BARS | 4 | 3/4"x11'-8" H'VY HEX HEAD GR36 | 0055517 |
| F3 | 7'-0" | 7'-0" | 1'-0" | 2'-0" | (7) #5 BOT | 18"ø | (6) #5 BARS | 4 | 3/4"x11'-8" H'VY HEX HEAD GR 55 | 0055517 |
| F4 | 6'-6" | 6'-6" | 1'-0" | 2'-0" | (6) #5 BOT | 18"ø | (6) #5 BARS | 4 | 3/4"x11'-8" H'VY HEX HEAD GR36 | 0055517 |
| F5 | 6'-0" | 6'-0" | 1'-0" | 2'-0" | (6) #5 BOT | 18"ø | (6) #5 BARS | 4 | 3/4"x11'-8" H'VY HEX HEAD GR36 | 0055517 |

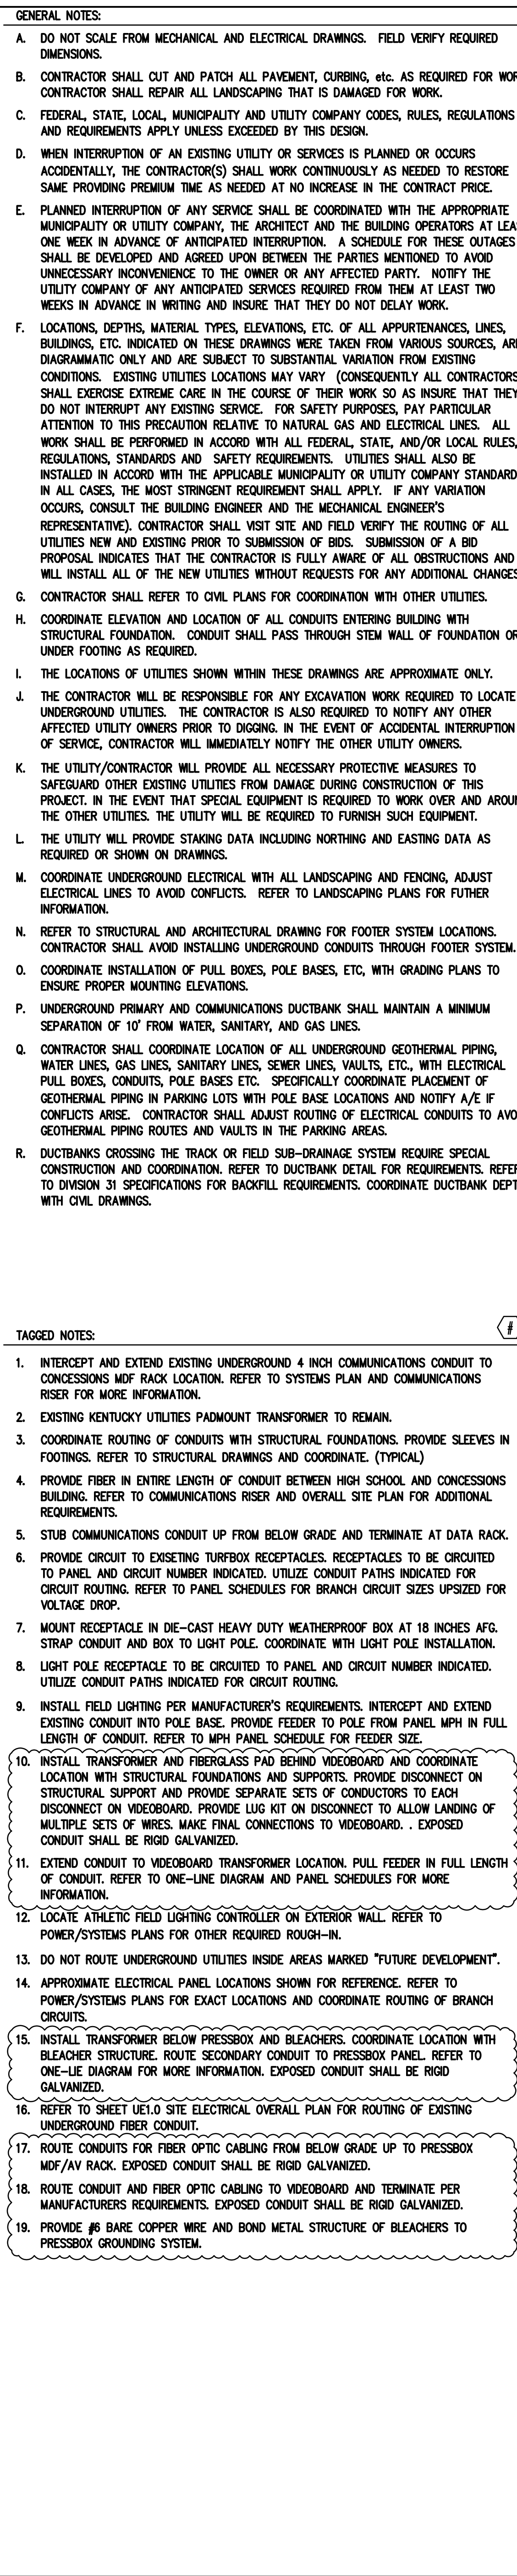

ATHLETIC FIELD LIGHTING (POLES F1, F2, F3, F4), ASSOCIATED FIXTURES, CONTROLS, AND FEEDER CONDUCTORS FROM PANEL MPH ARE TO BE INCLUDED IN ALTERNATE PRICE. UTILIZE EXISTING UNDERGROUND CONDUIT PATHWAYS ON SITE FOR FEEDER ROUTING. EXTEND CONDUITS TO EQUIPMENT AND MAKE ALL FINAL CONNECTIONS. REFER TO EXTERIOR ATHLETIC LIGHTING SPECIFICATIONS FOR MORE INFORMATION.

A. DO NOT SCALE FROM MECHANICAL AND ELECTRICAL DRAWINGS. FIELD VERIFY REQUIRED DIMENSIONS.

B. CONTRACTOR SHALL CUT AND PATCH ALL PAVEMENT, CURBING, ETC. AS REQUIRED FOR WORK. CONTRACTOR SHALL REPAIR ALL LANDSCAPING THAT IS DAMAGED FOR WORK.

C. FEDERAL, STATE, LOCAL, MUNICIPALITY AND UTILITY COMPANY CODES, RULES, REGULATIONS AND REQUIREMENTS APPLY UNLESS EXCEEDED BY THIS DESIGN.

D. WHEN INTERRUPTION OF AN EXISTING UTILITY OR SERVICES IS PLANNED OR OCCURS ACCIDENTALLY, THE CONTRACTOR(S) SHALL WORK CONTINUOUSLY, AS NEEDED TO RESTORE SAME PROVIDING PREMIUM TIME AS NEEDED AT NO INCREASE IN THE CONTRACT PRICE.

E. PLANNED INTERRUPTION OF ANY SERVICE SHALL BE COORDINATED WITH THE APPROPRIATE MUNICIPALITY OR UTILITY COMPANY, THE ARCHITECT, AND THE BUENA VISTA OPERATORS AT LEAST ONE MONTH IN ADVANCE OF ANY PLANNED INTERRUPTION. A SCHEDULE FOR THESE OUTAGES SHALL BE DEVELOPED AND AGREED UPON BETWEEN THE PARTIES MENTIONED TO AVOID UNNECESSARY INCONVENIENCE TO THE OWNER OR ANY AFFECTED PARTY. NOTIFY THE UTILITY COMPANY OF ANY ANTICIPATED SERVICES REQUIRED FROM THEM AT LEAST TWO WEEKS IN ADVANCE IN WRITING AND INSURE THAT THEY DO NOT DELAY WORK.

F. LOCATIONS, DEPTHS, MATERIAL TYPES, ELEVATIONS, ETC. OF ALL APPURTENANCES, LINES, BUILDINGS, ETC. INDICATED ON DRAWINGS, SHALL BE FIELD VERIFIED. ALL MATERIALS, SOURCES, OR DIAGRAMS, AND UTILITIES ARE AND ARE SUBJECT TO SUBSTANTIAL VARIATION FROM EXISTING CONDITIONS. EXISTING UTILITIES LOCATIONS MAY VARY (CONSEQUENTLY ALL CONTRACTORS SHALL EXERCISE EXTREME CARE IN THE COURSE OF THEIR WORK SO AS INSURE THAT THEY DO NOT INTERRUPT ANY EXISTING SERVICE. FOR SAFETY PURPOSES, PAY PARTICULAR ATTENTION TO THIS PRECAUTION RELATIVE TO NATURAL GAS AND ELECTRICAL LINES). WORK TO BE PERFORMED IN ACCORD WITH ALL FEDERAL, STATE, AND/OR LOCAL RULES, REGULATIONS, STANDARDS AND SAFETY REQUIREMENTS. UTILITIES SHALL ALSO BE INSTALLED IN ACCORD WITH THE APPLICABLE MUNICIPALITY OR UTILITY COMPANY STANDARD. IN ALL CASES, THE MOST STRINGENT REGULATION SHALL APPLY. IF ANY VARIATION OCCURS, CONSULT THE BUILDING ENGINEER AND THE MECHANICAL ENGINEER (S) REPRESENTATIVE). CONTRACTOR SHALL VISIT SITE AND FIELD VERIFY THE ROUTING OF ALL UTILITIES NEW AND EXISTING PRIOR TO SUBMISSION OF BIDS. SUBMISSION OF A BID PROHIBITS THAT THE CONTRACTOR IS FULLY AWARE OF ALL OBSTRUCTIONS AND WILL INSTALL ALL OF THE NEW UTILITIES WITHOUT REQUESTS FOR ANY ADDITIONAL CHANGES.

G. CONTRACTOR SHALL REFER TO CIVIL PLANS FOR COORDINATION WITH OTHER UTILITIES.

H. COORDINATE ELEVATION AND LOCATION OF ALL CONDUITS ENTERING BUILDING WITH STRUCTURAL FOUNDATION. CONDUIT SHALL PASS THROUGH STEEL WALL OF FOUNDATION OR UNDER FOOTING AS REQUIRED.

I. THE LOCATIONS OF UTILITIES SHOWN WITHIN THESE DRAWINGS ARE APPROXIMATE ONLY.

J. THE CONTRACTOR WILL BE RESPONSIBLE FOR ANY EXCAVATION WORK REQUIRED TO LOCATE UNDERGROUND UTILITIES. THE CONTRACTOR IS ALSO REQUIRED TO NOTIFY ANY OTHER AFFECTED UTILITY OWNERS PRIOR TO DIGGING. IN THE EVENT OF ACCIDENTAL INTERRUPTION OF SERVICE, CONTRACTOR WILL IMMEDIATELY NOTIFY THE OTHER UTILITY OWNERS.

K. THE UTILITY/CONTRACTOR WILL PROVIDE ALL NECESSARY PROTECTIVE MEASURES TO SAFEGUARD OTHER EXISTING UTILITIES FROM DAMAGE DURING CONSTRUCTION OF THIS PROJECT. IN THE EVENT THAT SPECIAL EQUIPMENT IS REQUIRED TO WORK OVER AND AROUND THE OTHER UTILITIES, THE UTILITY WILL BE REQUIRED TO FURNISH SUCH EQUIPMENT.

L. THE UTILITY WILL PROVIDE STAKING DATA INCLUDING NORTHING AND EASTING DATA AS REQUIRED FOR STAKING OF CONDUITS AND LINES.

M. COORDINATE UNDERGROUND ELECTRICAL WITH ALL LANDSCAPING AND FENCING, ADJUST ELECTRICAL LINES TO AVOID CONFLICTS. REFER TO LANDSCAPING PLANS FOR FURTHER INFORMATION.

N. REFER TO STRUCTURAL AND ARCHITECTURAL DRAWING FOR FOOTER SYSTEM LOCATIONS. CONTRACTOR SHALL AVOID INSTALLING UNDERGROUND CONDUITS THROUGH FOOTER SYSTEM.

O. COORDINATE INSTALLATION OF PULL BOXES, POLE BASES, ETC. WITH GRADING PLANS TO ENSURE PROPER MOUNTING ELEVATIONS.


P. IN UNDERGROUND PRIMARY AND COMMUNICATIONS DUCTBANK SHALL MAINTAIN A MINIMUM SEPARATION OF 10' FROM WATER, SANITARY, AND GAS LINES.

Q. CONTRACTOR SHALL COORDINATE LOCATION OF ALL UNDERGROUND GEOTHERMAL PIPING, WATER LINES, GAS LINES, SANITARY LINES, SEWER LINES, VAULTS, ETC., WITH ELECTRICAL PULL BOXES, CONDUITS, POLE BASES ETC. SPECIFICALLY COORDINATE PLACEMENT OF GEOTHERMAL PIPING IN PARKING LOTS WITH POLE BASE LOCATIONS AND NOTIFY A/E IF CONFLICTS ARISE. CONTRACTOR SHALL ADJUST ROUTING OF ELECTRICAL CONDUITS TO AVOID GEOTHERMAL PIPING ROUTES AND VAULTS.



R. DUCTBANKS CROSSING THE TRACK OR FIELD SUB-DRAINAGE SYSTEM REQUIRE SPECIAL CONSTRUCTION AND COORDINATION. REFER TO DUCTBANK DETAIL FOR REQUIREMENTS. REFER TO DIVISION 31 SPECIFICATIONS FOR BACKFILL REQUIREMENTS. COORDINATE DUCTBANK DEPTH WITH CIVIL DRAWINGS.

1. INTERCEPT AND EXTEND EXISTING UNDERGROUND 4 INCH COMMUNICATIONS CONDUIT TO CONCESSIONS MDf RACK LOCATION. REFER TO SYSTEMS PLAN AND COMMUNICATIONS Riser FOR MORE INFORMATION.
2. EXISTING KENTUCKY UTILITIES PADMOUNT TRANSFORMER TO REMAIN.
3. COORDINATE ROUTING OF CONDUITS WITH STRUCTURAL FOUNDATIONS. PROVIDE SLEEVES IN FOOTINGS. REFER TO STRUCTURAL DRAWINGS AND COORDINATE. (TYPICAL)
4. PROVIDE FIBER IN ENTIRE LENGTH OF CONDUIT BETWEEN HIGH SCHOOL AND CONCESSIONS BUILDING. REFER TO COMMUNICATIONS RISER AND OVERALL SITE PLAN FOR ADDITIONAL REQUIREMENTS.
5. STUB COMMUNICATIONS CONDUIT UP FROM BELOW GRADE AND TERMINATE AT DATA RACK.
6. PROVIDE CIRCUIT TO EXISTING TURBOBOX RECEPTABLES. RECEPTABLES TO BE CIRCUITED TO PANEL AND CIRCUIT NUMBER INDICATED. UTILIZE CONDUIT PATHS INDICATED FOR CIRCUIT ROUTING. REFER TO PANEL SCHEDULES FOR BRANCH CIRCUIT SIZES UPSIZED FOR VOLTAGE DROP.
7. MOUNT RECEPTACLE IN DE-CAST HEAVY DUTY WEATHERPROOF BOX AT 18 INCHES AFG. STRAP CONDUIT AND BOX TO LIGHT POLE. COORDINATE WITH LIGHT POLE INSTALLATION.
8. LIGHT POLE RECEPTABLE TO BE CIRCUITED TO PANEL AND CIRCUIT NUMBER INDICATED. UTILIZE POLE PATHS INDICATED FOR CIRCUIT ROUTING.
9. INSTALL FIELD LIGHTING PER MANUFACTURER'S REQUIREMENTS. INTERCEPT AND EXISTING CONDUIT INTO POLE BASE. PROVIDE FEEDER TO POLE FROM PANEL. MPH IN FULL LENGTH OF CONDUIT. REFER TO MPH PANEL SCHEDULE FOR FEEDER SIZE.
10. INSTALL TRANSFORMER AND FIBERGLASS PAD BEHIND VIDEOBOARD AND COORDINATE LOCATION WITH STRUCTURAL FOUNDATIONS AND SUPPORTS. PROVIDE DISCONNECT ON STRUCTURAL SUPPORT AND PROVIDE SEPARATE SETS OF CONDUCTORS TO EACH DISCONNECT ON VIDEOBOARD. PROVIDE LUG KIT ON DISCONNECT TO ALLOW LANDING OF MULTIPLE SETS OF WIRES. MAKE FINAL CONNECTIONS TO VIDEOBOARD. , EXPOSED CONDUIT SHALL BE RIGID GALVANIZED.
11. EXTEND CONDUIT TO VIDEOBOARD TRANSFORMER LOCATION. FULL FEEDER IN FULL LENGTH OF CONDUIT. REFER TO ONE-LINE DIAGRAM AND PANEL SCHEDULES FOR MORE INFORMATION.
12. LOCATE ATHLETIC FIELD LIGHTING CONTROLLER ON EXTERIOR WALL. REFER TO POWER/SYSTEMS PLANS FOR OTHER REQUIRED RUCK-IN.
13. DO NOT ROUTE UNDERGROUND UTILITIES INSIDE AREAS MARKED "FUTURE DEVELOPMENT"
14. APPROXIMATE ELECTRICAL PANEL LOCATIONS SHOWN FOR REFERENCE. REFER TO POWER/SYSTEMS PLANS FOR EXACT LOCATIONS AND COORDINATE ROUTING OF BRANCH CIRCUITS.
15. INSTALL TRANSFORMER BELOW SECONDARY CONDUIT AND BLEACHERS. COORDINATE LOCATION WITH BLEACHER STRUCTURE. ROUTE PREPRESSBOX CONDUIT TO PREPRESSBOX PANEL. REFER TO ONE-LINE DIAGRAM FOR MORE INFORMATION. EXPOSED CONDUIT SHALL BE RIGID GALVANIZED.
16. REFER TO SHEET UEL0.1 SITE ELECTRICAL OVERALL PLAN FOR ROUTING OF EXISTING UNDERGROUND FIBER CONDUIT.
17. ROUTE CONDUITS FOR FIBER OPTIC CABLING FROM BELOW GRADE UP TO PREPRESSBOX MDf/AV RACK. EXPOSED CONDUIT SHALL BE RIGID GALVANIZED.
18. ROUTE CONDUIT AND FIBER OPTIC CABLING TO VIDEOBOARD AND TERMINATE PER MANUFACTURERS REQUIREMENTS. EXPOSED CONDUIT SHALL BE RIGID GALVANIZED.
19. PROVIDE #6 BARE COPPER WIRE AND BOND METAL STRUCTURE OF BLEACHERS TO PREPRESSBOX GROUNDING SYSTEM.



| # | DATE | DESCRIPTION |
|-----|------------|-------------|
| 1 | 10/08/2024 | PR-06 |
| 2 | | |
| 3 | | |
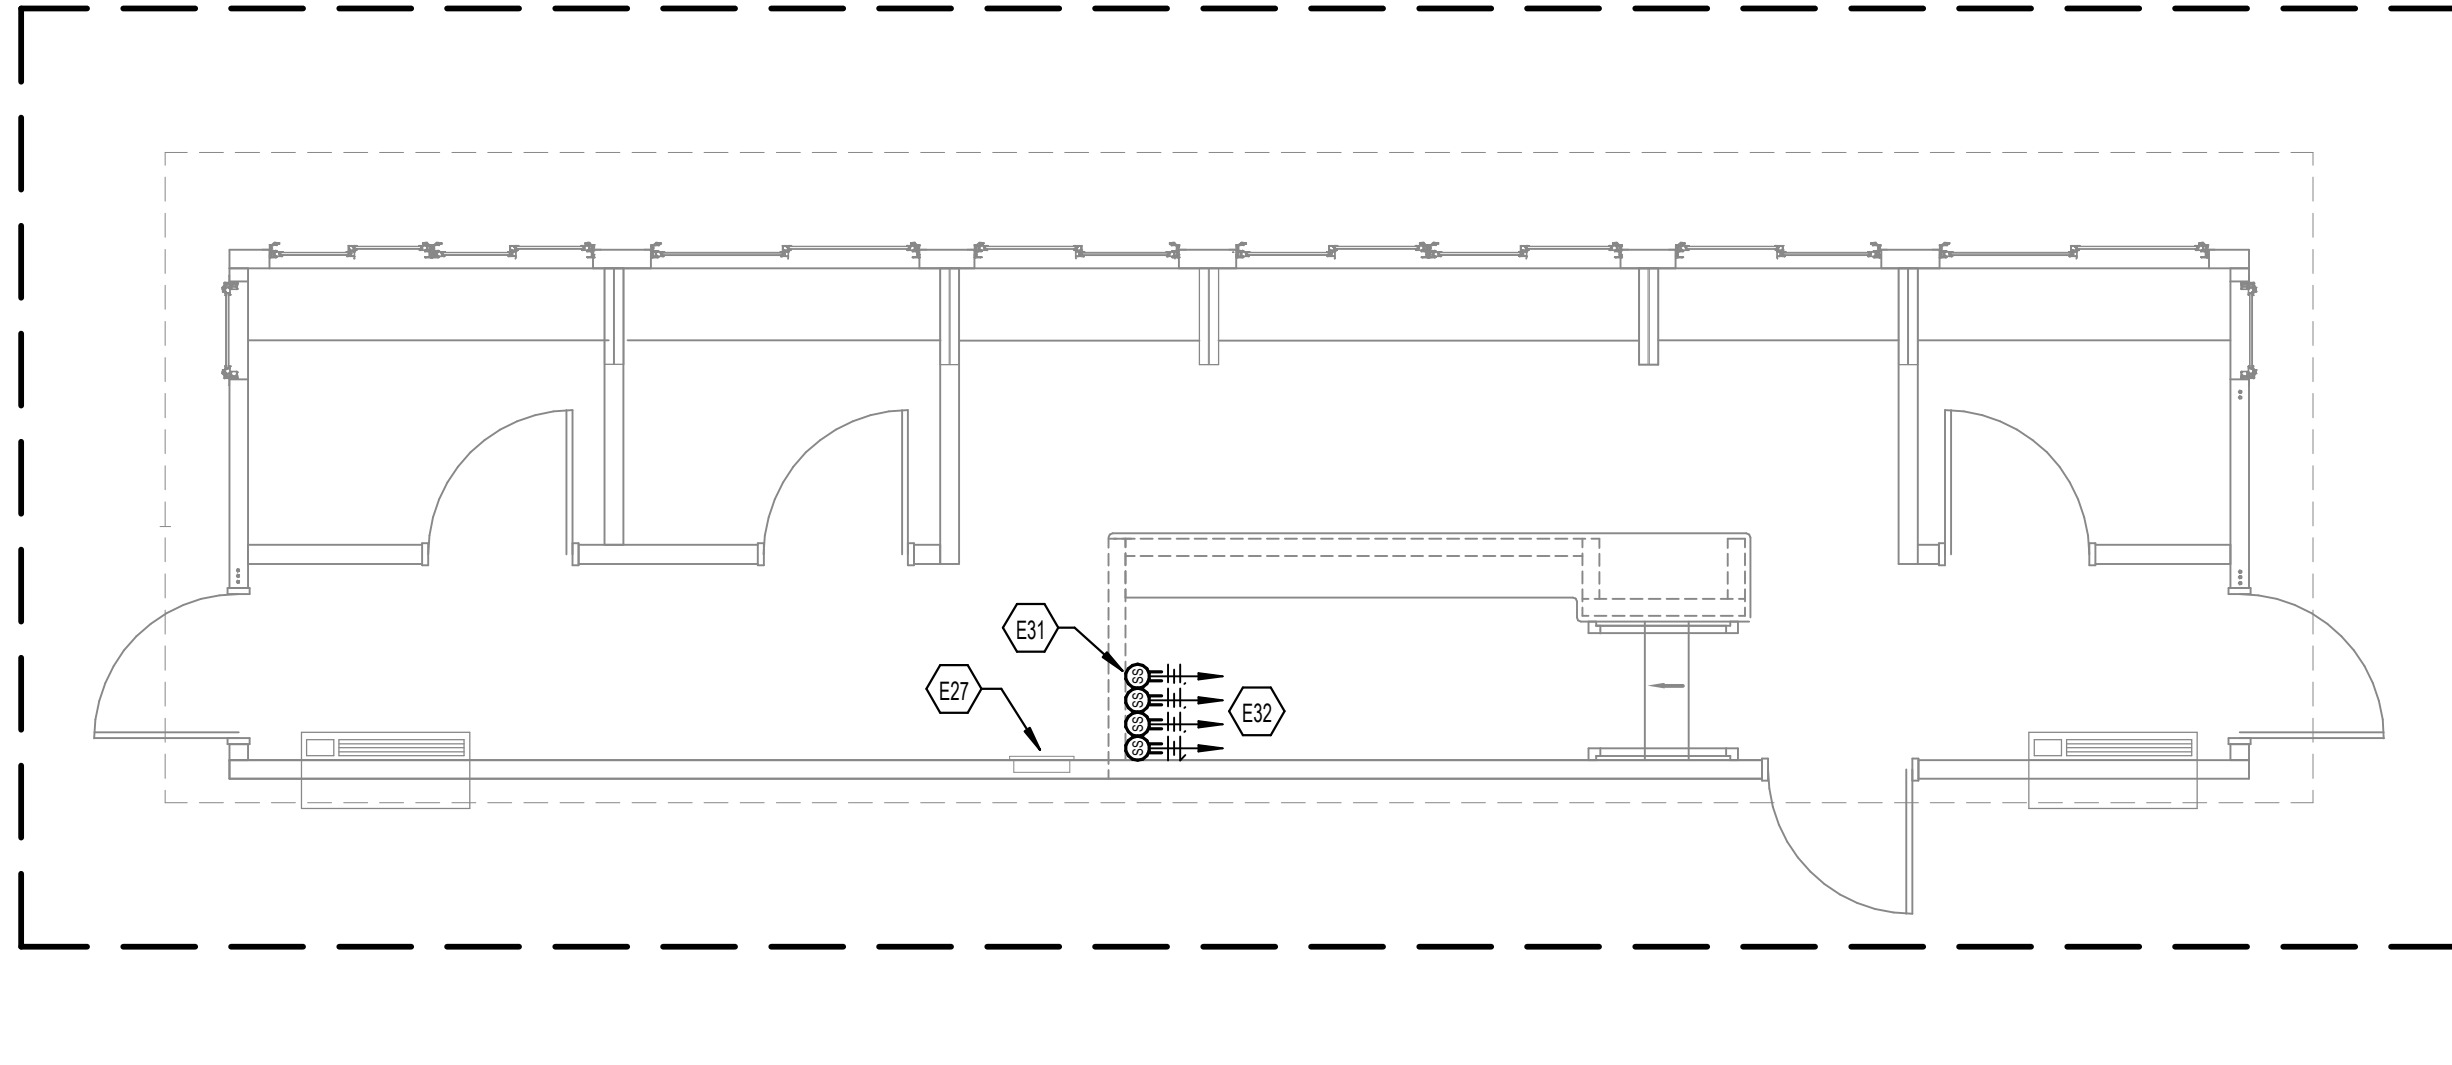

1 LIGHTING/POWER PRESSBOX PLAN

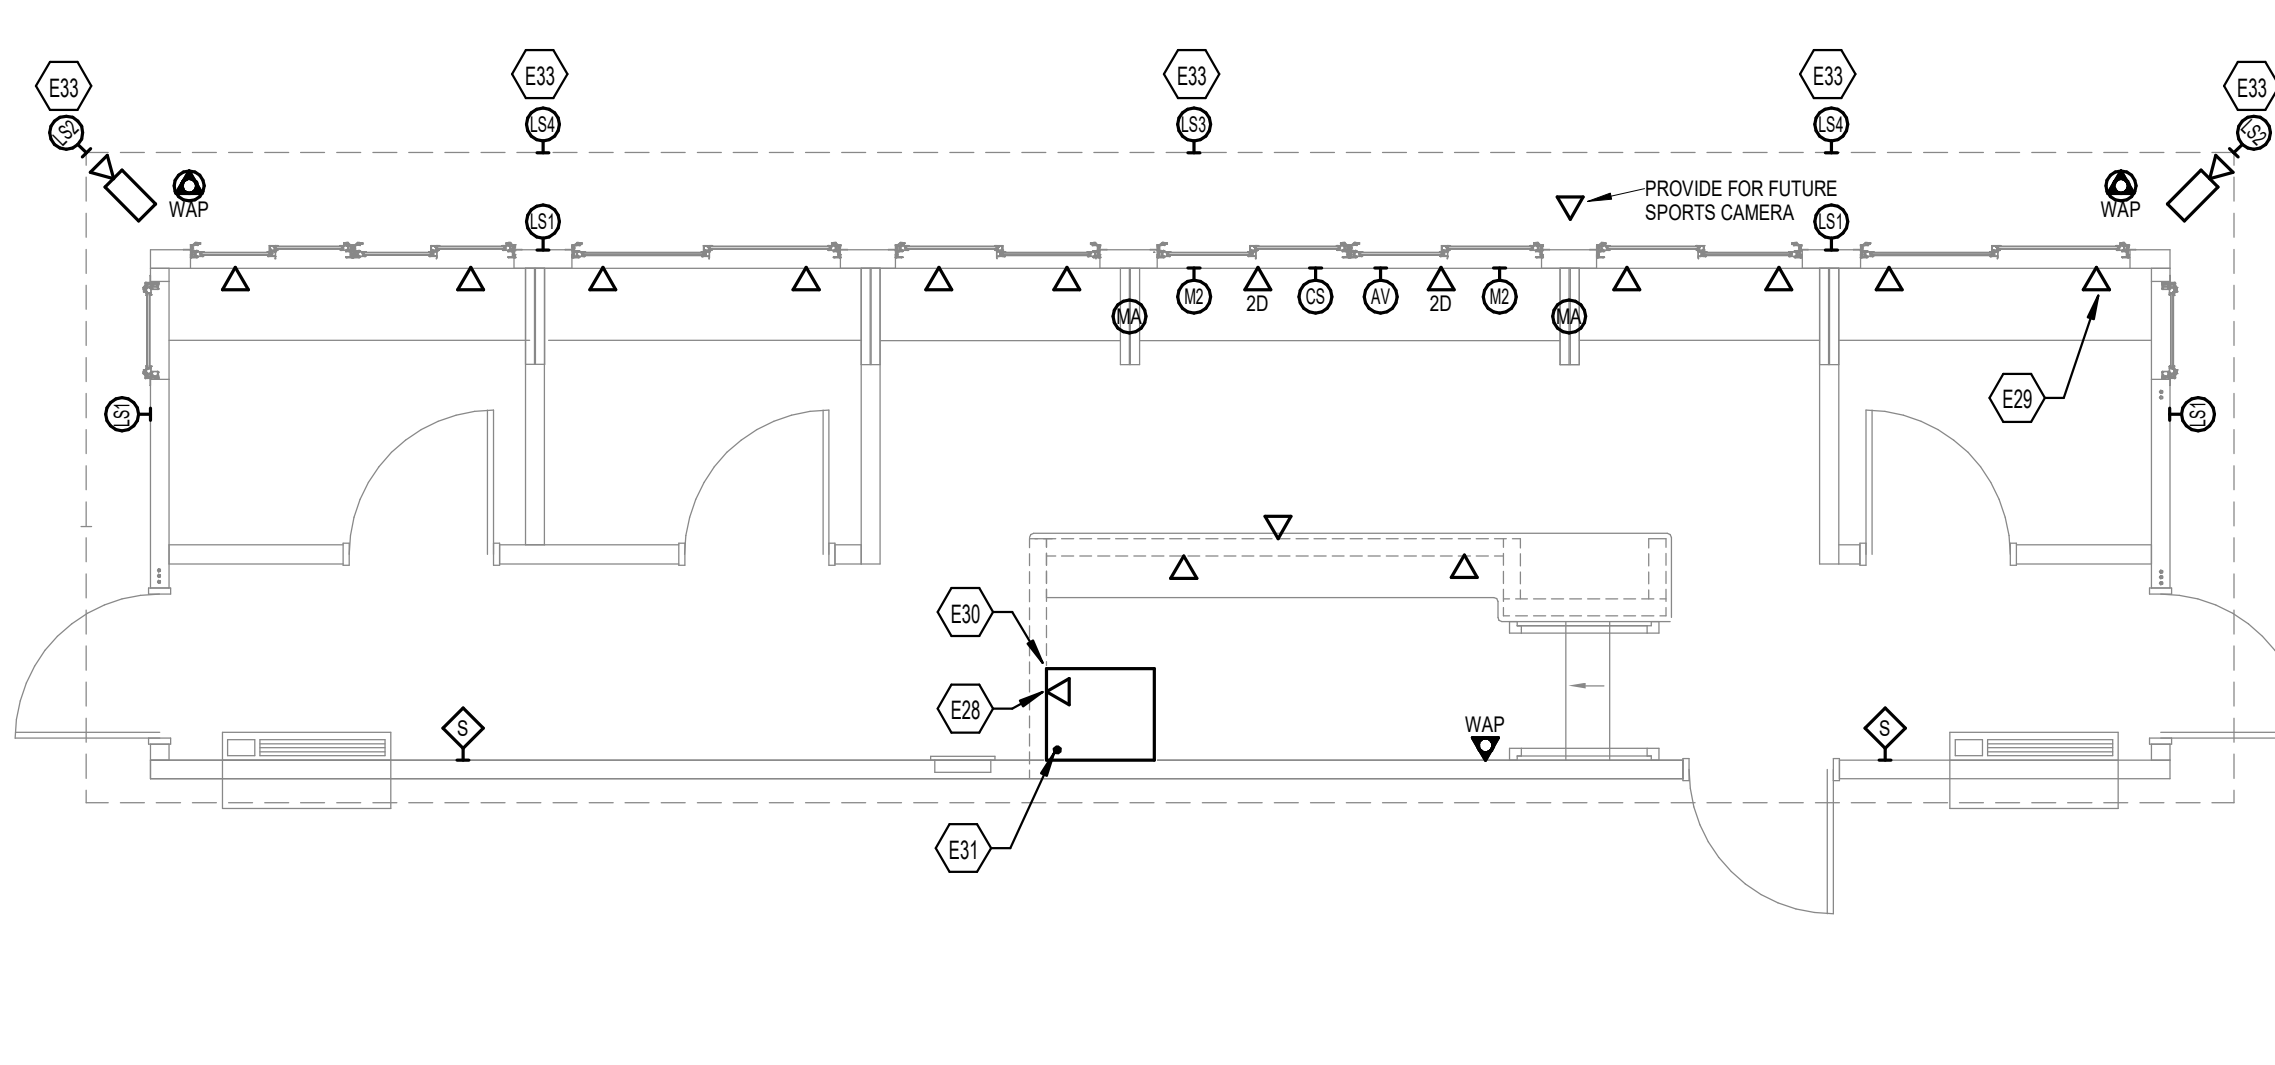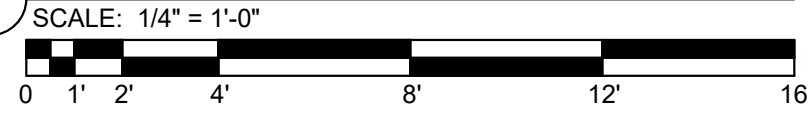

2 SYSTEMS PRESSBOX PLAN

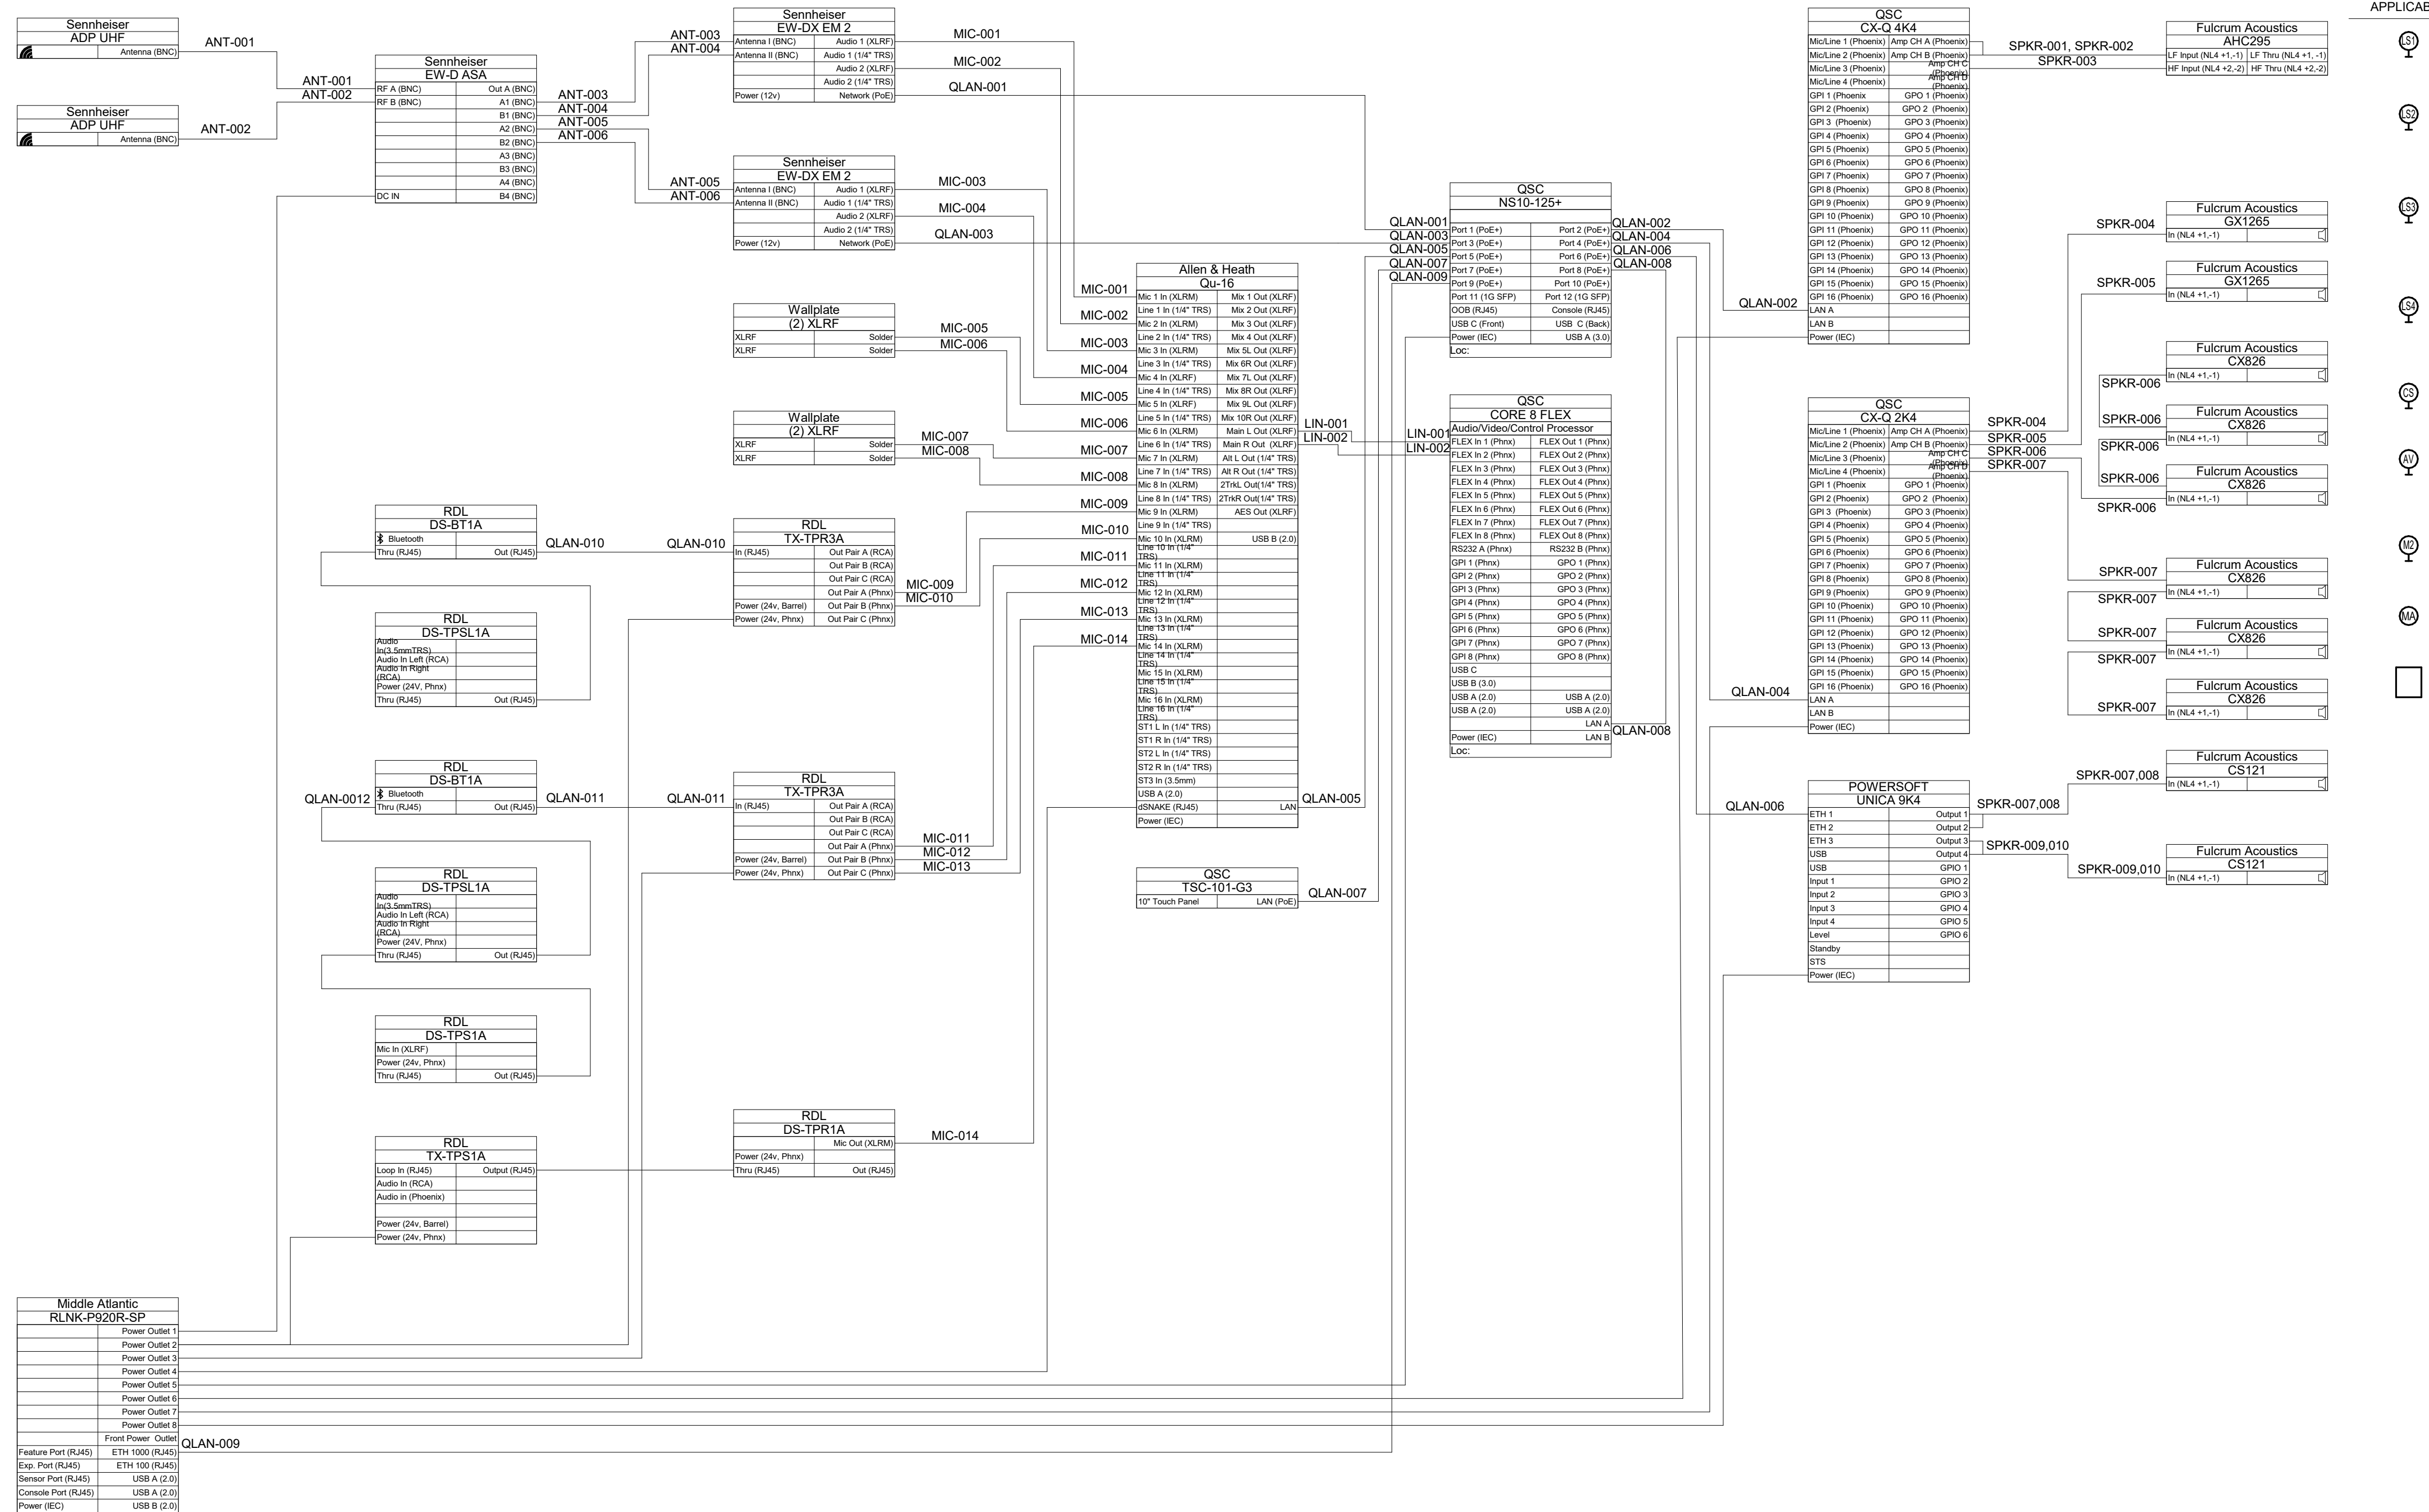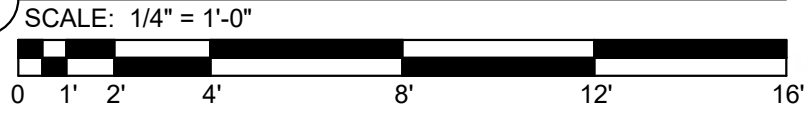

3 AV RISER DIAGRAM

SCALE: NONE

ELECTRICAL NEW WORK NOTES

- REFER TO THE ARCHITECT'S REFLECTED CEILING PLANS, ELEVATIONS, AND CASEWORK DETAILS FOR EXACT LOCATIONS OF ALL WALL AND CEILING MOUNTED ELECTRICAL DEVICES.
- CONTRACTOR SHALL FOLLOW BRANCH CIRCUITING LAY-OUT, AS INDICATED ON THE FLOOR PLANS, WITH A MAXIMUM OF THREE (3) BRANCH CIRCUITS PER HOMERUN. EACH BRANCH CIRCUIT SHALL BE PROVIDED WITH A DEDICATED NEUTRAL CONDUCTOR. DEDICATED NEUTRAL CONDUCTORS SHALL BE CONSIDERED CURRENT CARRYING. IF ADDITIONAL CONDUCTORS ARE RUN IN THE SAME CONDUIT WITH THOSE INDICATED, CONTRACTOR SHALL DEDICATE ALL CURRENT CARRYING CONDUCTORS PER N.E.C. #310.15(B)(3), AND UPSIZE CONDUIT AS REQUIRED PER N.E.C. #300.17 AND ANNEX C. MULTIWIRE BRANCH CIRCUITS AS DEFINED IN N.E.C. #210.4 (CIRCUITS SHARING A COMMON NEUTRAL CONDUCTOR) SHALL NOT BE PERMITTED.
- IDENTIFY THE PANEL AND CIRCUIT NUMBER FOR ALL RECEPTACLES, SWITCHES, ETC. IN AREA OF CONSTRUCTION. PROVIDE CLEAR ADHESIVE LABELS WITH BLACK LETTERING. IN HEALTHCARE FACILITIES, ENGRAVE EMERGENCY DEVICE COVERPLATES IN PATIENT CARE AREAS. ALSO, MARK INSIDES OF ALL DEVICE BOXES WITH PANEL AND CIRCUIT NUMBER.
- LOCATE CHAIN-HUNG INDUSTRIAL FIXTURES IN MECHANICAL ROOMS TO AVOID DUCTWORK AND PIPING, TO MAXIMIZE AVAILABLE LIGHT. SPACE AROUND EQUIPMENT, AIR HANDLERS, ETC. TO PROVIDE ADEQUATE LIGHTING TO ALL AREAS OF ROOM. PROVIDE ADDITIONAL FIXTURES OF SAME TYPE AS NEEDED TO FULFILL THIS REQUIREMENT.
- LOCATE EXIT SIGNS FOR MAXIMUM VIEWING AREA TO IDENTIFY EGRESS PATHS AS INDICATED ON PLANS. COORDINATE LOCATIONS SUCH THAT ARCHITECTURAL FEATURES OR EQUIPMENT FROM OTHER TRADES DO NOT OBSTRUCT VIEW.
- ALL LIGHTING FIXTURE LENSES, PARABOLIC LOUVERS, AND DOWNLIGHTING ALASK CONES SHALL BE HANDLED WITH COTTON GLOVES DURING INSTALLATION AND LAMPING TO AVOID FINGERPRINTS OR DIRT DEPOSITS. IT IS PREFERRED THAT FIXTURES BE SHIPPED AND INSTALLED WITH CLEAR PLASTIC BAGS TO PROTECT LOUVERS. AT CLOSE OF PROJECT, AND AFTER CONSTRUCTION AIR FILTERS ARE CHANGED, REMOVE BAGS. ANY LOUVER OR CONE SHOWING DIRT OR FINGER PRINTS SHALL BE CLEANED WITH SOLVENT RECOMMENDED BY THE MANUFACTURER, OR REPLACED AS NECESSARY IN ORDER TO TURN OVER TO THE OWNER NEW FIXTURES AT OCCUPANCY.
- RECESSED LUMINAIRES SHALL BE SECURED SUCH THAT THE FORCE REQUIRED INSERTING COMPONENTS, TRIMS, LENSES, LOUVERS, OR DOOR FRAMES DOES NOT SHIFT HOUSING. ALL TRIMS SHALL BE COMPLETELY FLUSH WITH FINISHED CEILINGS AT COMPLETION OF CONSTRUCTION.
- CONTRACTOR SHALL CIRCUIT ALL EXIT SIGNS AND EMERGENCY EGRESS FIXTURES (FIXTURE TYPES THAT START WITH 'E') FROM THE NEAREST UNSWITCHED NORMAL LIGHTING CIRCUIT. CONTRACTOR SHALL PROVIDE AN UNSWITCHED NORMAL-SENSING CONDUCTOR TO ALL FIXTURES WITH INTEGRAL BATTERY PACKS.
- LOCATIONS OF ELECTRICAL CONNECTIONS AND LOCAL DISCONNECTS SHALL BE COORDINATED WITH MECHANICAL AND PLUMBING CONTRACTORS TO ENSURE ACCESS AND WORKING CLEARANCE IS MAINTAINED PER NEC. NOTIFY OTHER TRADES OF REQUIRED CLEARANCE AREAS TO AVOID ROUTING OF OTHER SYSTEMS IN THESE AREAS. DO NOT INSTALL ELECTRICAL EQUIPMENT OVER EQUIPMENT NAMEPLATES OR ACCESS PANELS OR THROUGH ACCESS/MAINTENANCE CLEARANCES OF EQUIPMENT BY OTHER TRADES.
- REFER TO "SYSTEM INSTALLATION MATRIX" (ON SYSTEMS LEGEND SHEET) AND SPECIFICATIONS FOR CONTRACTOR REQUIREMENTS OF EACH SYSTEM.

TAGGED NOTES

- PROVIDE CIRCUITS INDICATED FOR VOICE/DATA AND AV RACK. REFER TO PRESSBOX DRAWINGS FOR ALL OTHER LIGHTING AND POWER SCOPE RELATED TO THE PRESSBOX.
- MAKE FINAL CONNECTION TO PRESSBOX PANEL AND WIRE COMPLETE. REFER TO ONE-LINE DIAGRAM AND SITE ELECTRICAL PLAN FOR MORE INFORMATION ABOUT PRESSBOX PANEL FEEDER.
- PROVIDE DATA DROP QUANTITY REQUIRED FOR RACK MOUNT EQUIPMENT.
- REFER TO THE PRESSBOX DRAWINGS FOR LOW VOLTAGE RACEWAY REQUIREMENTS. (TYPICAL)
- PROVIDE RACK FOR VOICE/DATA AND AV EQUIPMENT. RACK TO BE PROVIDED UNDER AV SPECIFICATIONS. REFER TO COMMUNICATIONS RISER AND AV ONE-LINE DIAGRAM FOR MORE INFORMATION. BOND RACK TO PRESSBOX GROUNDING SYSTEM USING #6 INSULATED COPPER GROUND.
- PROVIDE SURGE SUPPRESSION TYPE DUPLEX OUTLETS IN QUANTITY INDICATED TO SERVE AV RACK. MOUNT IN A SINGLE FOUR-GANG BOX LOCATED DIRECTLY BEHIND RACK.
- EACH OUTLET TO BE A DEDICATED CIRCUIT TO THE PRESSBOX PANEL. CIRCUIT EACH USING #12, #12 GROUND. PROVIDE 20A/1P BREAKER IN PRESSBOX PANEL FOR EACH CIRCUIT. COORDINATE INSTALLATION WITH PRESSBOX ELECTRICAL DRAWINGS.
- SPEAKER LOCATED ON PRESSBOX ROOF. REFER TO AV SYMBOL LEGEND FOR MORE INFORMATION.

SYMBOL (IF APPLICABLE)

Notes:

- Fulcrum CX826 speakers with YK-CX8 yoke bracket mounted on front of pressbox. Aimed at top rows. Requires (1) 3/4" conduit to AV Rack location.
- Fulcrum GX1265 speakers with YK-GX12 yoke bracket mounted on top of pressbox custom bracket (see Figure 1) 1/4" Contractor is responsible for providing speaker bracket. Aimed at Left/Right bottom bleachers. Requires (1) 3/4" conduit to AV Rack location.
- Fulcrum AHC295 speaker with YK-AHC2x5 yoke bracket mounted on top of pressbox custom bracket (see Figure 2) AV Contractor is responsible for providing speaker bracket. Aimed at Field/Visitor bleachers. Requires (1) 1" conduit to AV Rack location.
- Fulcrum CS121 subwoofer with YK-FH15 yoke bracket mounted on top of pressbox custom bracket (see Figure 3) AV Contractor is responsible for providing speaker bracket. Requires (1) 3/4" conduit to AV Rack location.
- QSC TSC-101-G3 touch panel with TSC-710T-G3 table stand. Mounted on desktop. Requires (1) 3/4" conduit to AV rack location.
- FSR DSXB-3G table mount with RDL Format-A DS-TPS1A mic input jack, RDL DS-TPS1A RCA 3.5mm line input. DS-BT-1A Bluetooth with RDL CP-3 cover. Requires (1) 3/4" conduit to AV Rack location.
- Single gang plates with (2) female XLR mic jacks each. Mounted at 16" A.F.F. Requires 3/4" conduit to AV Rack location.
- Sennheiser ADP UHF antenna mounted on ceiling with WM-1. Requires a single gang box with (1) 1" conduit to AV Rack location.
- Rack Location. Requires (4) 20 amp circuits. See Figure 4 for rack layout. Fill all empty spaces.

Deliverables:

- Sennheiser EW-DX SKM-S transmitters
- Sennheiser MMD 835 BK mic heads
- Sennheiser EW-DX SK Sennheiser transmitters
- Sennheiser MKE 2 lavaliers
- Point Source CO-8WD-XSE-BL headset mics
- Atlas MS-10CE mic stands
- Atlas DS7E desk stands
- Sennheiser e 835 S wired handhelds
- 15' mic cables
- 3' mic cable
- 3.5mm cable
- Whirlwind PodMixAI announcer mixer

Rack:

- Panduit FM11
- Panduit CFAPPB1
- Panduit FAPB
- Panduit FAPWBUDLCZ
- Panduit FLD38BY
- Panduit NKFP91BN1NMK001
- Panduit FOSME
- Middle Atlantic BGR-3827
- Middle Atlantic VFD-38A
- Middle Atlantic SFD-KEYS
- Middle Atlantic SRD-KEYS
- Middle Atlantic FWD-LT-UTL-35-40-D
- Middle Atlantic BSPN-38-32
- Middle Atlantic BGR-552FT-FC
- Middle Atlantic CBS-BGR
- Middle Atlantic FWD-LB-1A
- Middle Atlantic LL-VP2110
- LAGE-37-W-A
- LT-GN-PNL

Cable:

- Antenna Cable: RG-8u
- Category Cable: CAT6S
- Mic Cable: Shielded 22-2
- Speaker Cable: Outdoor 12-2
- Acceptable manufacturers: Belden, West Penn Wire, Windy City Wire.

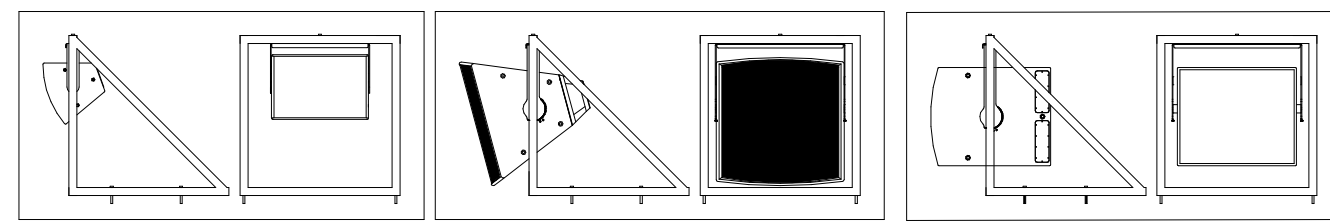


Figure 1

Figure 2

Figure 3

ELECTRICAL PLANS - PRESSBOX
FOR:
WOODFORD COUNTY HIGH SCHOOL CONCESSIONS & RESTROOMS
WOODFORD COUNTY BOARD OF EDUCATION
330 Pisgah Pike, Versailles, Kentucky 40383

BG# 23-120

Project No: 1916/XWCH19-01

Drawn By: Author

Rev'd By: Checker

SHEET RELEASE

| | |
|---|--|
| 1 | |
| 2 | |
| 3 | |
| 4 | |
| 5 | |
| 6 | |
| 7 | |
| 8 | |

COPYRIGHT © 2024

CONSTRUCTION DOCUMENTS

E1.2

ELECTRICAL PLANS - PRESSBOX

DATE ISSUED: 10/16/2024

101 Old Lafayette Avenue Lexington, Kentucky 40502 P.857.254.4018

rostantant architects

| REVISIONS | | |
|-----------|------------|-------------|
| # | DATE | DESCRIPTION |
| 1 | 08/08/2024 | Addendum #1 |
| 2 | 10/08/2024 | PR-06 |
| | | |
| | | |
ELEC - LUMINAIRE SCHEDULE

| TYPE | DESCRIPTION | BASIS OF DESIGN | EQUALS | LAMPS / CCT | DRIVER | MINIMUM LUMENS | MOUNTING SURFACE | MAXIMUM WATTAGE | VOLTAGE | REMARKS |
|------|---|--------------------|-----------------------------------|-------------|-----------|----------------|------------------|-----------------|---------|-----------------------|
| A1 | 2X4 SURFACE MOUNT LED. COLD-ROLLED TEEL HOUSING. SMOOTH HEMMED SIDES AND INWARD FORMED END FLANGES. STANDARD PATTERN #19 LENS. 0.160" THICK PRISMATIC LENS. POLYESTER POWDER COAT FINISH. | LITHONIA 2TLX4 | METALUX EQUAL, COLUMBIA EQUAL | 4000K/80CRI | 0-10V DIM | 4800 | SURFACE | 40 | MVOLT | |
| A1E | SAME AS PARENT TYPE WITH INTEGRAL 1400 LUMEN EMERGENCY BATTERY | LITHONIA 2TLX4 | METALUX EQUAL, COLUMBIA EQUAL | 4000K/80CRI | 0-10V DIM | 4800 | SURFACE | 40 | MVOLT | |
| B1 | 1X4 SURFACE MOUNT LED. COLD-ROLLED TEEL HOUSING. SMOOTH HEMMED SIDES AND INWARD FORMED END FLANGES. STANDARD PATTERN #19 LENS. 0.160" THICK PRISMATIC LENS. POLYESTER POWDER COAT FINISH. | LITHONIA TLX4 | METALUX EQUAL, COLUMBIA EQUAL | 4000K/80CRI | 0-10V DIM | 4000 | SURFACE | 39 | MVOLT | |
| B1E | SAME AS PARENT TYPE WITH INTEGRAL 1400 LUMEN EMERGENCY BATTERY | LITHONIA TLX4 | METALUX EQUAL, COLUMBIA EQUAL | 4000K/80CRI | 0-10V DIM | 4000 | SURFACE | 39 | MVOLT | |
| C1 | 7" SHALLOW, SURFACE MOUNT DOWNLIGHT. NON-CONDUCTIVE MATERIAL WITH MATTE, DIFFUSE LENS. | JUNO SLIMFORM JSF7 | HALO EQUAL, LIGHTOLIER EQUAL | 4000K/80CRI | 0-10V DIM | 1000 | SURFACE | 13 | MVOLT | |
| D1 | 4" LOW-PROFILE LED STRIP FIXTURE. COLD-ROLLED STEEL HOUSING WITH DIFFUSE SNAP-ON LENS. | LITHONIA ZL 1IN | METALUX EQUAL, WILLIAMS EQUAL | 4000K/80CRI | 0-10V DIM | 5000 | SURFACE | 34 | MVOLT | |
| D1E | SAME AS PARENT TYPE WITH INTEGRAL 1400 LUMEN EMERGENCY BATTERY | LITHONIA ZL 1IN | METALUX EQUAL, WILLIAMS EQUAL | 4000K/80CRI | 0-10V DIM | 5000 | SURFACE | 34 | MVOLT | |
| E1 | ARCHITECTURAL EGRESS LIGHT. WET LOCATION RATED WITH INTEGRAL COLD WEATHER BATTERY. | LITHONIA AFF | EVENLITE, DUALITE EQUAL | 4000K/80CRI | - | 3000 | WALL | 25 | MVOLT | MOUNT AT 7'-0" A.F.F. |
| OF1 | EXTERIOR WALL MOUNT FIXTURE WITH TWO-PIECE DIE-CAST ALUMINUM HOUSING. POWDER COAT FINISH FOR CORROSION AND WEATHER RESISTANCE. TYPE 3 MEDIUM DISTRIBUTION. WET LOCATION RATED. | LITHONIA DSX1 | MCGRAW EDISON EQUAL, GARDCO EQUAL | 4000K/80CRI | 0-10V DIM | 5500 | WALL | 46 | MVOLT | MOUNT AT 8'-0" A.F.F. |
| OF2 | RECESSED 6" WALL WASH LED DOWNLIGHT. GALVANIZED STEEL CONSTRUCTION WITH MATTE, DIFFUSE LENS. WET LOCATION RATED. | LITHONIA LDN6 | HALO EQUAL, LIGHTOLIER EQUAL | 4000K/80CRI | 0-10V DIM | 750 | CANOPY | 9 | MVOLT | |
| X1 | DIE-CAST ALUMINUM SINGLE SIDED EXIT SIGN. | LITHONIA LQC | EVENLITE, DUALITE EQUAL | - | - | - | UNIVERSAL | 2 | MVOLT | |

ELEC - EQUIPMENT CONNECTION SCHEDULE

| EQUIP ID | DESCRIPTION | DISCONNECT MEANS | VOLTAGE | POLES | HP | POWER (KVA) | MCA | FURNISHED BY | INSTALLED BY |
|------------|------------------------------|------------------|---------|-------|------|-------------|------|--------------|--------------|
| EF-1B | EXHAUST FAN | NEMA 1 | 208 | 2 | 0.13 | 0.40 | 2.5 | EC | EC |
| EH-2 | ELECTRIC HEATER | NEMA 1 | 208 | 2 | - | 0.75 | 4.5 | EC | EC |
| EH-2 | ELECTRIC HEATER | NEMA 1 | 208 | 2 | - | 1.50 | 9 | EC | EC |
| EH-4 | ELECTRIC HEATER | NEMA 1 | 208 | 2 | - | 3.00 | 18 | EC | EC |
| HAND DRYER | HAND DRYER | 120V SNAP SWITCH | 120 | 1 | 1/4 | 1.50 | 15 | EC | EC |
| RP-1 | HOT WATER RECIRCULATING PUMP | 120V SNAP SWITCH | 120 | 1 | - | 0.10 | 0.8 | EC | EC |
| TP-1 | TRAP PRIMER | 120V SNAP SWITCH | 120 | 1 | - | 0.05 | 0.5 | EC | EC |
| WH-1 | WATER HEATER | NEMA 1 | 208 | 3 | - | 8.00 | 41.8 | EC | EC |


ELEC - CAMERA SCHEDULE

| Type | MODEL |
|----------------------|-------------|
| Ceiling Mount Camera | |
| CUT | XNV-6080 |
| OW | PNM-9085RQ2 |


PANELBOARD AND WIRING SCHEDULE

| PANEL: MPH | | | | | | | | | |
|----------------------------|---------------------------|----------------|-----|---|-----|-----|-----|-----|-----|
| VOLTAGE: 480Y/277V, 3P, 4W | | | | | | | | | |
| AMPERES: 400 A | | | | | | | | | |
| MOUNTING: SURFACE | | | | | | | | | |
| NOTES | CIRCUIT DESCRIPTION | HOT, NEUT, GND | OCB | P | CKT | A | B | C | CT |
| | F1 ATHLETIC LIGHTING POLE | 3-4# 1-4# 1-4# | 50 | 3 | 1 | 8.7 | 8.7 | 8.7 | 2 |
| | | | | | 3 | 8.7 | 8.7 | 8.7 | 4 |
| | | | | | 5 | 8.7 | 8.7 | 8.7 | 6 |
| | | | | | 7 | 9.3 | 9.3 | 9.3 | 8 |
| | | | | | 9 | 9.3 | 9.3 | 9.3 | 10 |
| | | | | | 11 | 9.3 | 9.3 | 9.3 | 12 |
| | | | | | 279 | 9.3 | 9.3 | 9.3 | 280 |


| REVISIONS | | |
|-----------|------------|-------------|
| # | DATE | DESCRIPTION |
| 2 | 10/08/2024 | PR-06 |
| | | |
| | | |
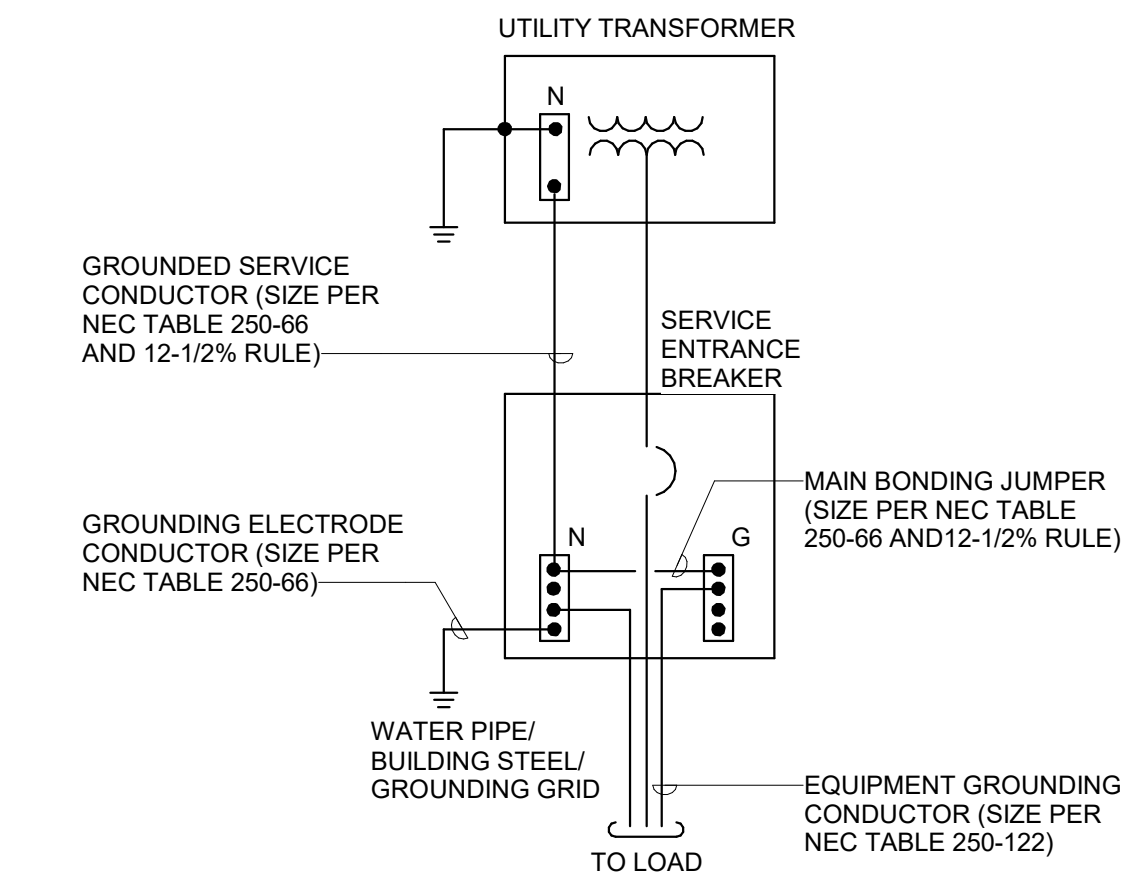

1 SERVICE ENTRANCE GROUNDING DETAIL
SCALE: NONE

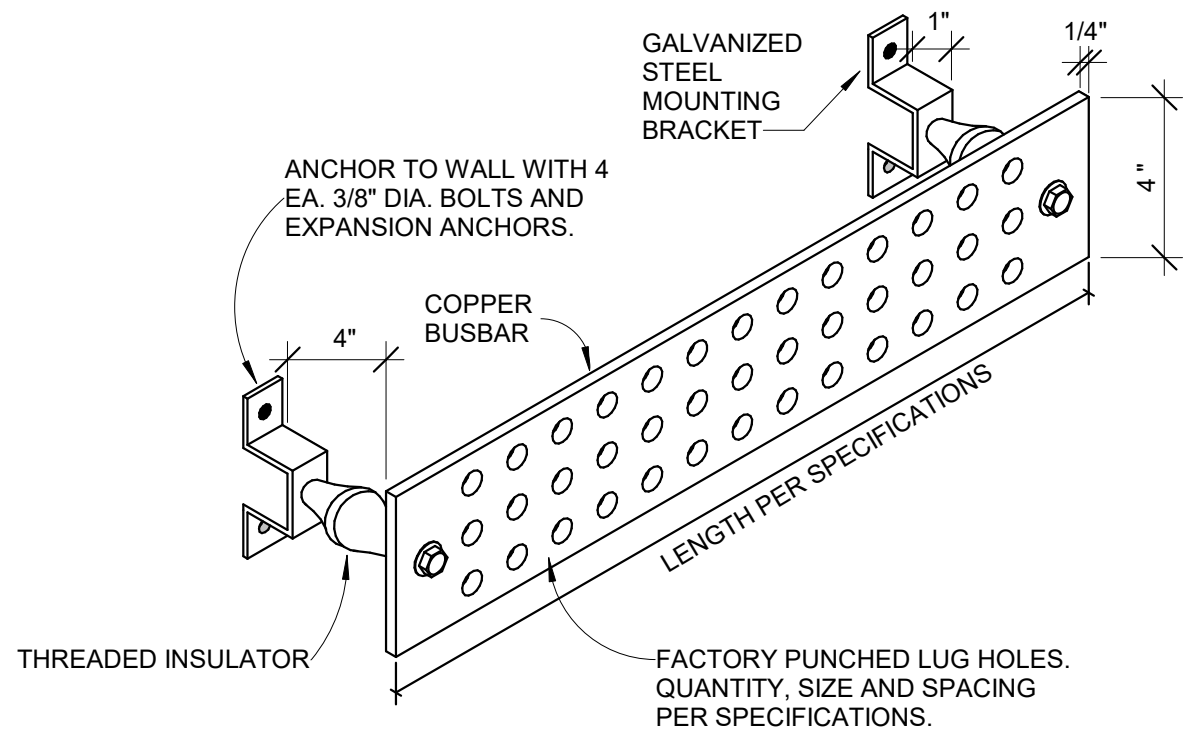


2 GROUND BUS BAR MOUNTING
SCALE: NONE

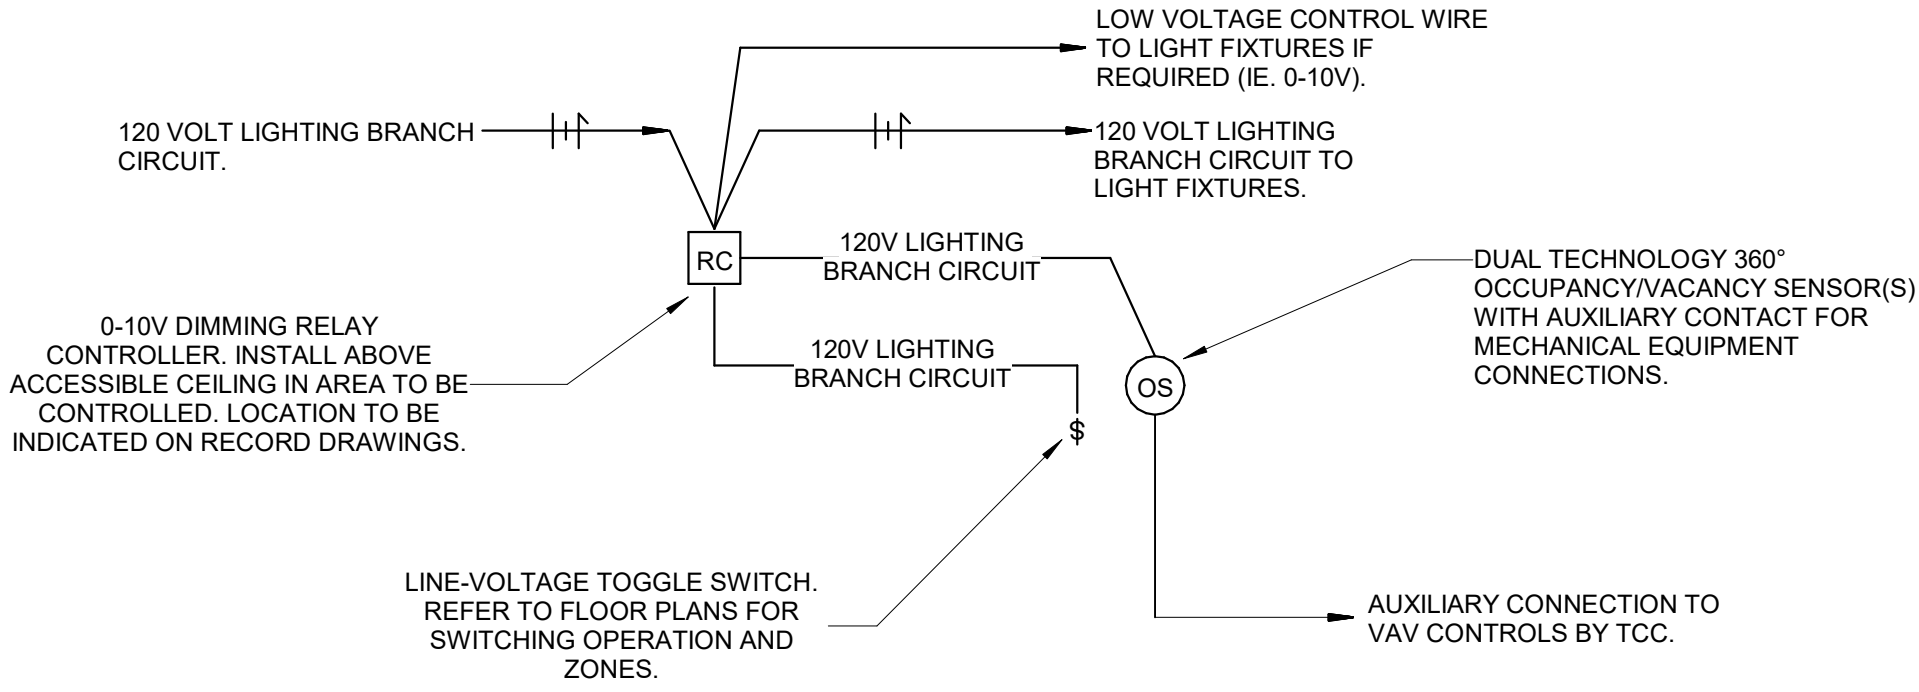


GENERAL NOTES:

- STAND ALONE OCCUPANCY SENSOR CONTROL ZONES WITH NO SWITCHING INDICATED ON FLOORPLANS SHALL BE CONTROLLED BY OCCUPANCY SENSOR ONLY. CONTROL SEQUENCE SHALL BE ON/OFF DEPENDANT UPON OCCUPANT DETECTION.
- STAND ALONE OCCUPANCY SENSOR CONTROL ZONES WITH SWITCHES INDICATED ON FLOORPLANS SHALL FUNCTION AS VACANCY SENSORS. FIXTURES SHALL NOT TURN ON UPON OCCUPANT DETECTION. FIXTURES SHALL TURN ON TO 50% DIMMED WHEN WALL SWITCH IS ACTIVATED. PROVIDE ADDITIONAL UP/DOWN DIMMING CONTROLS WHERE DIMMING SWITCHES ARE INDICATED ON FLOORPLANS. (FIXTURES SHALL REMAIN "OFF" WHEN OCCUPANTS ARE INITIALLY DETECTED IF DIMMING SWITCHES NOT INDICATED ON FLOORPLANS.)
- ALL LIGHTING CONTROL SYSTEMS SHALL COMPLY WITH THE MOST CURRENT ENERGY CODE. REFER TO PROJECT MANUAL FOR EXACT ENERGY CODE REFERENCED.
- ACCEPTABLE MANUFACTURERS SHALL BE SENSORSWITCH, WATTSTOPPER OR LEVITON EQUAL.

3 TYPICAL STAND ALONE LIGHTING CONTROL DIAGRAM
SCALE: NONE

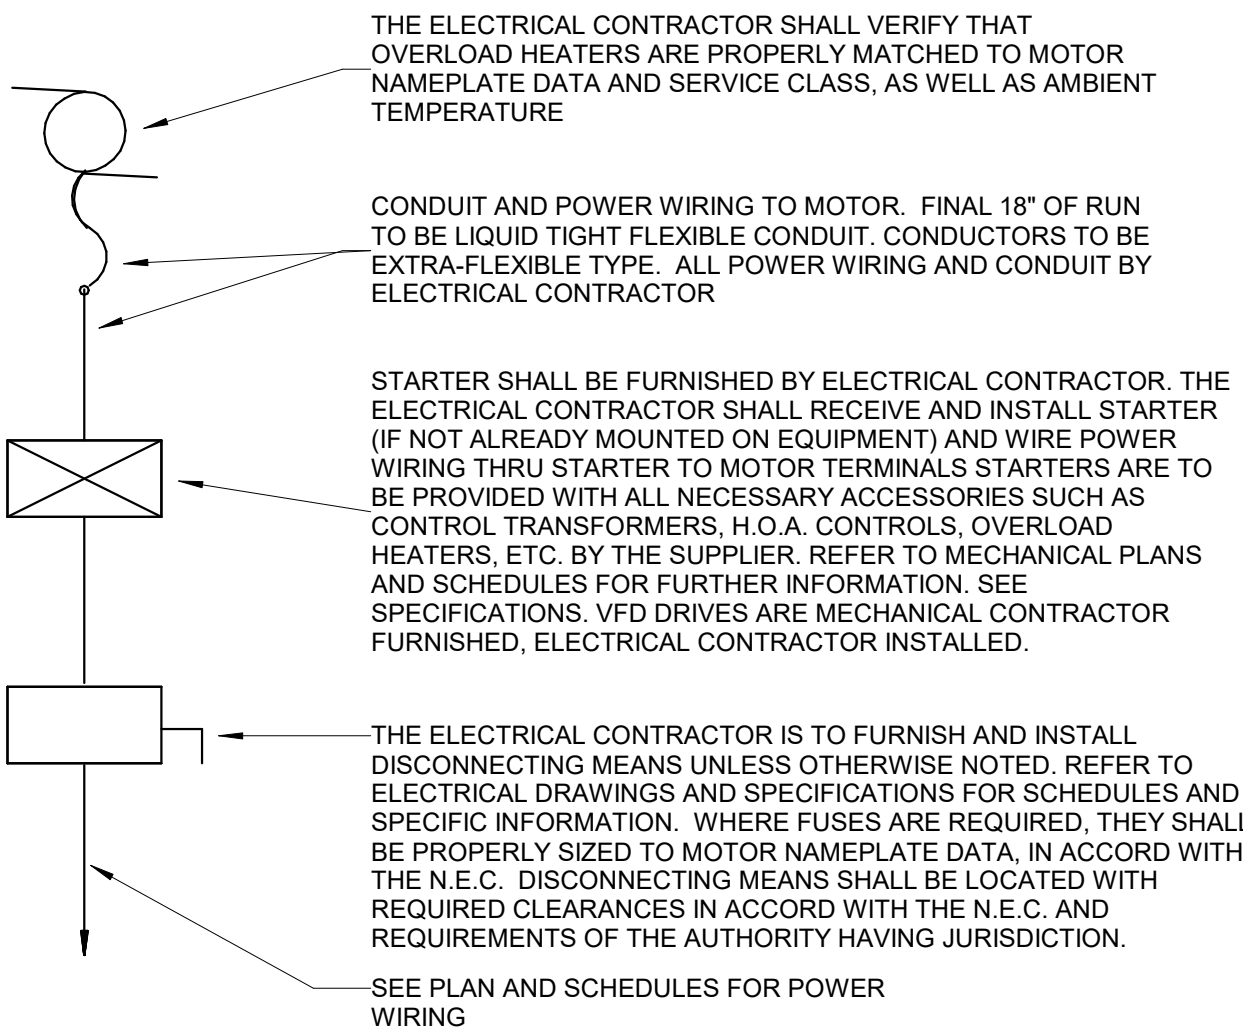


4 DETAIL OF TYPICAL MOTOR/STARTER INSTALLATION
SCALE: NONE

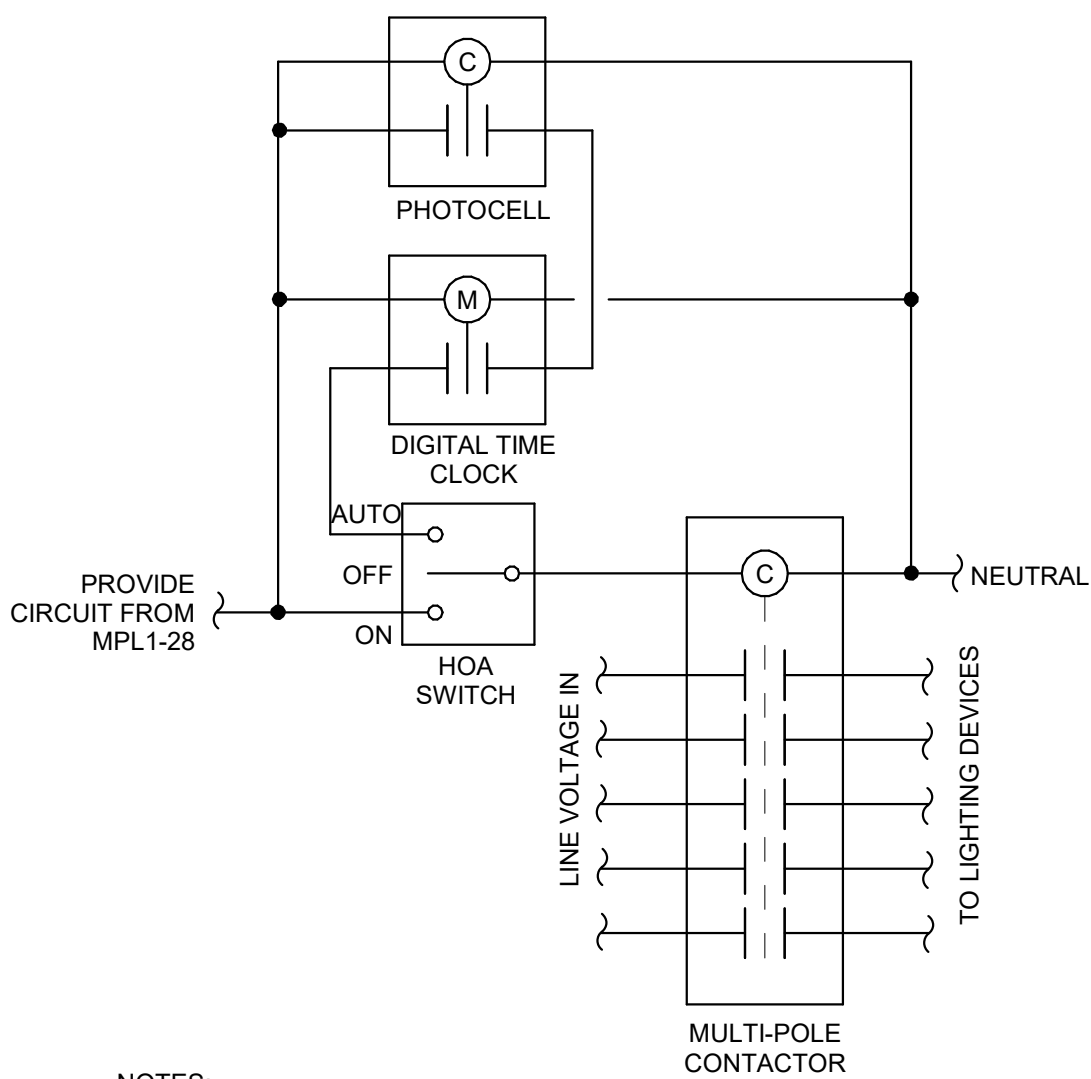


NOTES:

- LOCATE CONTACTOR, HOA SWITCH, AND TIMECLOCK IN MECH 104.
- INSTALL TIME CLOCK AND CONTACTOR(S) IN HINGED ENCLOSURE RATED FOR ENVIRONMENT INSTALLED.
- HOA TO BE OPERABLE WITHOUT OPENING ENCLOSURE.
- INSTALL PHOTOCELL ON ROOF FACING NORTH UNLESS OTHERWISE NOTED ON PLANS.


7 LIGHTING CONTROL WIRING
SCALE: NONE

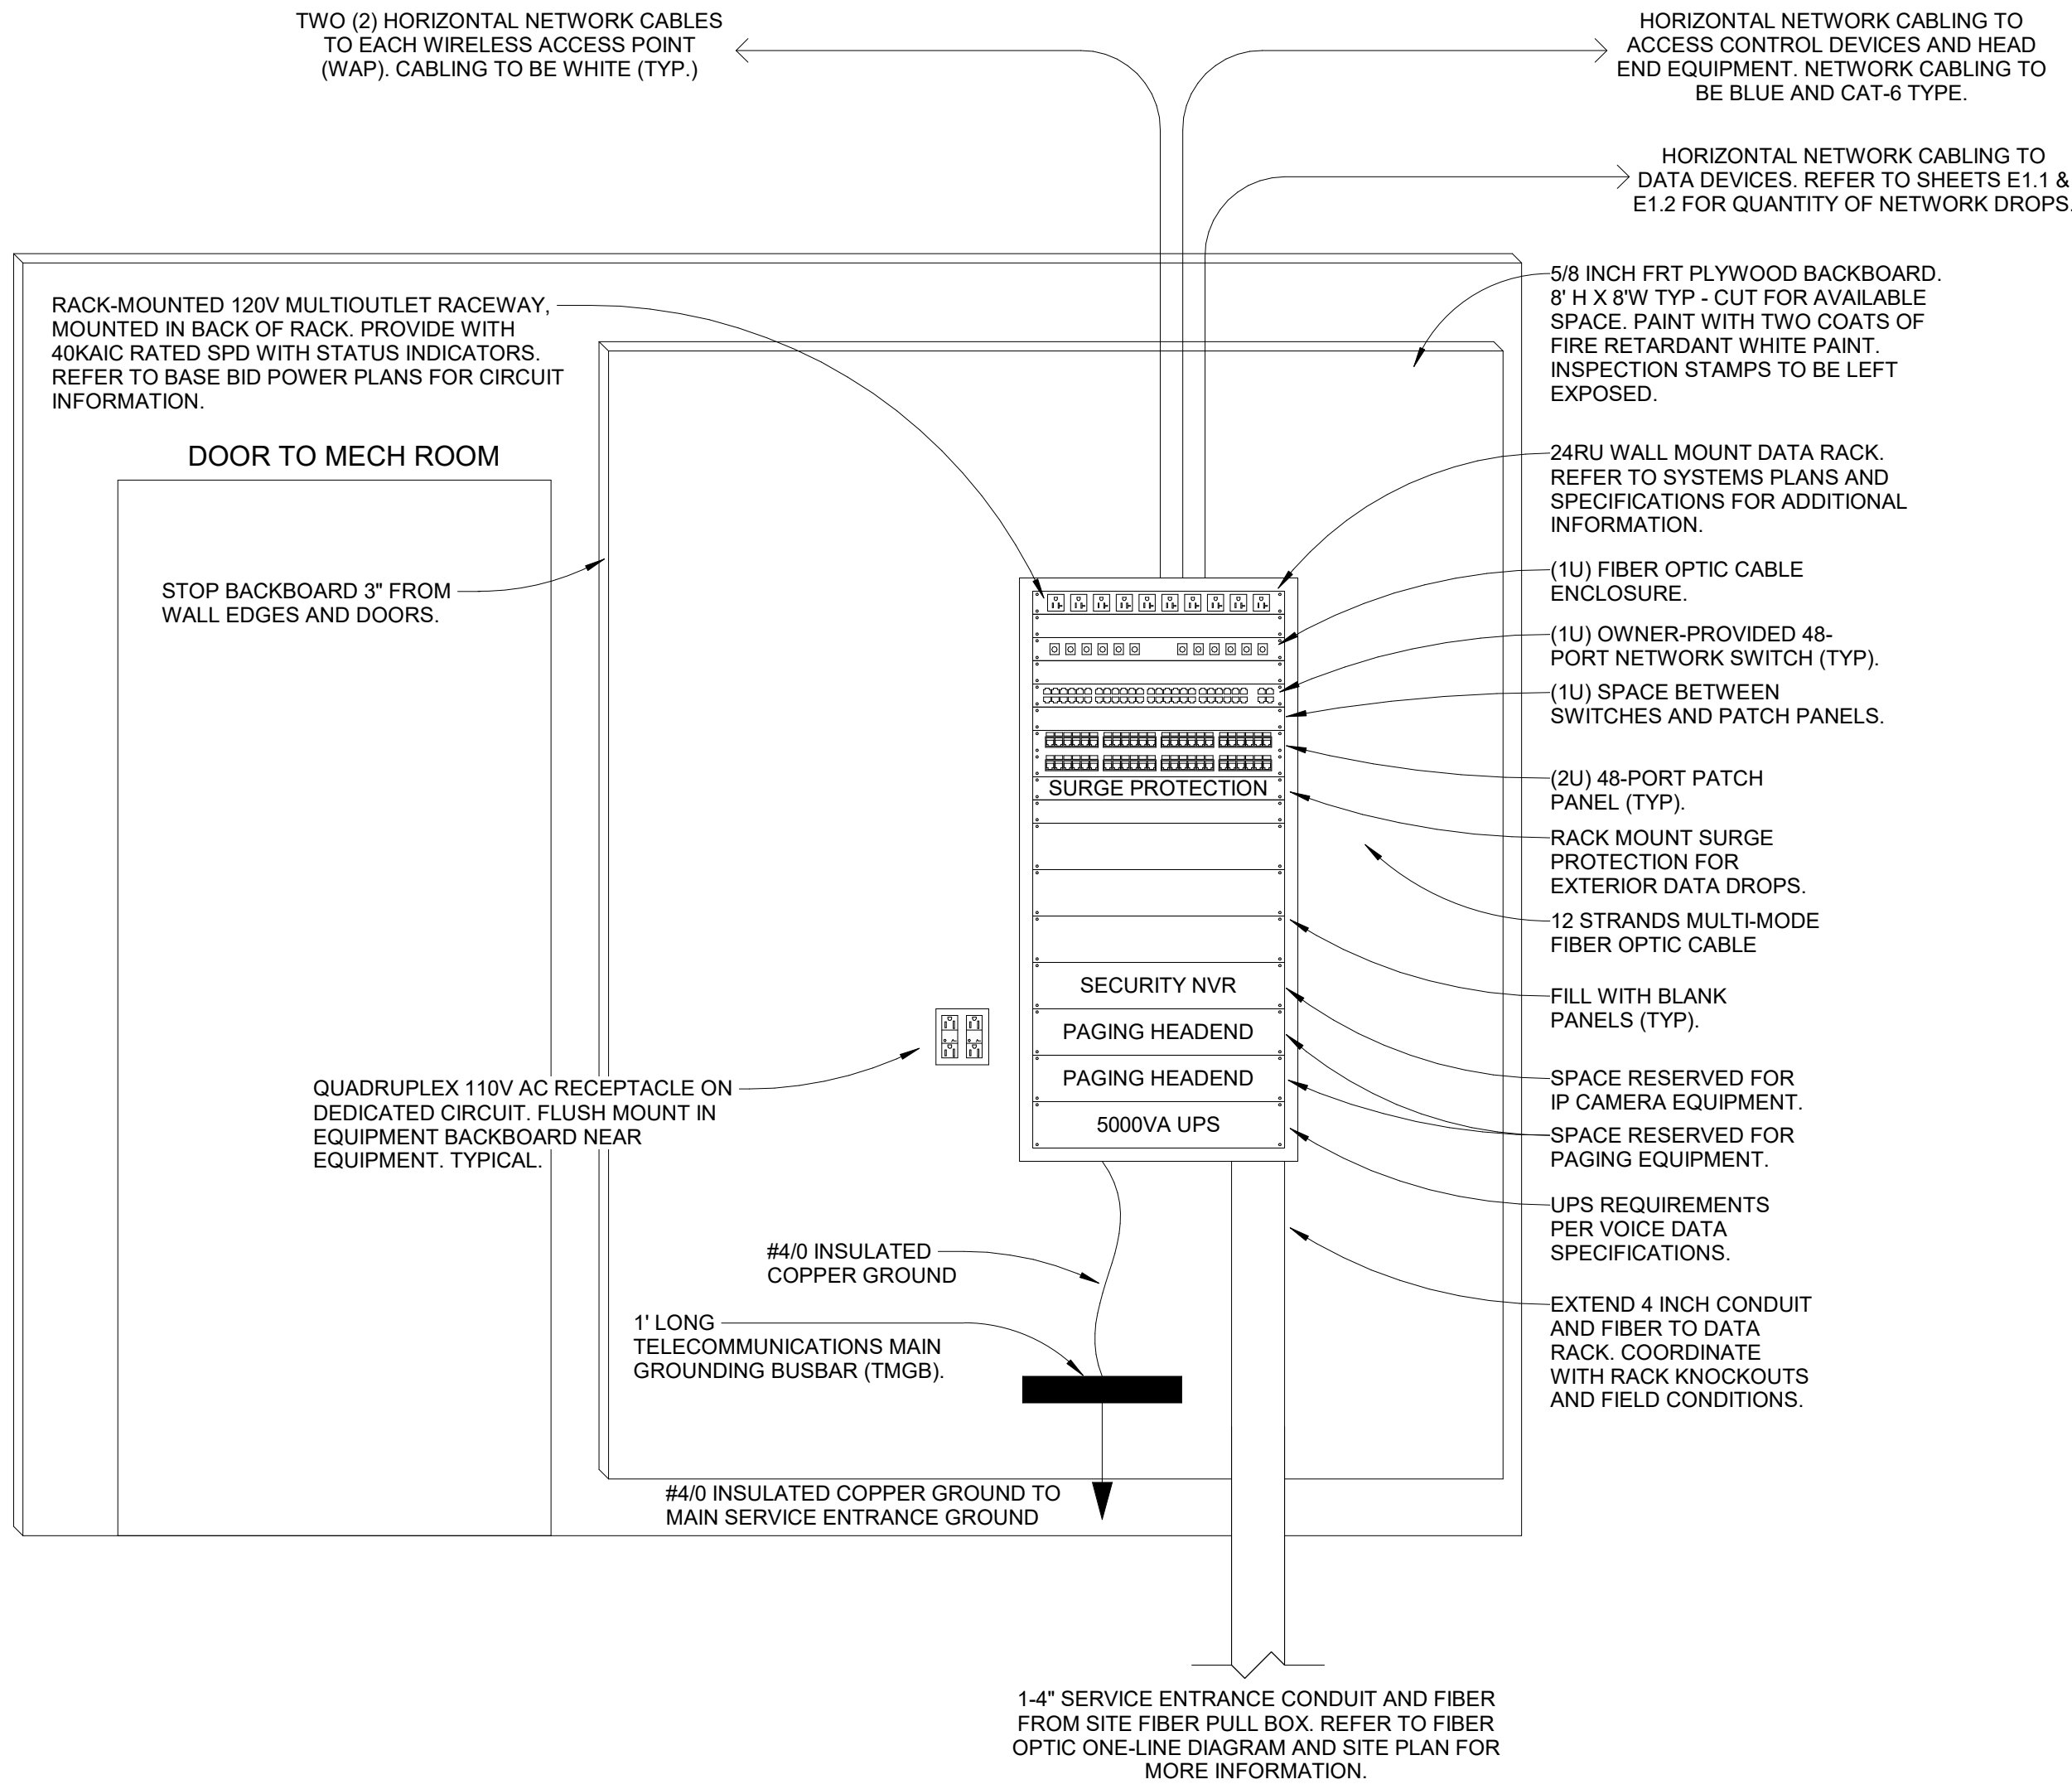

5 COMMUNICATIONS RISER DIAGRAM
SCALE: NONE

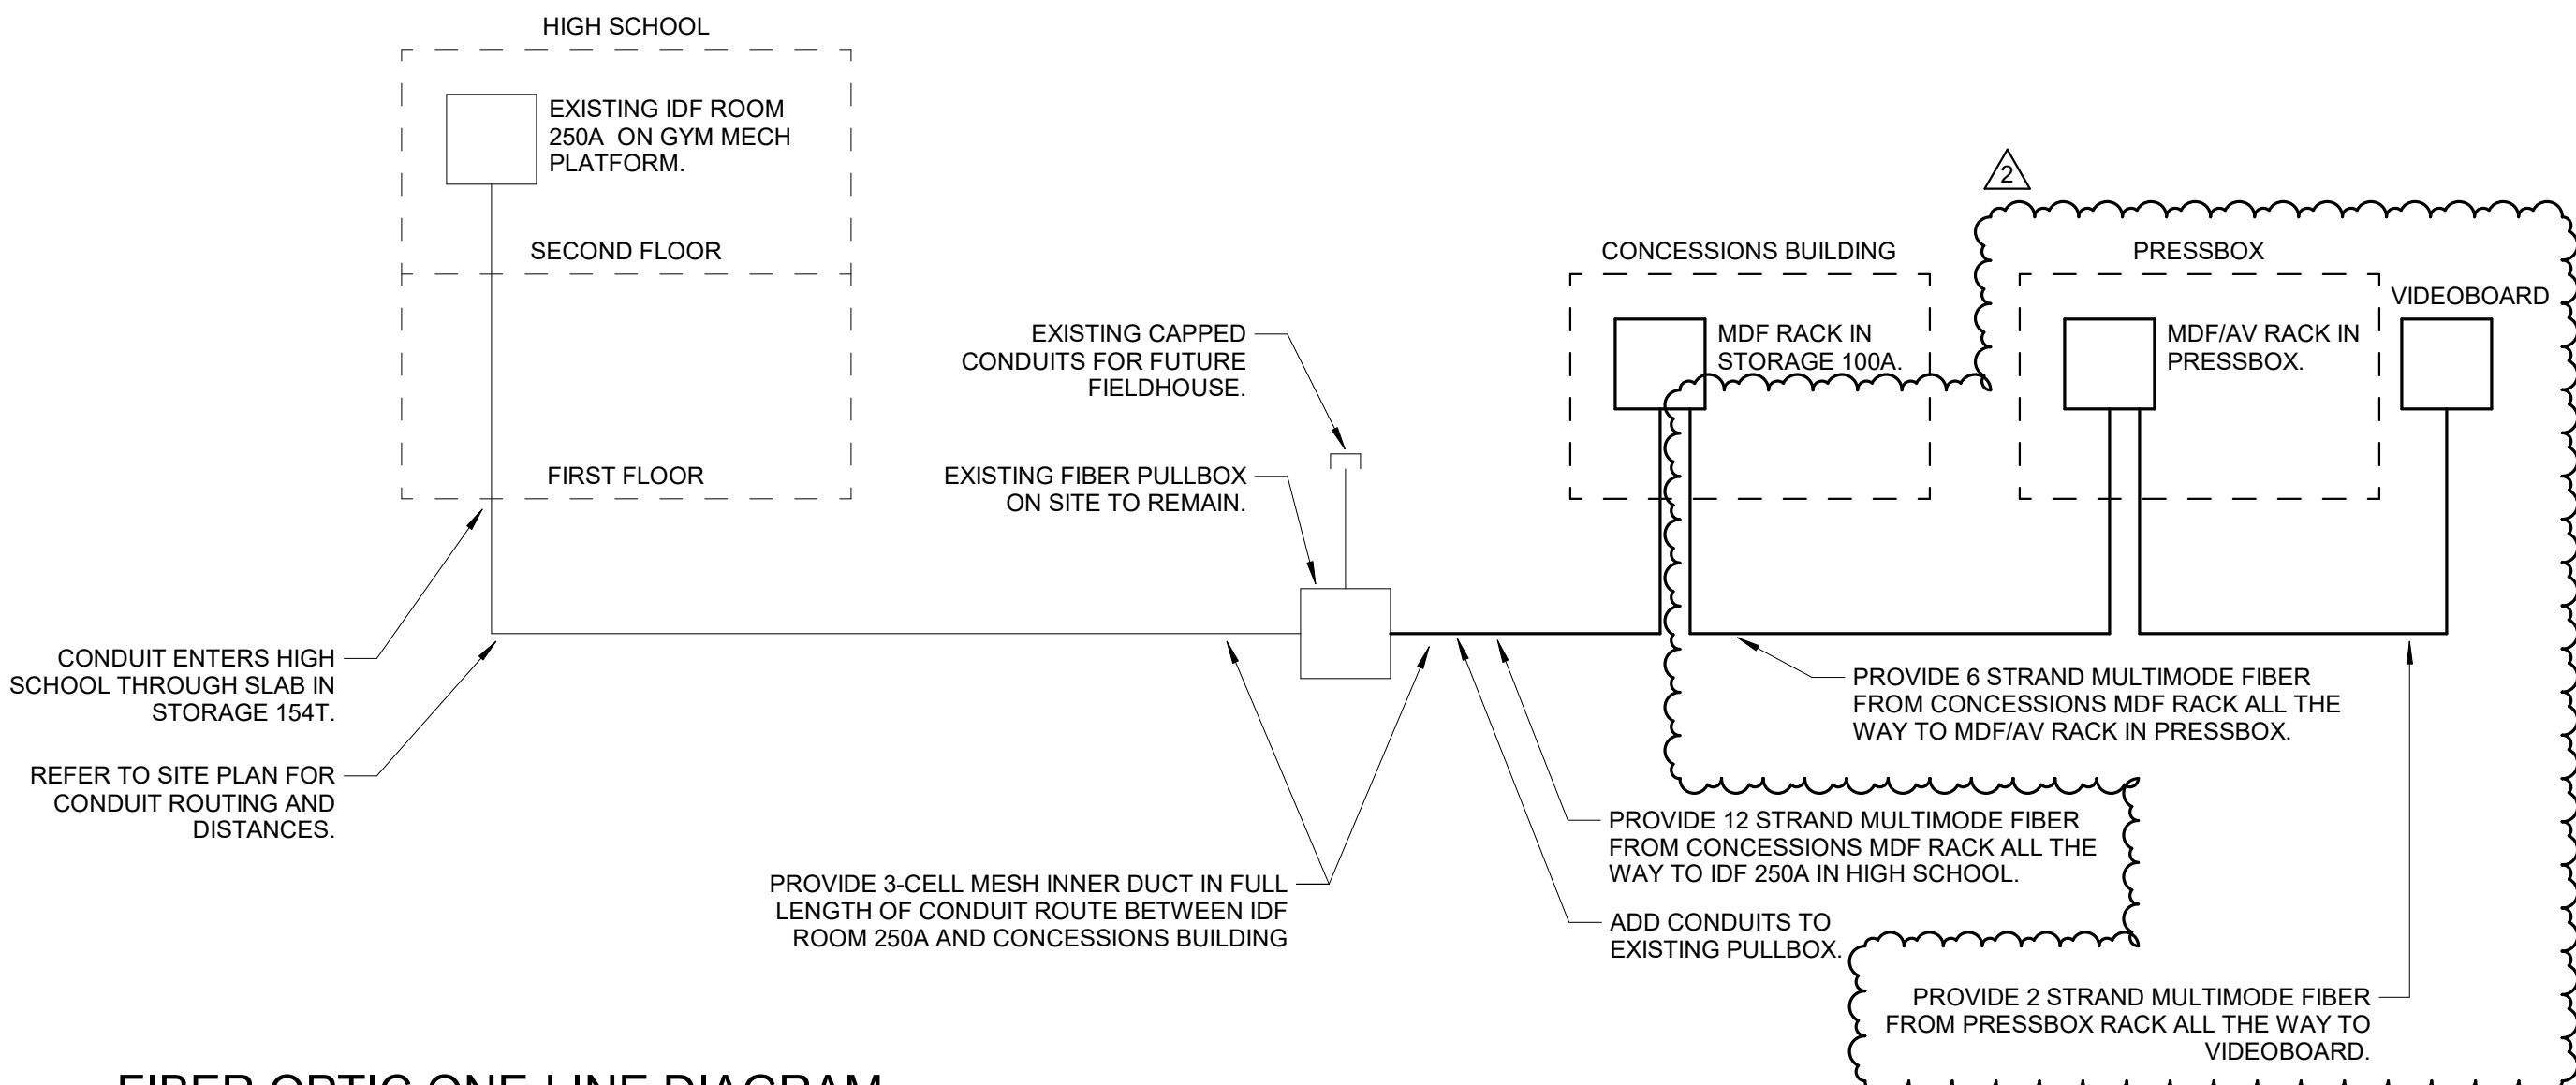

6 FIBER OPTIC ONE-LINE DIAGRAM
SCALE: NONE

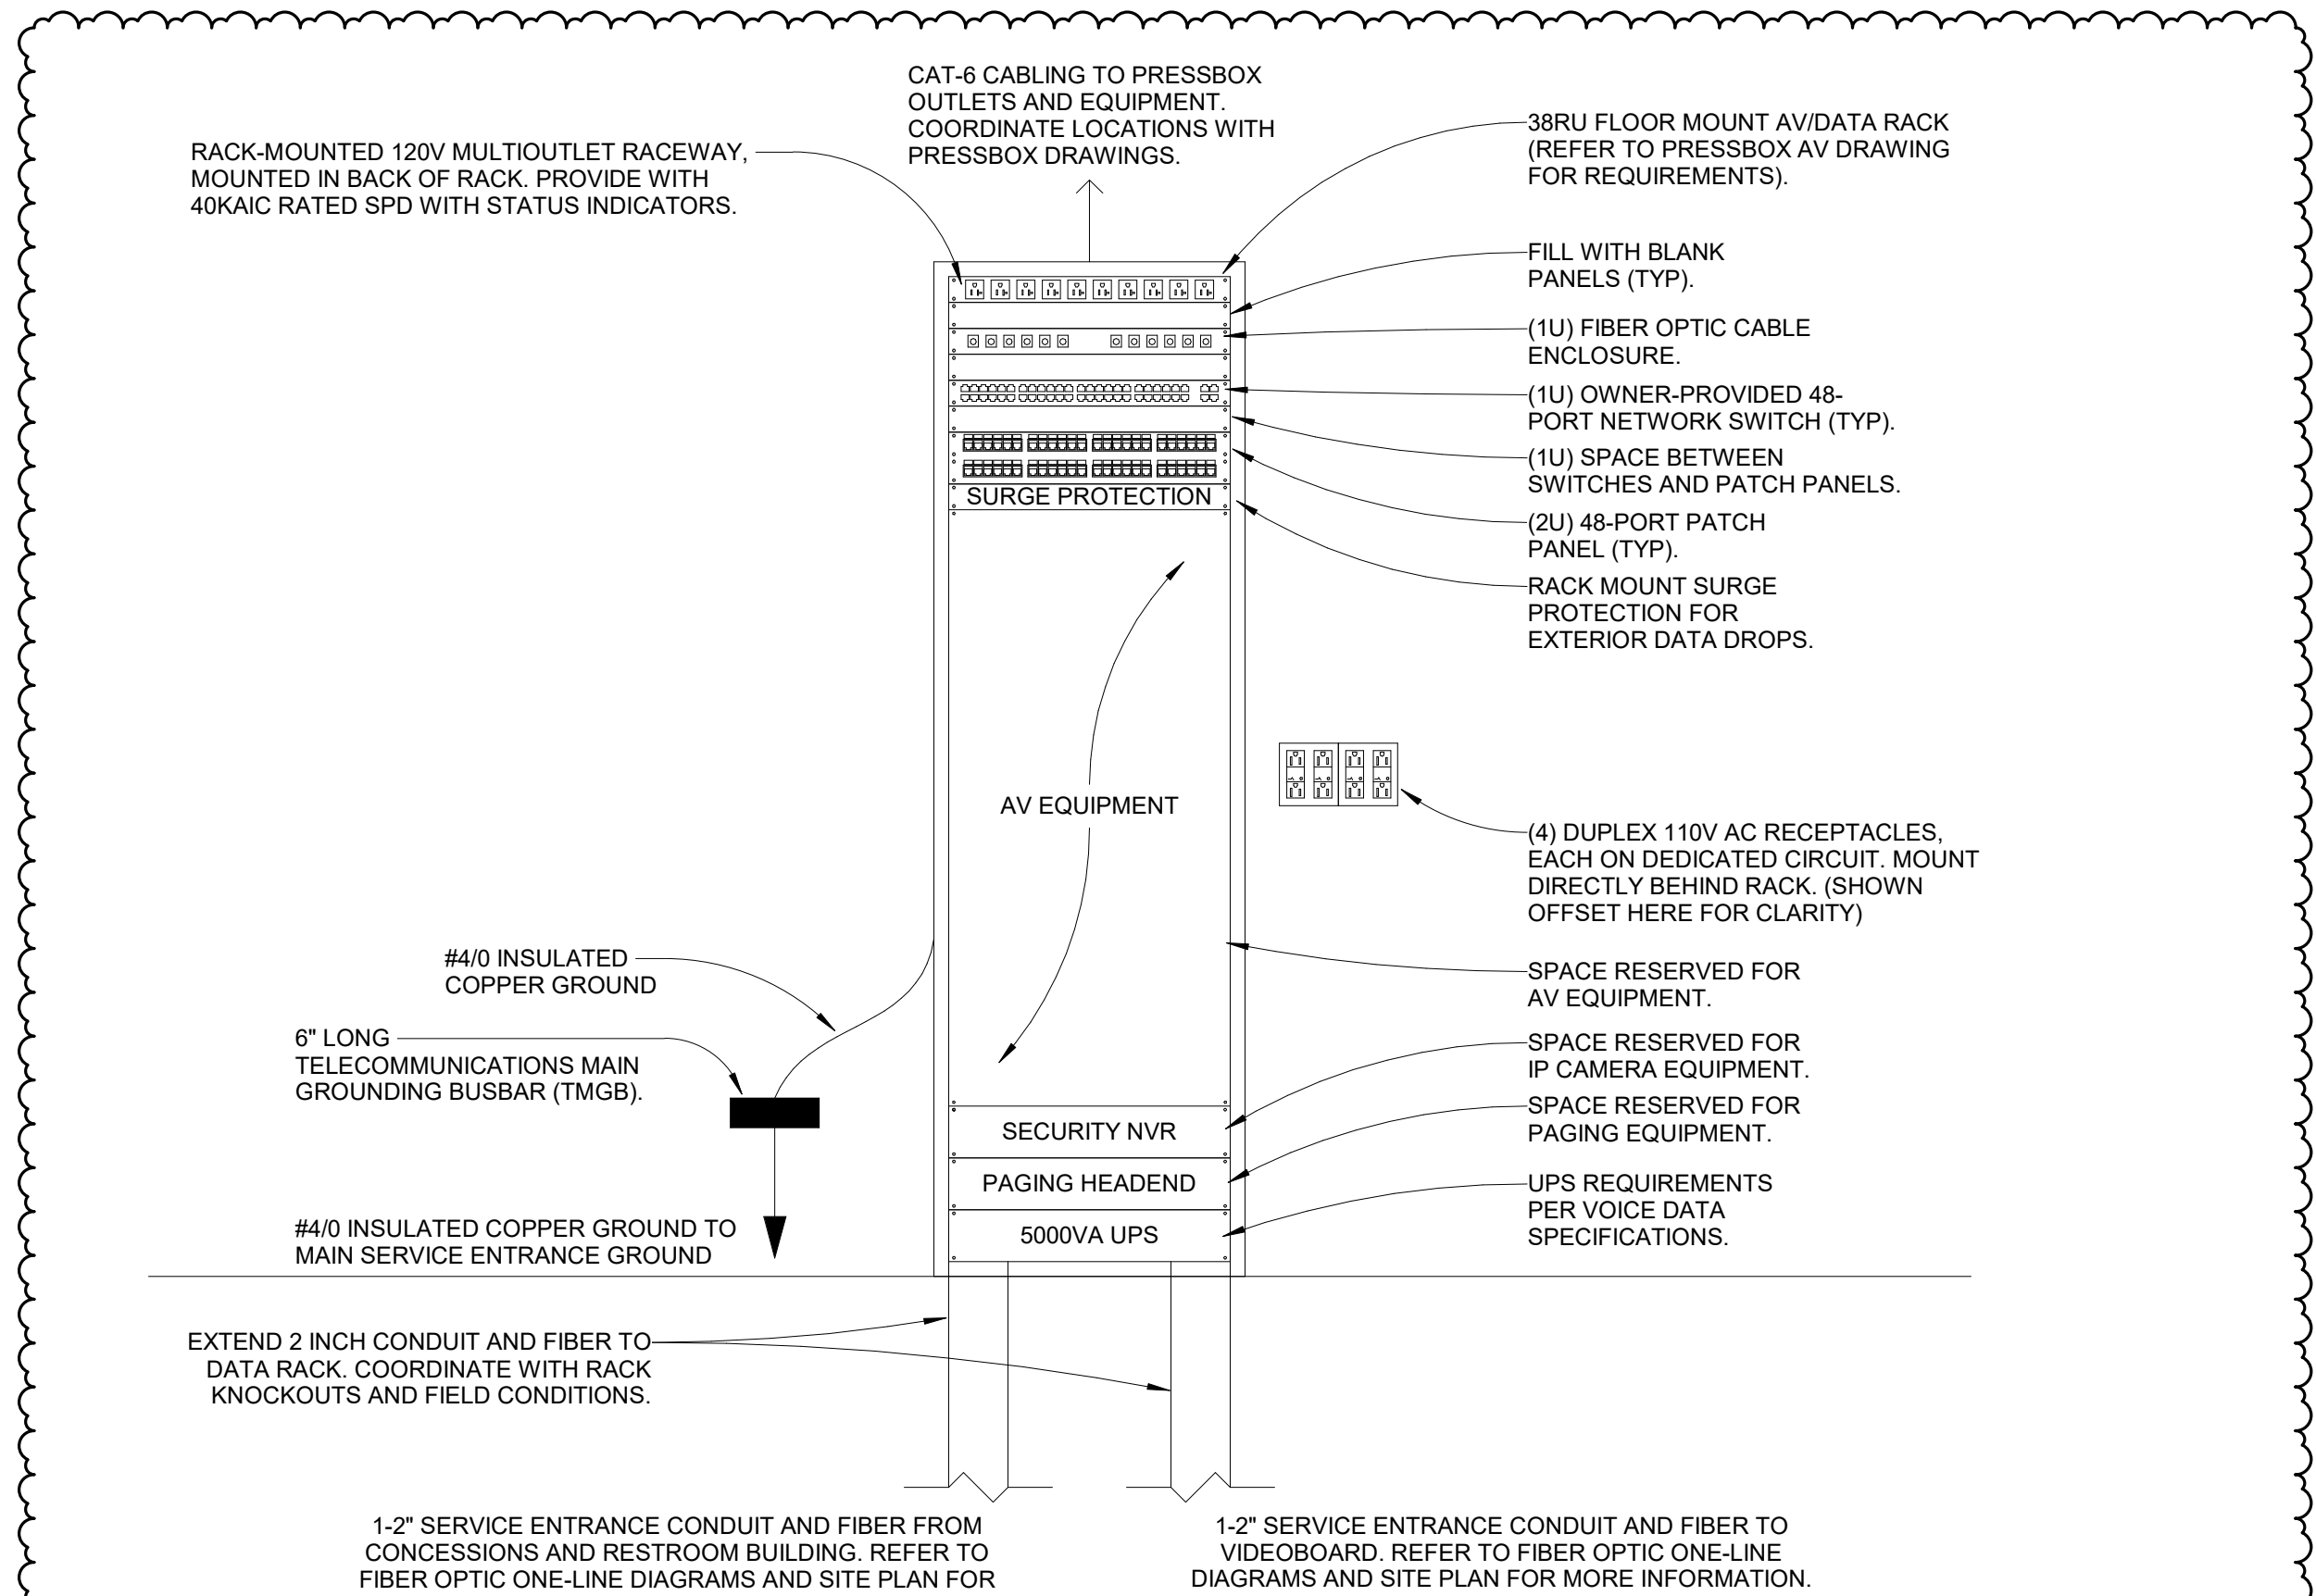

8 COMMUNICATIONS RISER DIAGRAM - PRESSBOX
SCALE: NONE



AIA[®]

Document G731[™] – 2019

Change Order, Construction Manager as Adviser Edition

PROJECT: (name and address)

Woodford County High School Phase 2
145 School House Road, Versailles, KY
40383

OWNER: (name and address)

Woodford County Board of Education
330 Pisgah Pike, Versailles, KY 40383

CONTRACTOR: (name and address)

Rising Sun Developing
2555 Palumbo Drive, Ste 110, Lexington,
KY 40509

CONTRACT INFORMATION:

Contract For: BP02
Date: February 27, 2023

ARCHITECT: (name and address)

RossTarrant Architects
101 Old Lafayette Avenue,
Lexington, KY 40502

CHANGE ORDER INFORMATION:

Change Order Number: 02-04
Date: 11/16/2024

CONSTRUCTION MANAGER: (name and address)

Trace Creek Construction, Inc.
127 Market St., Vanceburg, KY 41179

THE CONTRACT IS CHANGED AS FOLLOWS:

(Insert a detailed description of the change and, if applicable, attach or reference specific exhibits. Also include agreed upon adjustments attributable to executed Construction Change Directives.)

PR #5- Electrical at fence

| | |
|--|-----------------|
| The original Contract Sum was | \$ 1,645,014.00 |
| Net change by previously authorized Change Orders | \$ 208,706.12 |
| The Contract Sum prior to this Change Order was | \$ 1,853,720.12 |
| The Contract Sum will be decreased by this Change Order in the amount of | \$ 1,376.66 |
| The new Contract Sum including this Change Order will be | \$ 1,852,343.46 |

The Contract Time will be unchanged by Zero (0) days.


The Contractor's Work shall be substantially complete on 1/6/2025.

NOTE: This Change Order does not include adjustments to the Contract Sum or Guaranteed Maximum Price, or the Contract Time, that have been authorized by Construction Change Directive until the cost and time have been agreed upon by both the Owner and Contractor, in which case a Change Order is executed to supersede the Construction Change Directive.

NOT VALID UNTIL SIGNED BY THE ARCHITECT, CONSTRUCTION MANAGER, CONTRACTOR, AND OWNER.

RossTarrant Architects

ARCHITECT (Firm name)

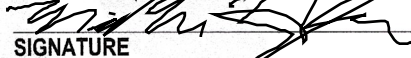

SIGNATURE

Michael Hughes, Project Manager

PRINTED NAME AND TITLE

11/16/2024

DATE:

Rising Sun Developing

CONTRACTOR (Firm name)

SIGNATURE

PRINTED NAME AND TITLE

DATE:

Trace Creek Construction, Inc.

CONSTRUCTION MANAGER (Firm name)



SIGNATURE

Clay Ratliff, Vice President

PRINTED NAME AND TITLE

11/16/2024

DATE:

Woodford County Board of Education

OWNER (Firm name)

SIGNATURE

PRINTED NAME AND TITLE

DATE:

FACPAC Contract Change Order Supplemental Information Form (Ref# 61261)

Form Status: Saved

Tier 1 Project: High School Project Phase 2 Practice Field & Track - 20220829124351
 BG Number: 23-120 District: Woodford County (HB678) (601)
 Status: Active Phase: Project Initiation (View Checklist)

Contract: Rising Sun Developing, Inc., 0002, General Trades
 Type: CM Bid Package Proposed

Change Order Number 02-04
 Time Extension Required No
 Date Of Change Order 11/16/2024
 Change Order Amount To Date Decrease

Construction Contingency

Calculations below are project wide. Remaining negative Construction Contingency may require the submission of a revised BG1.

| | |
|------------------------------|--------------|
| Current Approved Amount | \$684,002.00 |
| Net Approved COs | \$341,480.32 |
| Remaining After Approved COs | \$342,521.68 |
| Net All COs | \$340,103.66 |
| Remaining After All COs | \$343,898.34 |

This Requested Change Order Amount (\$1,376.66)

+/-

Change In A/E Fee This Change Order \$0.00

+/-

Change In CM Fee This Change Order \$0.00

+/-

Remaining Construction Contingency \$304,650.89

Balance

Contract Change Requested By Architect/Engineer

Contract Change Reason Code Reduction of Scope

Change Order Description And Justification

Electrical outlets removed from fence due to fence alternate not being accepted.

Cost Benefit To Owner

Cost savings to the owner for scope that is no longer required or needed.

Contract unit prices have been utilized No
to support the cost associated with this
change order.

Detailed Cost Breakdown

Contract unit prices have not been utilized, provide a detailed cost breakdown which
separates labor, material, profit and overhead.

| Detail Item | Amount | Percent of Total |
|-----------------------|-------------|------------------|
| Labor | (\$957.65) | 69.56% |
| Materials | (\$419.01) | 30.44% |
| Profit and Overhead | | 0.00% |
| Bond Insurance | | 0.00% |
| Cost Breakdown Total: | \$-1,376.66 | |

Cost for this Change Order supported No
by an alternate bid or competitive price
quote

Explain Why

Pricing was reviewed by CM and Design Team and deemed to be accurate and fair.

Change Order Supplemental Information Form Signature Page (Online Form Ref# 61261)



Architect

11/16/2024

Date



Construction Manager

11/16/2024

Date

Finance Officer

Date

Local Board of Education Designee

Date



AIA® Document G731™ – 2019

Change Order, Construction Manager as Adviser Edition

PROJECT: *(name and address)*
Woodford County High School Phase 2
145 School House Road, Versailles, KY
40383

OWNER: *(name and address)*
Woodford County Board of Education
330 Pisgah Pike, Versailles, KY 40383

CONTRACTOR: *(name and address)*
Olympic Construction, LLC
Nicholasville, KY 40383

CONTRACT INFORMATION:
Contract For: BP05
Date: September 19, 2024

ARCHITECT: *(name and address)*
RossTarrant Architects
101 Old Lafayette Avenue,
Lexington, KY 40502

CHANGE ORDER INFORMATION:
Change Order Number: 05-01
Date: 11/16/2024

CONSTRUCTION MANAGER: *(name and address)*
Trace Creek Construction, Inc.
127 Market St., Vanceburg, KY 41179

THE CONTRACT IS CHANGED AS FOLLOWS:

(Insert a detailed description of the change and, if applicable, attach or reference specific exhibits. Also include agreed upon adjustments attributable to executed Construction Change Directives.)

PR 06-Bleachers

| | | |
|--|----|--------------|
| The original Contract Sum was | \$ | 874,389.66 |
| Net change by previously authorized Change Orders | \$ | 0.00 |
| The Contract Sum prior to this Change Order was | \$ | 874,389.66 |
| The Contract Sum will be increased by this Change Order in the amount of | \$ | 306,035.70 |
| The new Contract Sum including this Change Order will be | \$ | 1,180,425.36 |

The Contract Time will be increased by Thirty-Six (36) days.
The Contractor's Work shall be substantially complete on 2/10/2025.

NOTE: This Change Order does not include adjustments to the Contract Sum or Guaranteed Maximum Price, or the Contract Time, that have been authorized by Construction Change Directive until the cost and time have been agreed upon by both the Owner and Contractor, in which case a Change Order is executed to supersede the Construction Change Directive.

NOT VALID UNTIL SIGNED BY THE ARCHITECT, CONSTRUCTION MANAGER, CONTRACTOR, AND OWNER.

RossTarrant Architects

ARCHITECT *(Firm name)*

SIGNATURE

Michael Hughes, Project Manager

PRINTED NAME AND TITLE

11/16/2024

DATE:

Olympic Construction, LLC

CONTRACTOR *(Firm name)*

SIGNATURE

PRINTED NAME AND TITLE

DATE:

Trace Creek Construction, Inc.

CONSTRUCTION MANAGER *(Firm name)*

SIGNATURE

Clay Ratliff, Vice President

PRINTED NAME AND TITLE

11/16/2024

DATE:

Woodford County Board of Education

OWNER *(Firm name)*

SIGNATURE

PRINTED NAME AND TITLE

DATE:

FACPAC Contract Change Order

Supplemental Information Form (Ref# 61262)

Form Status: Saved

Tier 1 Project: High School Project Phase 2 Practice Field & Track - 20220829124351
 BG Number: 23-120 District: Woodford County (HB678) (601)
 Status: Active Phase: Project Initiation (View Checklist)

Contract: Olympic Construction, LLC, 0005, Concession and Restroom Building
 Type: CM Bid Package Proposed

| | |
|-----------------------------|------------|
| Change Order Number | 05-01 |
| Time Extension Required | Yes |
| If Yes Number Of Days | 36 |
| Date Of Change Order | 11/16/2024 |
| Change Order Amount To Date | Increase |

Construction Contingency

Calculations below are project wide. Remaining negative Construction Contingency may require the submission of a revised BG1.

| | |
|------------------------------|--------------|
| Current Approved Amount | \$684,002.00 |
| Net Approved COs | \$341,480.32 |
| Remaining After Approved COs | \$342,521.68 |
| Net All COs | \$646,139.36 |
| Remaining After All COs | \$37,862.64 |

This Requested Change Order Amount \$306,035.70

+/-

Change In A/E Fee This Change Order \$17,444.03

+/-

Change In CM Fee This Change Order \$13,771.60

+/-

Remaining Construction Contingency (\$32,600.44)

Balance

| | |
|------------------------------|---------------------------------|
| Contract Change Requested By | Local Board of Education; Owner |
| Contract Change Reason Code | Expansion of Scope |

Change Order Description And Justification

Include all site, concrete, and utilities to allow for future 2,500 student grandstand and upgraded athletic lighting.

Cost Benefit To Owner

Prepares the owner for future expansion of seating.

Contract unit prices have been utilized Yes
to support the cost associated with this
change order.

Detailed Cost Breakdown

Contract unit prices have not been utilized, provide a detailed cost breakdown which separates labor, material, profit and overhead.

| Detail Item | Amount | Percent of Total |
|------------------------------|---------------------|------------------|
| Labor | \$131,705.90 | 43.04% |
| Materials | \$146,934.50 | 48.01% |
| Profit and Overhead | \$27,395.30 | 8.95% |
| Bond Insurance | | 0.00% |
| Cost Breakdown Total: | \$306,035.70 | |

Cost for this Change Order supported No
by an alternate bid or competitive price
quote

Explain Why

Pricing has been reviewed by CM and Design Team and deemed to be fair and accurate.

Change Order Supplemental Information Form Signature Page (Online Form Ref# 61262)



11/16/2024

Architect

Date



11/16/2024

Construction Manager

Date

Finance Officer

Date

Local Board of Education Designee

Date