**PROJECT** (Name and Address)
EAST HEIGHTS ELEMENTARY SCHOOL RENOVATION
1776 ADAMS LANE
HENDERSON, KY 42420

CHANGE ORDER NUMBER: 14-3 INITIATION DATE: 6/11/2025

TO CONTRACTOR (Name and Address)

IES KENTUCKY LLC

PROJECT NUMBERS: 000847 CONTRACT DATE: 1/6/2025

CONTRACT FOR: BID PACKAGE #14 ELECTRICAL

#### THE CONTRACT IS CHANGED AS FOLLOWS:

The original Contract Sum was 3,822,494.86

Net change by previously authorized Change Orders 930.00

The Contract Sum prior to this Change Order was 3,823,424.86

The Contract Sum will be Increased by this Change Order in the amount of 793.00

The new Contract Sum including this Change Order will be 3,824,217.86

The Contract Time will be adjusted by 0 days.

The date of Substantial Completion as of the date of this Change Order therefore is 7/22/2027.

### NOT VALID UNTIL SIGNED BY THE CONSTRUCTION MANAGER, ARCHITECT, CONTRACTOR AND OWNER.

CODELL CONSTRUCTION COMPANY		RBS DESIGN GROUP ARCHITECTURE	
CONSTRUCTION MANAGER (Firm Name) 4475 ROCKWELL ROAD WINCHESTER, KY 40391		ARCHITECT (Firm Name) 723 HARVARD DRIVE OWENSBORO, KY 42301	
ADDRESS		ADDRESS	
BY (Signature)		BY (Signature)	
(Typed Name)	DATE:	(Typed Name)	DATE:
IES KENTUCKY LLC		HENDERSON COUNTY BOARD OF EDUCATION	
CONTRACTOR (Firm Name) 1550 EAST 11TH STREETOWENSBORO, KY 42303		OWNER (Firm Name) 1805 SECOND STREET HENDERSON, KY 42420	
ADDRESS		ADDRESS	
BY (Signature)		BY (Signature)	
(Typed Name)	DATE:	(Typed Name)	DATE:

## Change Order - Construction Manager-Adviser Edition

OWNER ⊠
CONSTRUCTION MANAGER
ARCHITECT □
CONTRACTOR ☐
FIELD 🗌
OTHER $\square$

1

PROJECT (Name and Address)
EAST HEIGHTS ELEMENTARY SCHOOL RENOVATION
1776 ADAMS LANE
HENDERSON, KY 42420

CHANGE ORDER NUMBER: 14-3 INITIATION DATE: 6/11/2025

TO CONTRACTOR (Name and Address)
IES KENTUCKY LLC

PROJECT NUMBERS: 000847 CONTRACT DATE: 1/6/2025

**CONTRACT FOR:** BID PACKAGE #14 ELECTRICAL

#### THE CONTRACT IS CHANGED AS FOLLOWS:

The original Contract Sum was 3,822,494.86

Net change by previously authorized Change Orders 930.00

The Contract Sum prior to this Change Order was 3,823,424.86

The Contract Sum will be Increased by this Change Order in the amount of 793.00

The new Contract Sum including this Change Order will be 3,824,217.86

The Contract Time will be adjusted by 0 days.

The date of Substantial Completion as of the date of this Change Order therefore is 7/22/2027.

### NOT VALID UNTIL SIGNED BY THE CONSTRUCTION MANAGER, ARCHITECT, CONTRACTOR AND OWNER.

CODELL CONSTRUCTION COMPANY **RBS DESIGN GROUP ARCHITECTURE CONSTRUCTION MANAGER** (Firm Name) ARCHITECT (Firm Name) 4475 ROCKWELL ROAD WINCHESTER, KY 40391 723 HARVARD DRIVE OWENSBORO, KY 42301 ADDRESS **ADDRESS** BY (Signature) BY (Signature) DATE: (Typed Name) DATE: (Typed Name) IES KENTUCKY LLC HENDERSON COUNTY BOARD OF EDUCATION OWNER (Firm Name) **CONTRACTOR** (Firm Name) 1805 SECOND STRÉET HENDERSON, KY 42420 1550 EAST 11TH STREETOWENSBORO, KY 42303 **ADDRESS ADDRESS** BY (Signature) BY (Signature) DATE: (Typed Name) DATE: (Typed Name)

AlA Document G701/CMa™ – 1992. Copyright © 1992 by The American Institute of Architects. All rights reserved. WARNING: This AlA® Document is protected by U.S. Copyright Law and International Treaties. Unauthorized reproduction or distribution of this AlA® Document, or any portion of it, may result in severe civil and criminal penalties, and will be prosecuted to the maximum extent possible under the law.



OWNER ARCHITECT CONSULTANT CONTRACTOR OTHER **PROJECT:** 

1776 Adams Ln.

East Heights Elementary School

**DATE OF ISSUANCE: 05-29-2025** 

RBS #: Y22006

Henderson, Kentucky 42420

TO CONSULTANT: ARCHITECT:

Codell Construction RBS Design Group, P.S.C. 1030 Burley Blvd. 9850 Von Allmen Ct, Suite 201

Owensboro, KY. 42303 Louisville, KY 40245

### **DESCRIPTION:**

Please provide a credit, including materials, labor and fees for the simplification of the ceiling design in the Media Center.

Refer to attached A1.25 for new ceiling design.

Refer to attached M2.23 for new diffuser layout.

Refer to attached E2.23 for new light fixture layout. 6 Type B1 fixtures have been added; refer to home run pane-circuit number and update panel schedules as required.


Blake Graham	05-29-2025
RBS DESIGN GROUP ARCHITECTURE	DATE

ISSUED BY:

# Henderson County East Heights Elementary Renovation PR #05 05/28/2025

- Item #1 Refer to Sheet M2.23 Air Distribution New Work Plan Phase 2 Area D
  - A. Modified diffuser layout accommodate ceiling change.
- Item #2 Refer to Sheet E2.23 New Work Lighting Plan Phase 2 Area D
  - A. There were a total of six (6) Type B1 fixtures newly added to the Media Center space. Refer to home run pane-circuit number and update panel schedules as required.

END OF ADDENDA ITEMS

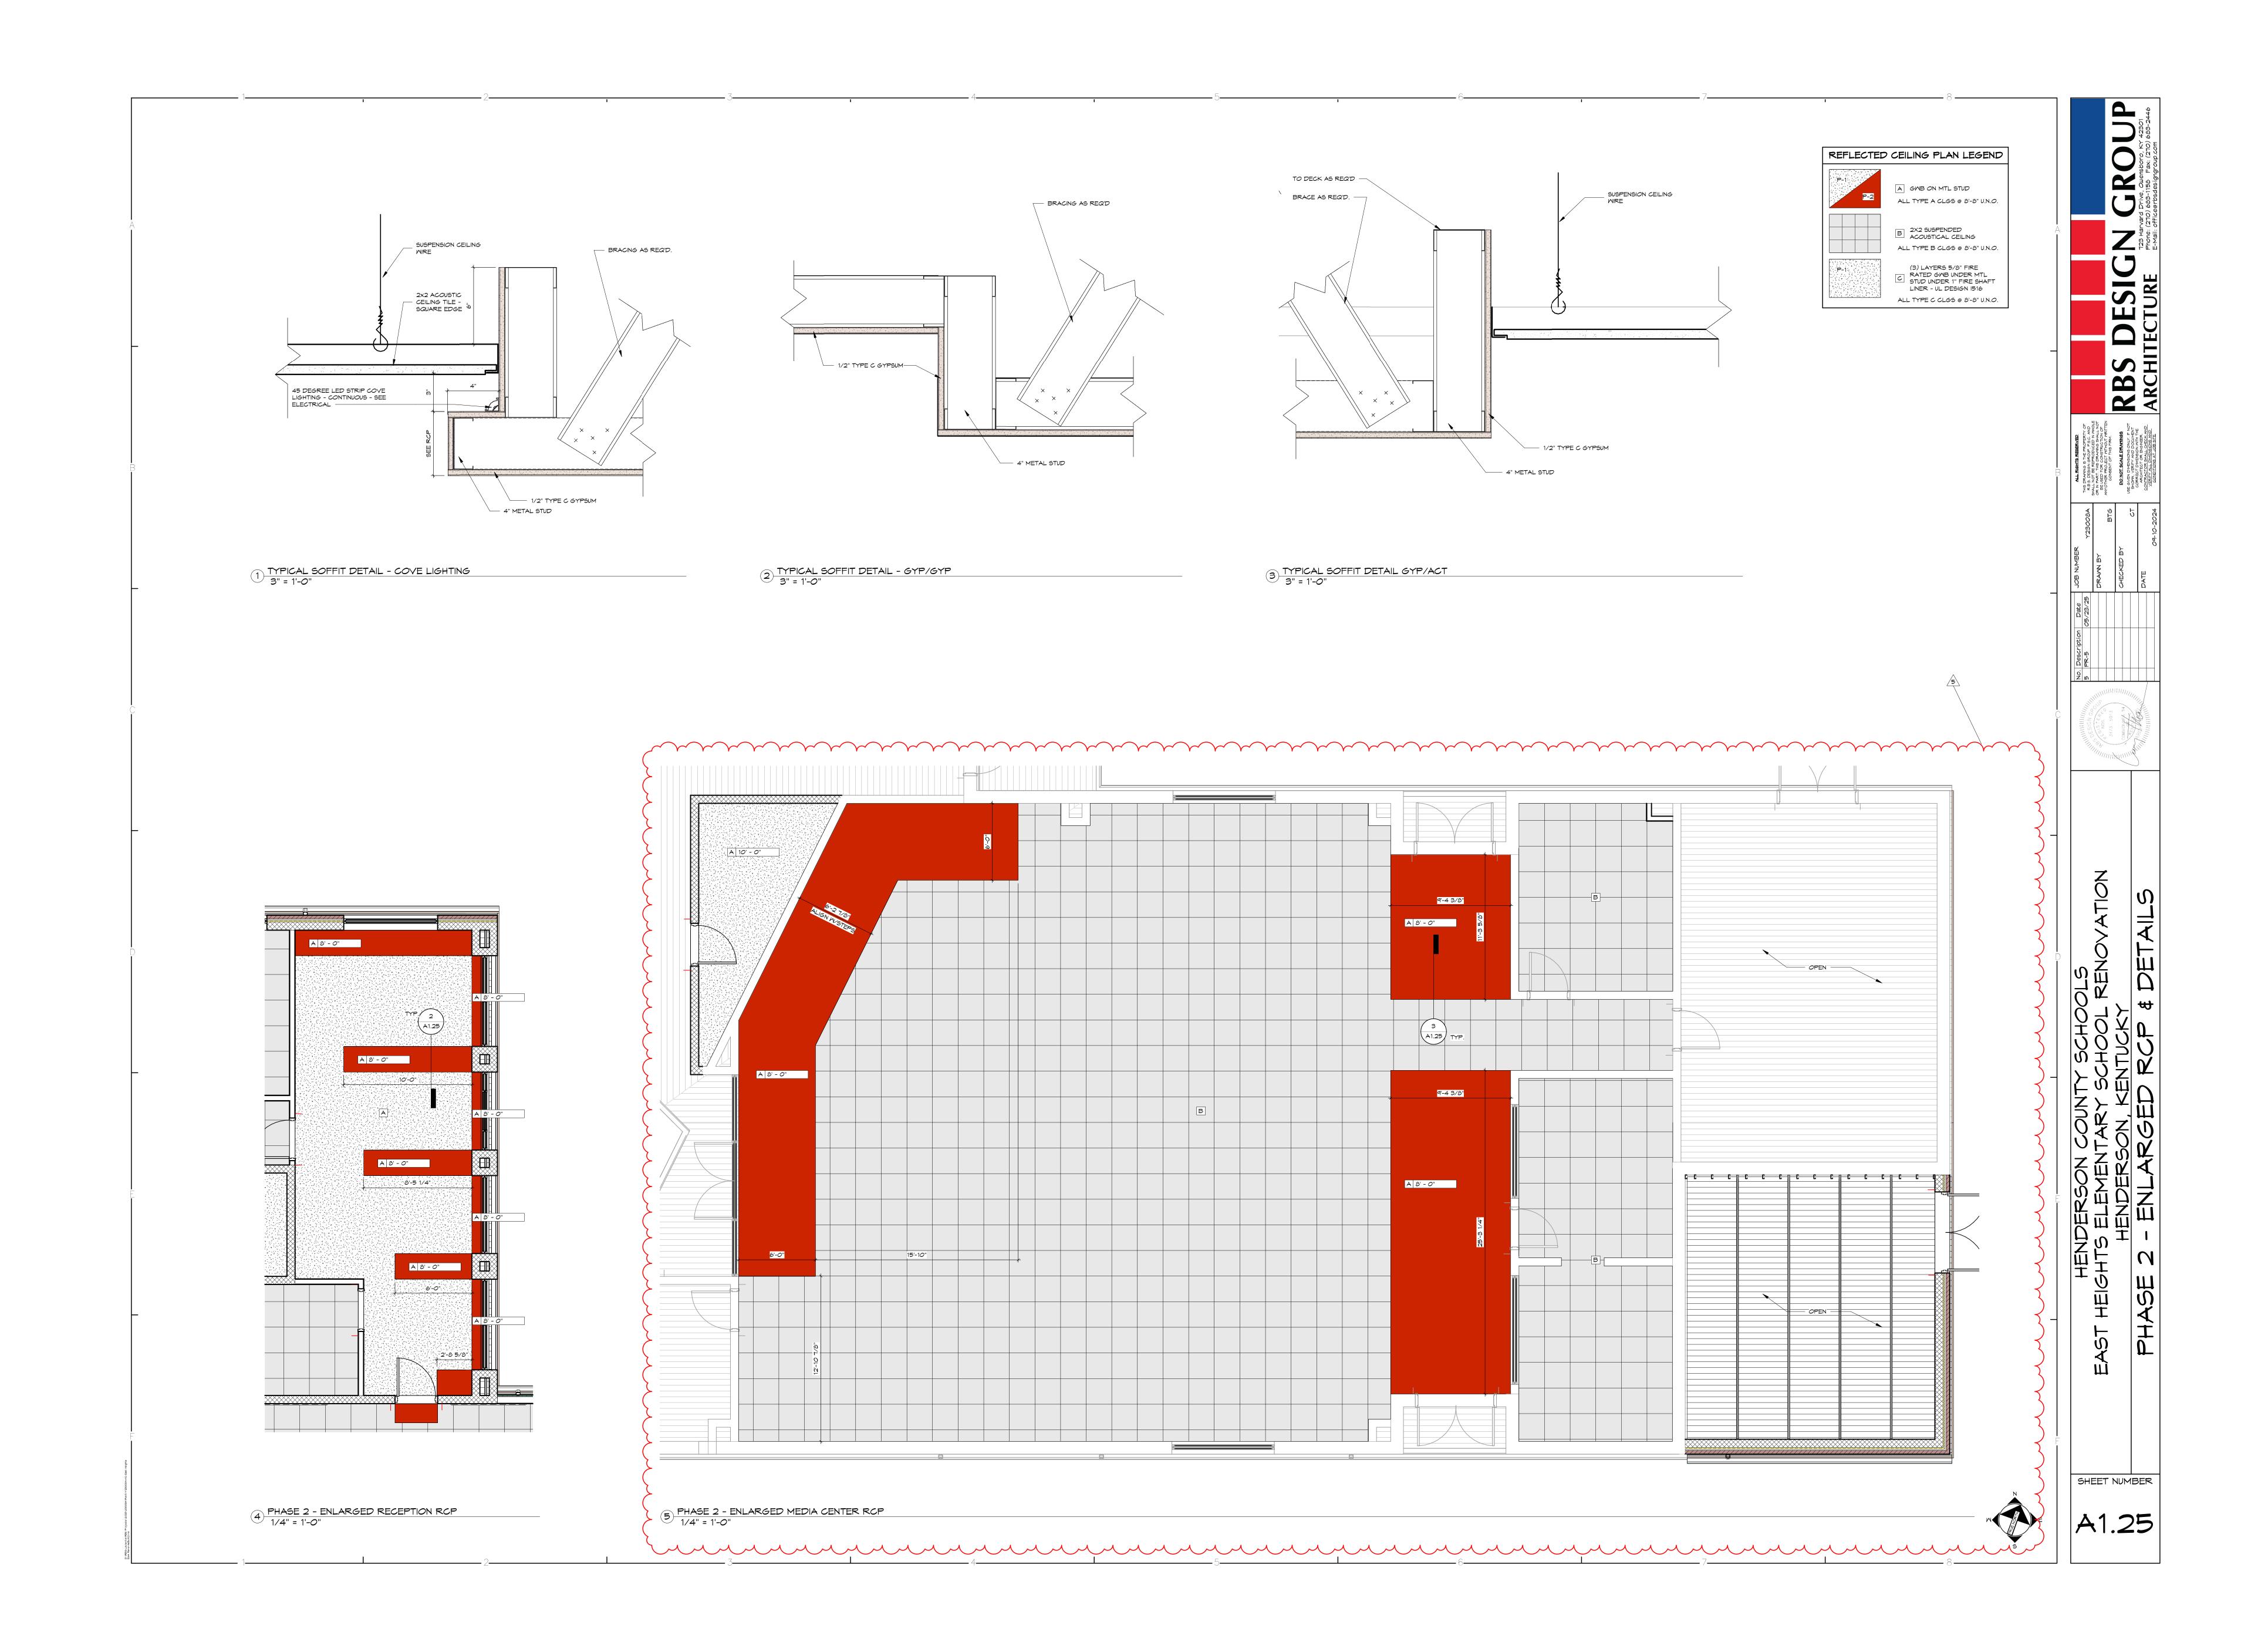

R,G,D RUNOUT SCHEDULE		
<u>MARK</u>	DUCT BRANCH SIZE	
<u>E-1</u>	<u>6"</u>	
<u>E-5</u>	<u>14"</u>	
<u>R-1</u>	<u>6"</u>	
R-1FR	<u>6"</u>	
<u>R-2</u>	<u>8"</u>	
<u>R-2F</u>	<u>8"</u>	
<u>R-3</u>	<u>10"</u>	
<u>R-3F</u>	<u>10"</u>	
<u>R-4</u>	<u>12"</u>	
<u>R-5</u>	<u>14"</u>	
<u>R-5F</u>	<u>14"</u>	
<u>R-11</u>	SEE DWGS	
<u>R-12</u>	SEE DWGS	
<u>R-18</u>	SEE DWGS	
<u>S-1</u>	<u>6"</u>	
S-1FR	<u>6"</u>	
<u>S-2</u>	<u>8"</u>	
<u>S-3</u>	<u>10"</u>	
<u>S-4</u>	<u>12"</u>	
<u>S-11</u>	SEE DWGS	
<u>S-12</u>	SEE DWGS	

SEE DWGS

SEE DWGS

# **GENERAL HVAC DESIGN NOTES:**

- A. IT SHALL BE THE CONTRACTORS RESPONSIBILITY TO INSTALL MANUAL BALANCING DAMPERS IN THE DUCTWORK PER RUNOUT DETAIL FOR ALL GRILLES, REGISTERS, AND DIFFUSERS WHICH LIST A CFM. IN ALL CASES
- DAMPERS ARE TO BE INSTALLED IN AN ACCESSIBLE LOCATION.

  B. ELECTRICAL PANELS SHOWN FOR REFERENCE ONLY. REFER TO ELECTRICAL
- DRAWINGS. NO DUCT OR PIPING SHALL BE ROUTED OVER ELECTRICAL PANELS.

  C. REFER TO ARCHITECTURAL PLANS FOR ALL RATED WALLS. COORDINATE REQUIRED FIRESTOPPING ACCORDINGLY.

# TAGGED NOTES

A1 OUTSIDE AIR DUCT TO BE RECONNECTED AT POINT INDICATED.
PROVIDE 10"X10" ALUMINUM TITUS 350 FL OR EQUAL AT WALL
PENETRATION. WALL PENETRATION TO BE SEALED WATER TIGHT.
REFER TO ARCHITECTURAL DRAWINGS FOR COLOR


- REQUIREMENTS.


  A2 EXHAUST AIR DUCT TO BE RECONNECTED AT POINT INDICATED.
  PROVIDE 10"X10" ALUMINUM TITUS 350 FL OR EQUAL AT WALL
  PENETRATION. WALL PENETRATION TO BE SEALED WATER TIGHT.
  REFER TO ARCHITECTURAL DRAWINGS FOR COLOR
- REFER TO ARCHITECTURAL DRAWINGS FOR COLOR
  REQUIREMENTS.

  A6 HEAT PUMP TO INSTALLED AT LOCATION FOR TEMPORARY USE
  ONLY. RECONNECT DUCT WORK, WATER PIPING, AND
- CONDENSATE AS REQUIRED. REFER TO PHASE 3 MECHANICAL DEMOLITION PLAN.
- A18 SUPPLY AIR DUCT TO BE RECONNECTED AT POINT INDICATED.
  A19 RETURN AIR DUCT TO BE RECONNECTED AT POINT INDICATED.
- A23 SUPPLY AIR DUCT CONNECTION TO LINEAR SLOT TO BE 4 FOOT PLENUM SECTION WITH CONNECTION SIZE TO BE DIAMETER AS INDICATED ON DRAWINGS. TITUS MODEL MP-37 OR EQUAL. BALANCE DAMPER TO BE PLACED IN ACCESSIBLE LOCATION FROM
- MEZZANINE. BALANCE TO 300 CFM.

  A24 RETURN AIR DUCT CONNECTION TO LINEAR SLOT TO BE 4 FOOT PLENUM SECTION WITH CONNECTION SIZE TO BE DIAMETER AS INDICATED ON DRAWINGS. TITUS MODEL MP-37 OR EQUAL. BALANCE DAMPER TO BE PLACED IN ACCESSIBLE LOCATION FROM
- MEZZANINE. BALANCE TO 300 CFM.

  A28 PROVIDE CONCRETE PAD FOR CONDENSING UNIT PER MANUFACTURER REQUIREMENTS.
- MD25 EXISTING EXHAUST FAN, DUCTWORK, DIFFUSERS, ETC. TO REMAIN.

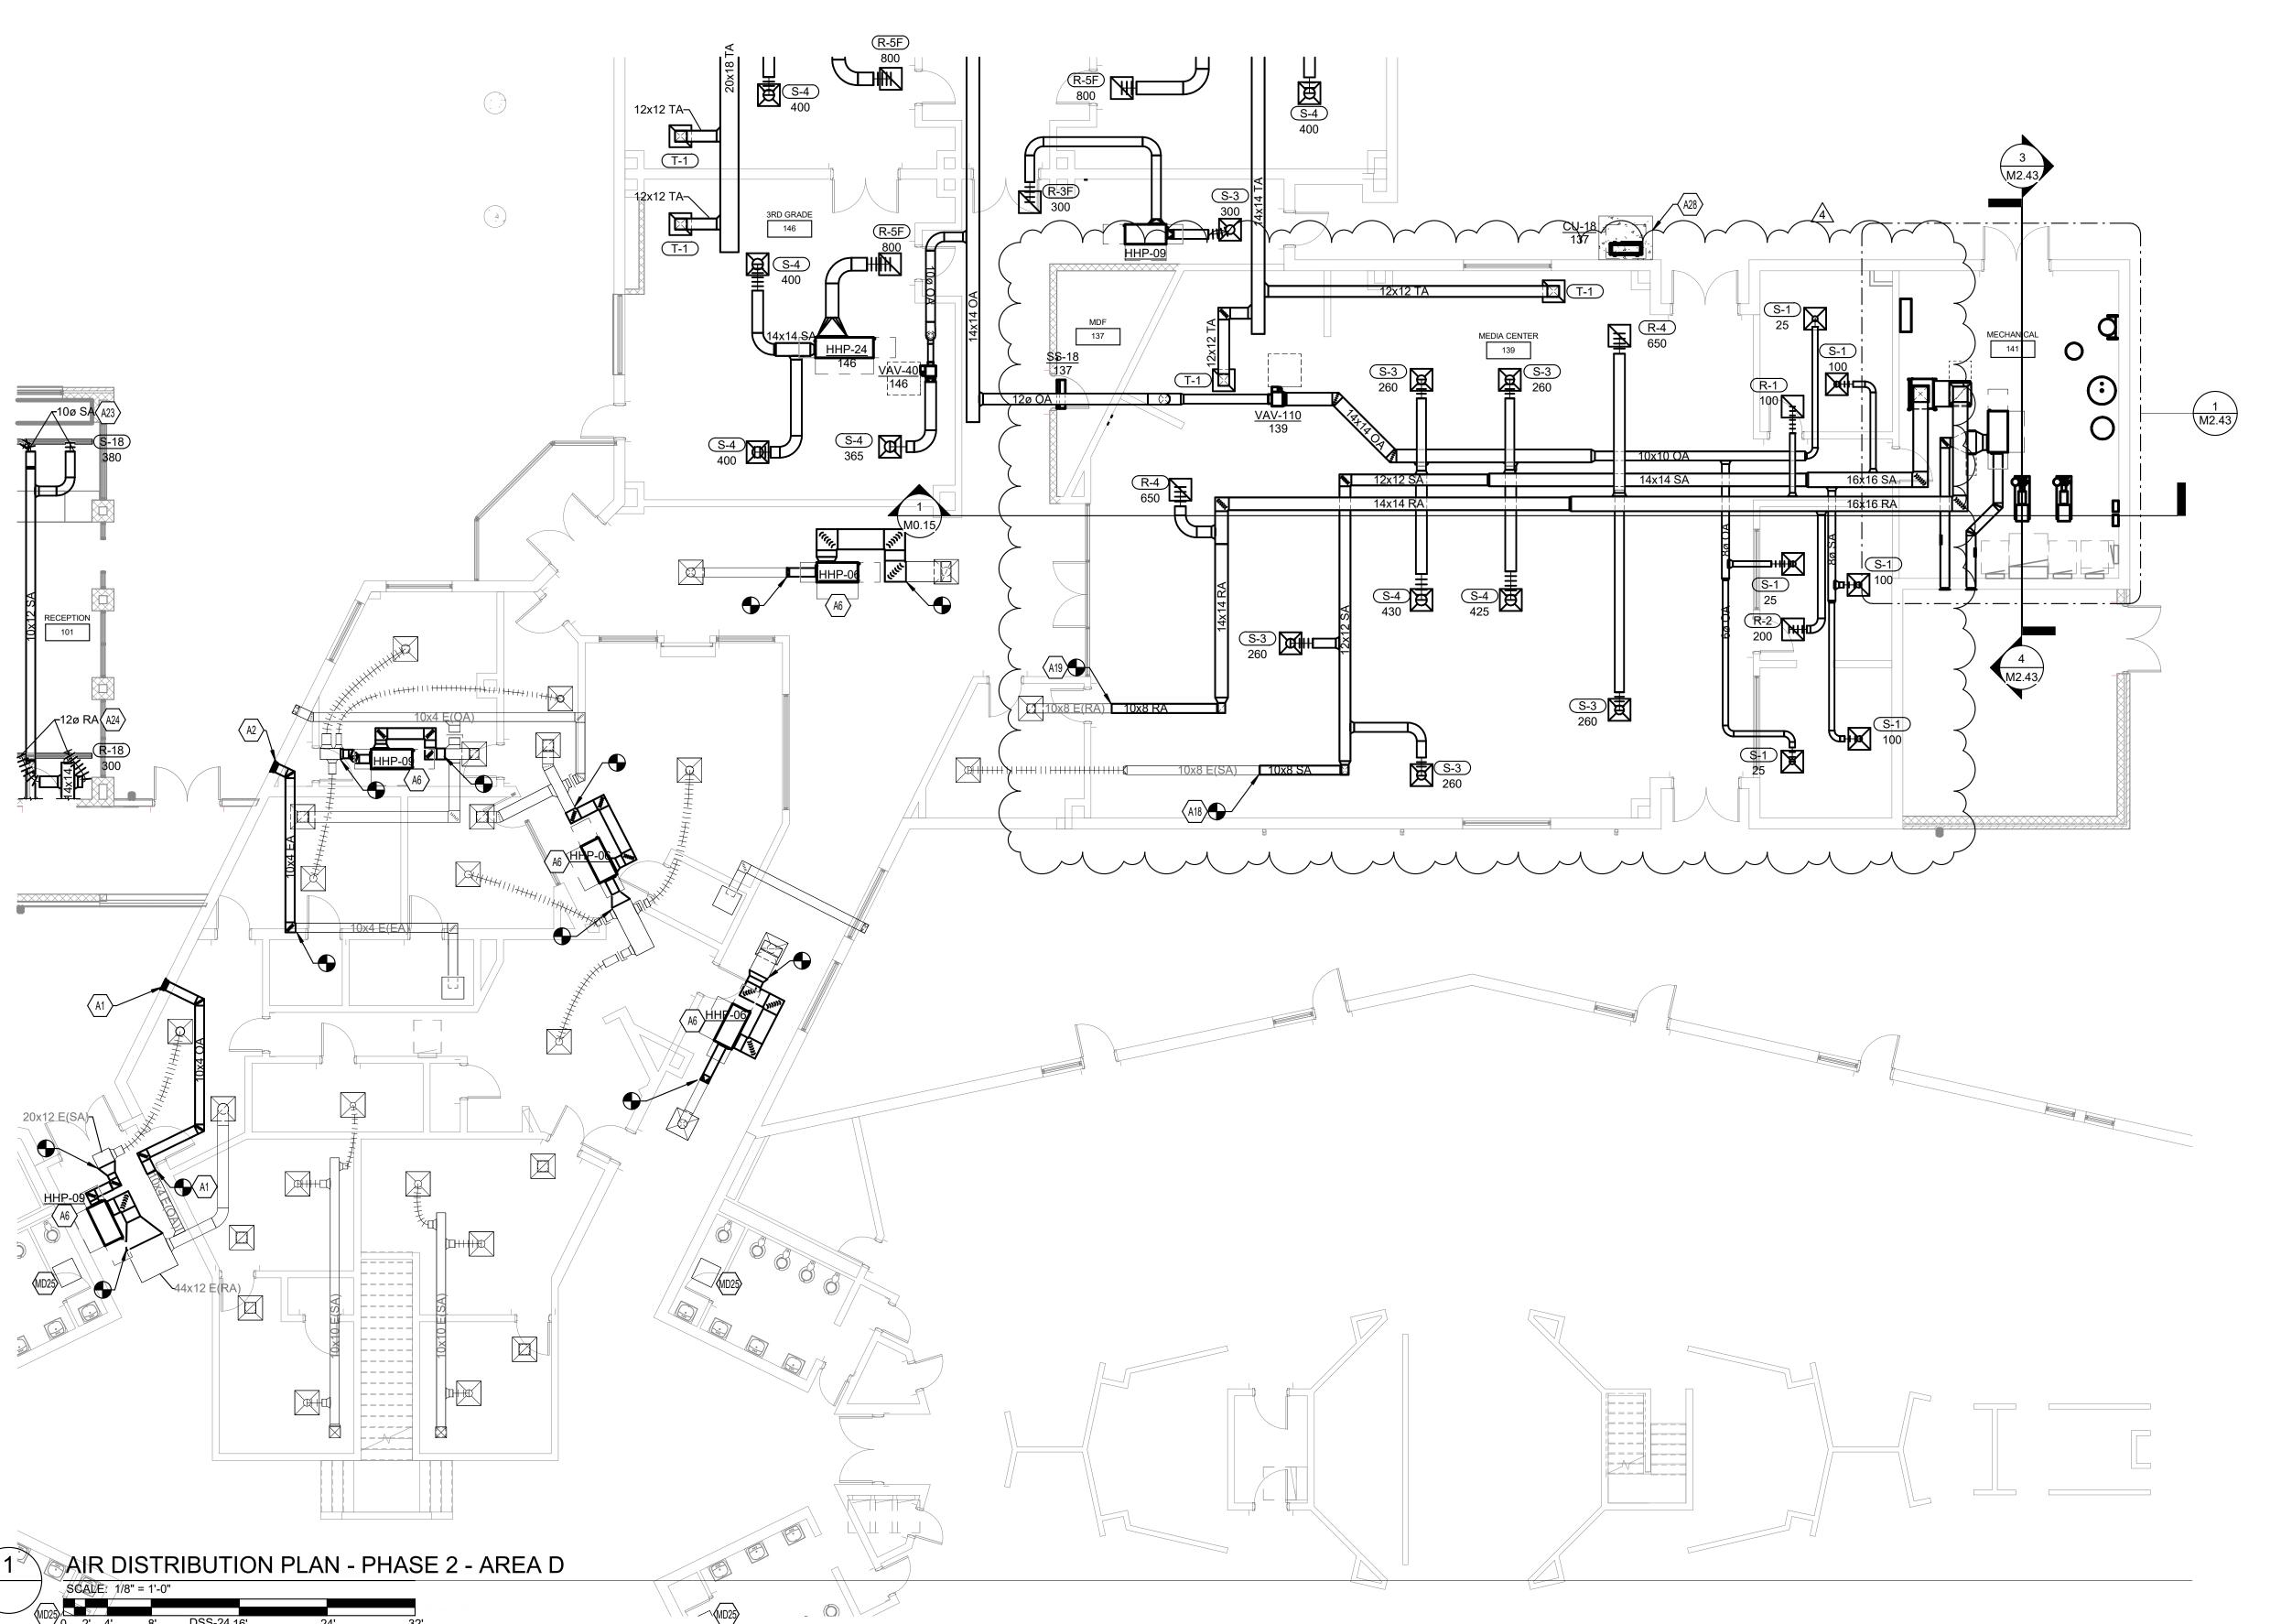

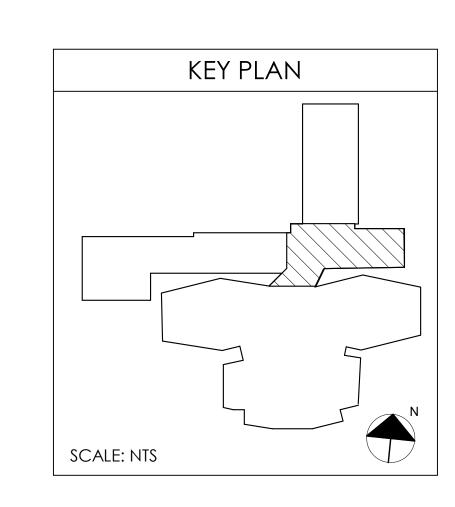

EAST HEIGHTS ELEMENTARY SCHOOL RENOVATION
HENDERSON, KENTUCKY

RBS DESICARE ARCHITECTURE

SHEET NUMBER

M2.23

LIGHTING CONTROL. L5 REFER TO ARCHTIECTURAL PLANS FOR PHASING OF THIS BUILDING. CIRCUIT FEEDERS FOR EMERGENCY LIGHTING, IN THIS EXISTING WING TO REMAIN, SHALL BE TRENCHED AND TERMINATE TO NEDP1 PANEL . REFER TO NEW ELECTRICAL SITE UTILITY PLAN

FOR TRENCH ROUTING. L8 ELECTRICAL CONTRACTOR SHALL BE RESPONSIBLE FOR ADJUSTMENTS/EXTENSIONS OF WIRING TO LIGHT FIXTURES AS NECESSARY AND VERIFICATION OF FUNCTIONALITY UPON

LIGHTING IN THIS MDF 137 ROOM.

L9 ELECTRICAL CONTRACTOR TO PROVIDE WALL MOUNTING FOR

A. REFER TO THE ARCHITECT'S REFLECTED CEILING PLANS, ELEVATIONS, AND CASEWORK DETAILS FOR EXACT LOCATIONS OF ALL WALL AND CEILING MOUNTED ELECTRICAL DEVICES. B. CONTRACTOR SHALL FOLLOW BRANCH CIRCUITING LAY-OUT, AS INDICATED ON THE FLOOR PLANS, WITH A MAXIMUM OF THREE (3) BRANCH

CIRCUITS PER HOMERUN. EACH BRANCH CIRCUIT SHALL BE PROVIDED WITH A DEDICATED NEUTRAL CONDUCTOR. DEDICATED NEUTRAL CONDUCTORS SHALL BE CONSIDERED CURRENT CARRYING. IF ADDITIONAL CONDUCTORS ARE RAN IN THE SAME CONDUIT WITH THOSE INDICATED, CONTRACTOR SHALL DERATE ALL CURRENT CARRYING CONDUCTORS PER N.E.C. #310.15(B)(3), AND UPSIZE CONDUIT AS REQUIRED PER N.E.C. # 300.17 AND ANNEX C. MULTIWIRE BRANCH CIRCUITS AS DEFINED IN N.E.C #100 / 210.4 (CIRCUITS SHARING A COMMON NEUTRAL CONDUCTOR)

C. IDENTIFY THE PANEL AND CIRCUIT NUMBER FOR ALL RECEPTACLES, SWITCHES, ETC. IN AREA OF CONSTRUCTION. PROVIDE CLEAR ADHESIVE LABELS WITH BLACK LETTERING. IN HEALTHCARE FACILITIES, ENGRAVE EMERGENCY DEVICE COVERPLATES IN PATIENT CARE AREAS. ALSO, MARK INSIDES OF ALL DEVICE BOXES WITH PANEL AND CIRCUIT NUMBER. D. LOCATE CHAIN-HUNG INDUSTRIAL FIXTURES IN MECHANICAL ROOMS TO AVOID DUCTWORK AND PIPING, TO MAXIMIZE AVAILABLE LIGHT. SPACE

AROUND EQUIPMENT, AIR HANDLERS, ETC. TO PROVIDE ADEQUATE LIGHTING TO ALL AREAS OF ROOM. PROVIDE ADDITIONAL FIXTURES OF SAME TYPE AS NEEDED TO FULFILL THIS REQUIREMENT. E. LOCATE EXIT SIGNS FOR MAXIMUM VIEWING AREA TO IDENTIFY EGRESS PATHS AS INDICATED ON PLANS. COORDINATE LOCATIONS SUCH THAT


ARCHITECTURAL FEATURES OR EQUIPMENT FROM OTHER TRADES DO NOT OBSTRUCT VIEW. F. LUMINAIRES INDICATED WITH MULTI-LEVEL SWITCHING SHALL HAVE SIMILAR LAMPS CONTROLLED TOGETHER, I.E. INBOARD AND OUTBOARD LAMPS

OR RIGHT AND LEFT HAND LAMPS. G. ALL LIGHTING FIXTURE LENSES, PARABOLIC LOUVERS, DOWNLIGHTING ALZAK CONES AND "PARACUBE" LOUVERS SHALL BE HANDLED WITH COTTON GLOVES DURING INSTALLATION AND LAMPING TO AVOID FINGERPRINTS OR DIRT DEPOSITS. IT IS PREFERRED THAT FIXTURES BE SHIPPED AND INSTALLED WITH CLEAR PLASTIC BAGS TO PROTECT LOUVERS. AT CLOSE OF PROJECT, AND AFTER CONSTRUCTION AIR FILTERS ARE CHANGED, REMOVE BAGS. ANY LOUVER OR CONE SHOWING DIRT OR FINGER PRINTS SHALL BE CLEANED WITH SOLVENT RECOMMENDED BY THE


MANUFACTURER, OR REPLACED AS NECESSARY IN ORDER TO TURN OVER TO THE OWNER NEW FIXTURES AT OCCUPANCY. H. RECESSED LUMINAIRES SHALL BE SECURED SUCH THAT THE FORCE REQUIRED INSERTING LAMPS, TRIMS, LENSES, LOUVERS, OR DOOR FRAMES DOES

NOT SHIFT HOUSING. ALL TRIMS SHALL BE COMPLETELY FLUSH WITH FINISHED CEILINGS AT COMPLETION OF CONSTRUCTION. I. CONTRACTOR SHALL PROVIDE UNSWITCHED CONDUCTOR TO ALL EXIT SIGNS, EMERGENCY GENERATOR POWERED LIGHTS.

J. PROVIDE TIMECLOCK FOR ALL EXTERIOR LIGTHING/SIGNAGE.

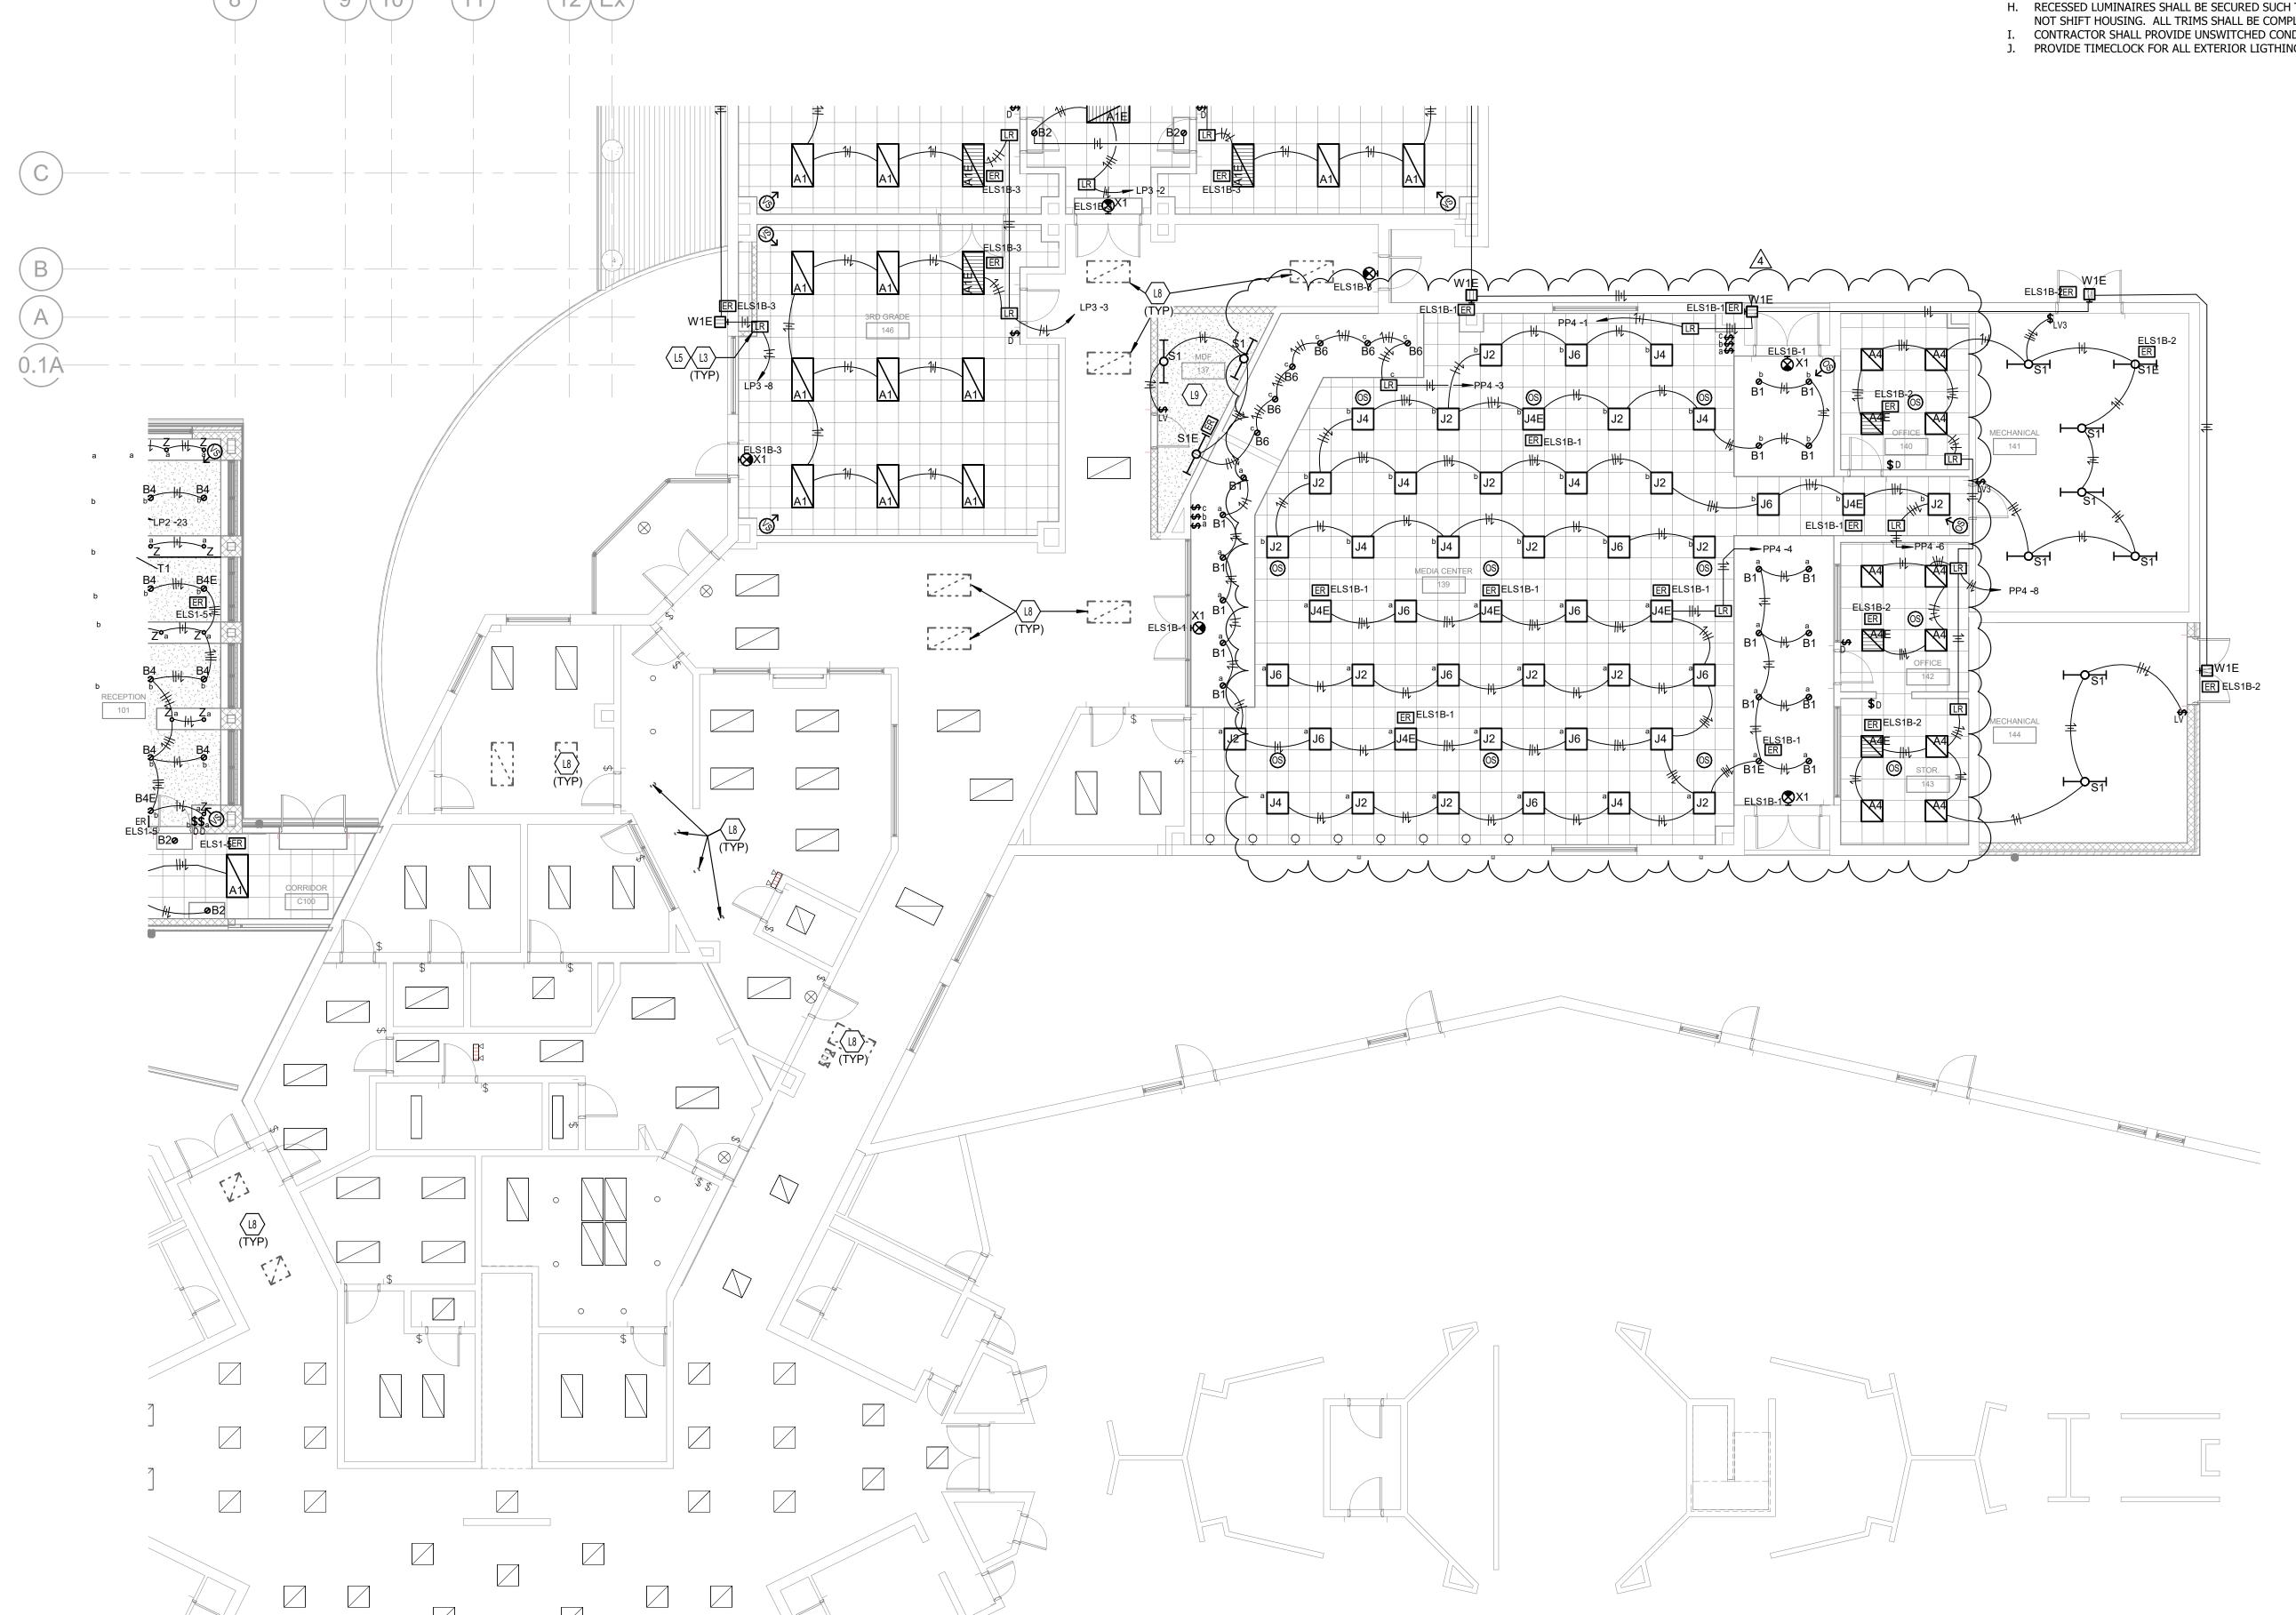

NEW WORK LIGHTING PLAN - PHASE 2 - AREA

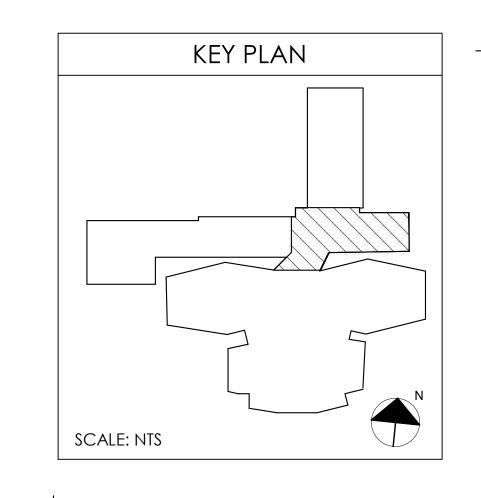

AREA / SCHOOLS CHOOL RENOVATION

SHEET NUMBER

**EAST** 

E2.23

# FACPAC Contract Change Order Supplemental Information Form (Ref# 62554)

Form Status: Saved

Tier 1 Project: East Heights Elementary Renovations

BG Number: 24-164 District: Henderson County (HB678) (251)

Status: Active Phase: Project Initiation (View Checklist)

Contract: IES KENTUCKY LLC, 0014, ELECTRICAL

Type: CM Bid Package Proposed

Change Order Number 14-3 Time Extension Required No

Date Of Change Order 6/11/2025

Change Order Amount To Date

### **Construction Contingency**

Calculations below are project wide. Remaining negative Construction Contingency may require the submission of a revised BG1.

Current Approved Amount \$1,065,424.21

Net Approved COs \$0.00

Remaining After Approved COs \$1,065,424.21

Net All COs \$119,195.00

Remaining After All COs \$946,229.21

This Requested Change Order Amount \$793.00

+/-

Change In A/E Fee This Change Order \$42.82

+/-

Change In CM Fee This Change Order \$15.07

+/-

Remaining Construction Contingency \$946,171.32

Balance

Contract Change Requested By
Contract Change Reason Code

Architect/Engineer
Improved Plans/Specs

Change Order Description And Justification

This change orders inludes the pricing for PR #6 ceiling changes in the media center.

Cost Benefit To Owner

Owner gets a revised ceiling layout with better lighting.

Contract unit prices have been utilized No to support the cost associated with this change order.

## **Detailed Cost Breakdown**

Contract unit prices have not been utilized, provide a detailed cost breakdown which separates labor, material, profit and overhead.

Detail Item	Amount	Percent of Total
Labor	\$690.00	87.01%
Materials	\$0.00	0.00%
Profit and Overhead	\$103.00	12.99%
Bond Insurance	\$0.00	0.00%
Cost Breakdown Total:	\$793.00	

Cost for this Change Order supported No by an alternate bid or competitive price quote
Explain Why

PR was issued after bid.

Change Order Supplemental Information Form Signature Page (Online Form Ref# 62554)				
Architect	Date			
Construction Manager	Date			
Finance Officer	Date			
Local Board of Education Designee	Date			



### **Proposal Request Transmittal**

**PR#4** 

East Heights Elementary School Renovation (000847)

1776 ADAMS LANE HENDERSON, KY 42420

### PR #4 Media Center Ceiling Changes

Attached you will find a copy of PR #4 Media Center Ceiling Changes

Please review the Proposal Request for any change in your scope of work. All cost or credits must be calculated by using the Unit Prices in your contract, if they apply. Please provide a detailed breakdown (quantities, materials and labor) for all cost and/or credits related to your scope of work. If additional work days are required to complete your scope of work as a result of the attached Proposal Request, please include the Time Extension with your pricing. All pricing must be submitted in Project Sight within ten working days upon receipt of this request.

If you have any questions contact Colton Miller at cmiller@codellconstruction.com.

Cost and/or credits should be broken down as follows:

Material, Labor, & Equipment Subtotal: \$690

Overhead/Profit Markup: \$103

Deduct DPO (Direct Purchase Order) Material:

\$510

Total Add/Deduct:

\$1,303

Pricing must be submitted by: 6/4/2025

Codell Construction Company
Colton Miller
1776 ADAMS LANE
HENDERSON, KY 42420
cmiller@codellconstruction.com