

OK AS TO FORM
AMH 12-10-2025



UTILITY EASEMENT

The undersigned, **JEFFERSON COUNTY SCHOOL DISTRICT FINANCE CORPORATION**, a Kentucky nonprofit corporation, of 3001 Crittenden Dr, Louisville, KY 40209-1119 ("Grantor"), for valuable consideration, receipt of which is hereby acknowledged (said consideration for this instrument is not measurable in money), does hereby grant and convey unto **LOUISVILLE GAS AND ELECTRIC COMPANY**, a Kentucky corporation, with a mailing address of 820 West Broadway Louisville, KY 40202, its successors and assigns ("Company"), for a period of five years and such time thereafter as any electric facilities or any extension thereof may be maintained over or under the lands hereafter described, the right, power, and privilege to construct, reconstruct, operate, repair, patrol, and maintain an electric line or lines, communications systems, and all equipment and facilities related thereto, on, over, and under upon Grantor's property located at **750 Dixie Hwy, Louisville, KY 40210 (Parcel ID: 036C01700000)** and in the area as further described below and shown on the plan attached hereto. The Company is further granted the right of ingress and egress over the lands of the Grantor to and from said facilities in the exercise of this easement, provided, however, that in exercising such right of ingress and egress the Company will, whenever practicable to do so, use regularly established roads or passageways. Grantor further grants and conveys to the Company the right to trim and remove any and all trees, shrubs, structures and obstacles located on said easement for proper clearance of said lines or equipment.

An underground electric easement fifteen (15') feet in width, as constructed and shown in Louisville Gas & Electric Drawing WR#7719622 attached hereto.

The Grantor, their successors, heirs or assigns, may use and enjoy the lands crossed by this easement, except, however, that such use shall not conflict with any of the rights and privileges herein granted. In particular, but by no way of limitation, Grantor shall not conduct any activities that restrict Company's access to its facilities or result in violations of applicable laws and regulations, such as structures or swimming pools that violate clearance requirements to electrical facilities.

Title to the property was acquired by the Grantor by Deed dated 14th of May 2025 and recorded in Deed Book 13071 Page 656 in the County Clerk's Office of Jefferson County, Kentucky which reference is hereby specifically made for the description therein contained.

It is further agreed that the Company, at its option will repair and restore the property to substantially the same condition that the property was in prior to installation, maintenance, or repair of the electric facilities, or pay to the Grantors, for damages that may be caused by it in the exercise of this easement, except that the Company will not be liable for any damage for trimming, removing, or otherwise controlling trees or vegetation as permitted by this easement.

IN WITNESS WHEREOF, witness the signature of the Grantors this 16th day of December, 2025.

JEFFERSON COUNTY SCHOOL DISTRICT FINANCE CORPORATION




Signature

COMMONWEALTH/STATE OF Kentucky)
COUNTY OF Jefferson)

I, Angie Gilpin (Notary), a Notary Public in and for the State and County
aforesaid hereby certify that Dr. Brian Yearwood (Name), personally known to me to be the
Superintendent (Title) of Jefferson County Public Schools, (Organization)
appeared before me this day in person in the State and County aforesaid and acknowledged the execution and
delivery of the foregoing instrument to be the free act and deed of Jefferson County Public Schools
and their free act and deed as such Superintendent (Title) thereof.

My commission expires November 9, 2026.

WITNESS my hand this 16th day of December, 2025.

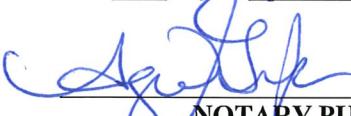


NOTARY PUBLIC
NOTARY ID NUMBER FYNPL1808

Prepared by:

Work Request # 7719622

Joe Mandlehr, Corporate Attorney
PPL Services Corporation
220 West Main Street, Louisville, KY 40202

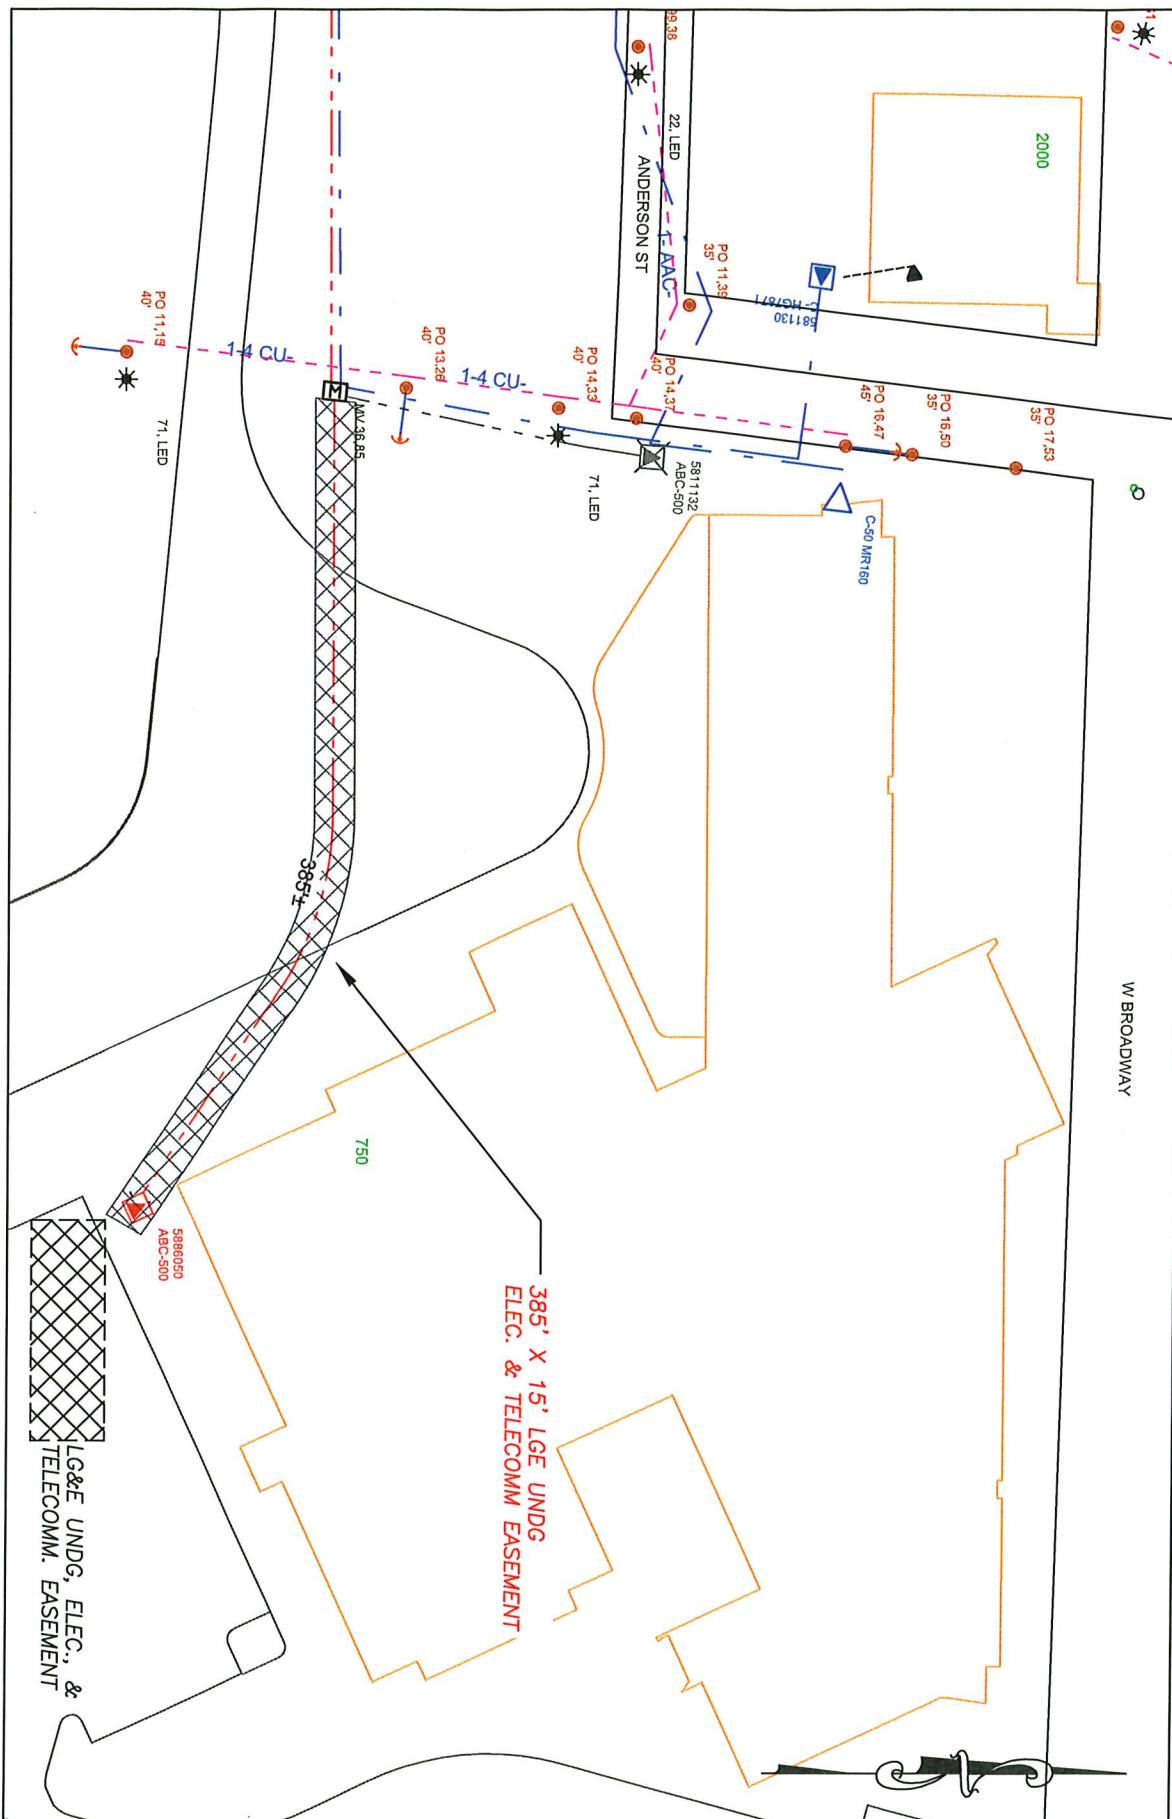

WR#: 7719622	JCPS BLAINE HUDSON 750 DIXIE HWY	EASEMENT DRAWING		 Louisville Gas and Electric Company <i>a PPL Company</i> POWER DELIVERY ENGINEERING
PROJECT#: ANBCD343U		DRAWN BY: ARNOLD, JEFF		
TASK#: 7719622I01		PHONE #:	502-364-8380	DATE: 8/12/2025
SHEET 1 OF 1		SCALE:	NTS	